

M.V. TEESWOOD.

SHIP No. 359.

PROFILE & DECKS.

SCALE: 1/8" = 1 FOOT.

TO LLOYD'S SURVEY CLASS + 100 A.I.

DIMENSIONS - LENGTH L.W.L. 214'-6"; BREADTH MLD 35'-4"


DEPTH MLD. U. DECK 16'-0"; R.Q. DECK 20'-6"

HIGH R.Q. DECK 23'-0"; L. DECK 13'-0"

SUMMER MLD. DRAUGHT 15'-6 1/2"
MLD. Δ AT 65% MLD DEPTH 2045 TONS

NOTES - MASTS, WINCHES, WINDLASS, STEERING GEAR & DECKHOUSES SUPPORTED TO SURVEYOR'S SATISFACTION. SEE SEPARATE PLANS FOR WTBHDS, OIL FUEL BUNKER, MOTOR SEATING, MOTOR ROOM FLATS, STERNFRAME SHELL & AFTER DECKHOUSE.

As Fitted

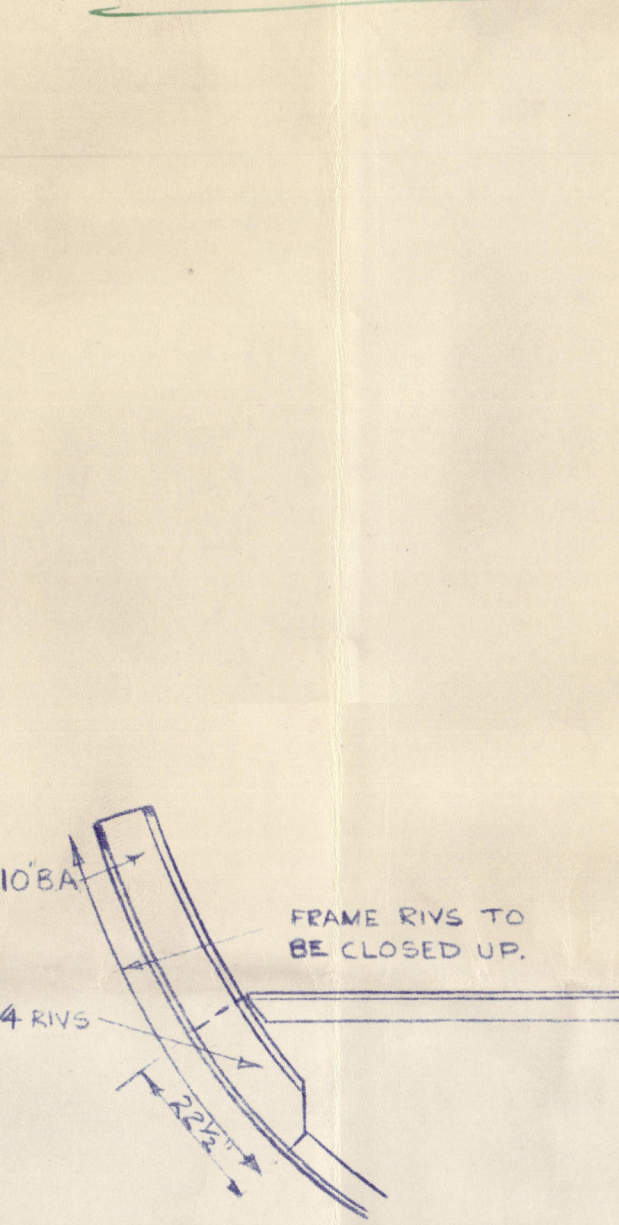


DETAIL OF FRAME SCARPHS. FRAMES 6-8 & 11-13.





Table with 2 columns: SHEERS and dimensions. Rows include A.P., 1/6 L FROM A.P., 2/6 L, AMIDSHIPS, 2/6 L FROM F.P., 1/6 L, and F.P.

Table with 2 columns: EQUIPMENT No. and dimensions. Rows include EQUIPMENT No. 1, 2, 3, 100.





EQUIPMENT LETTER "N" 1/6 CABLES

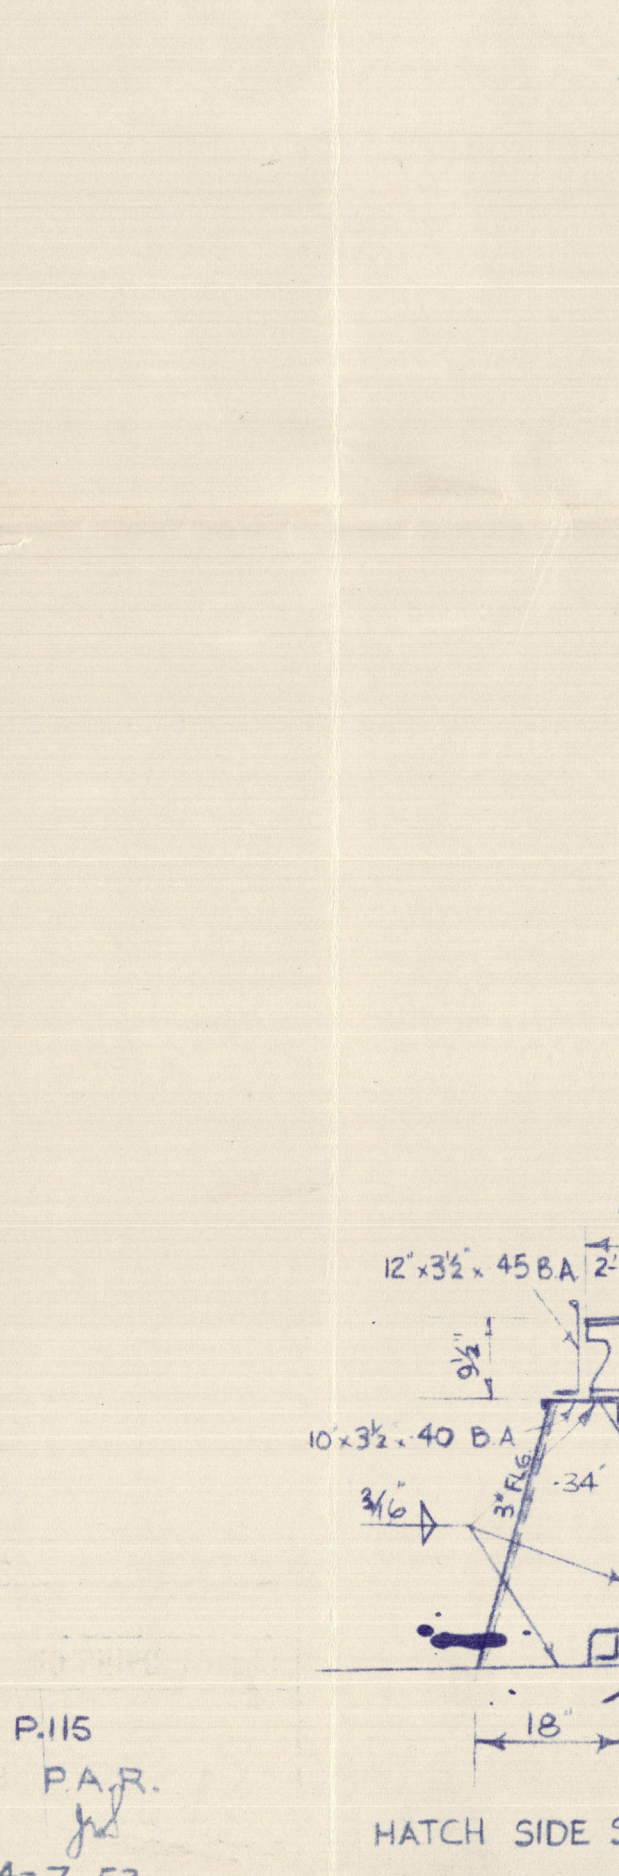




HATCH SIDE STAY

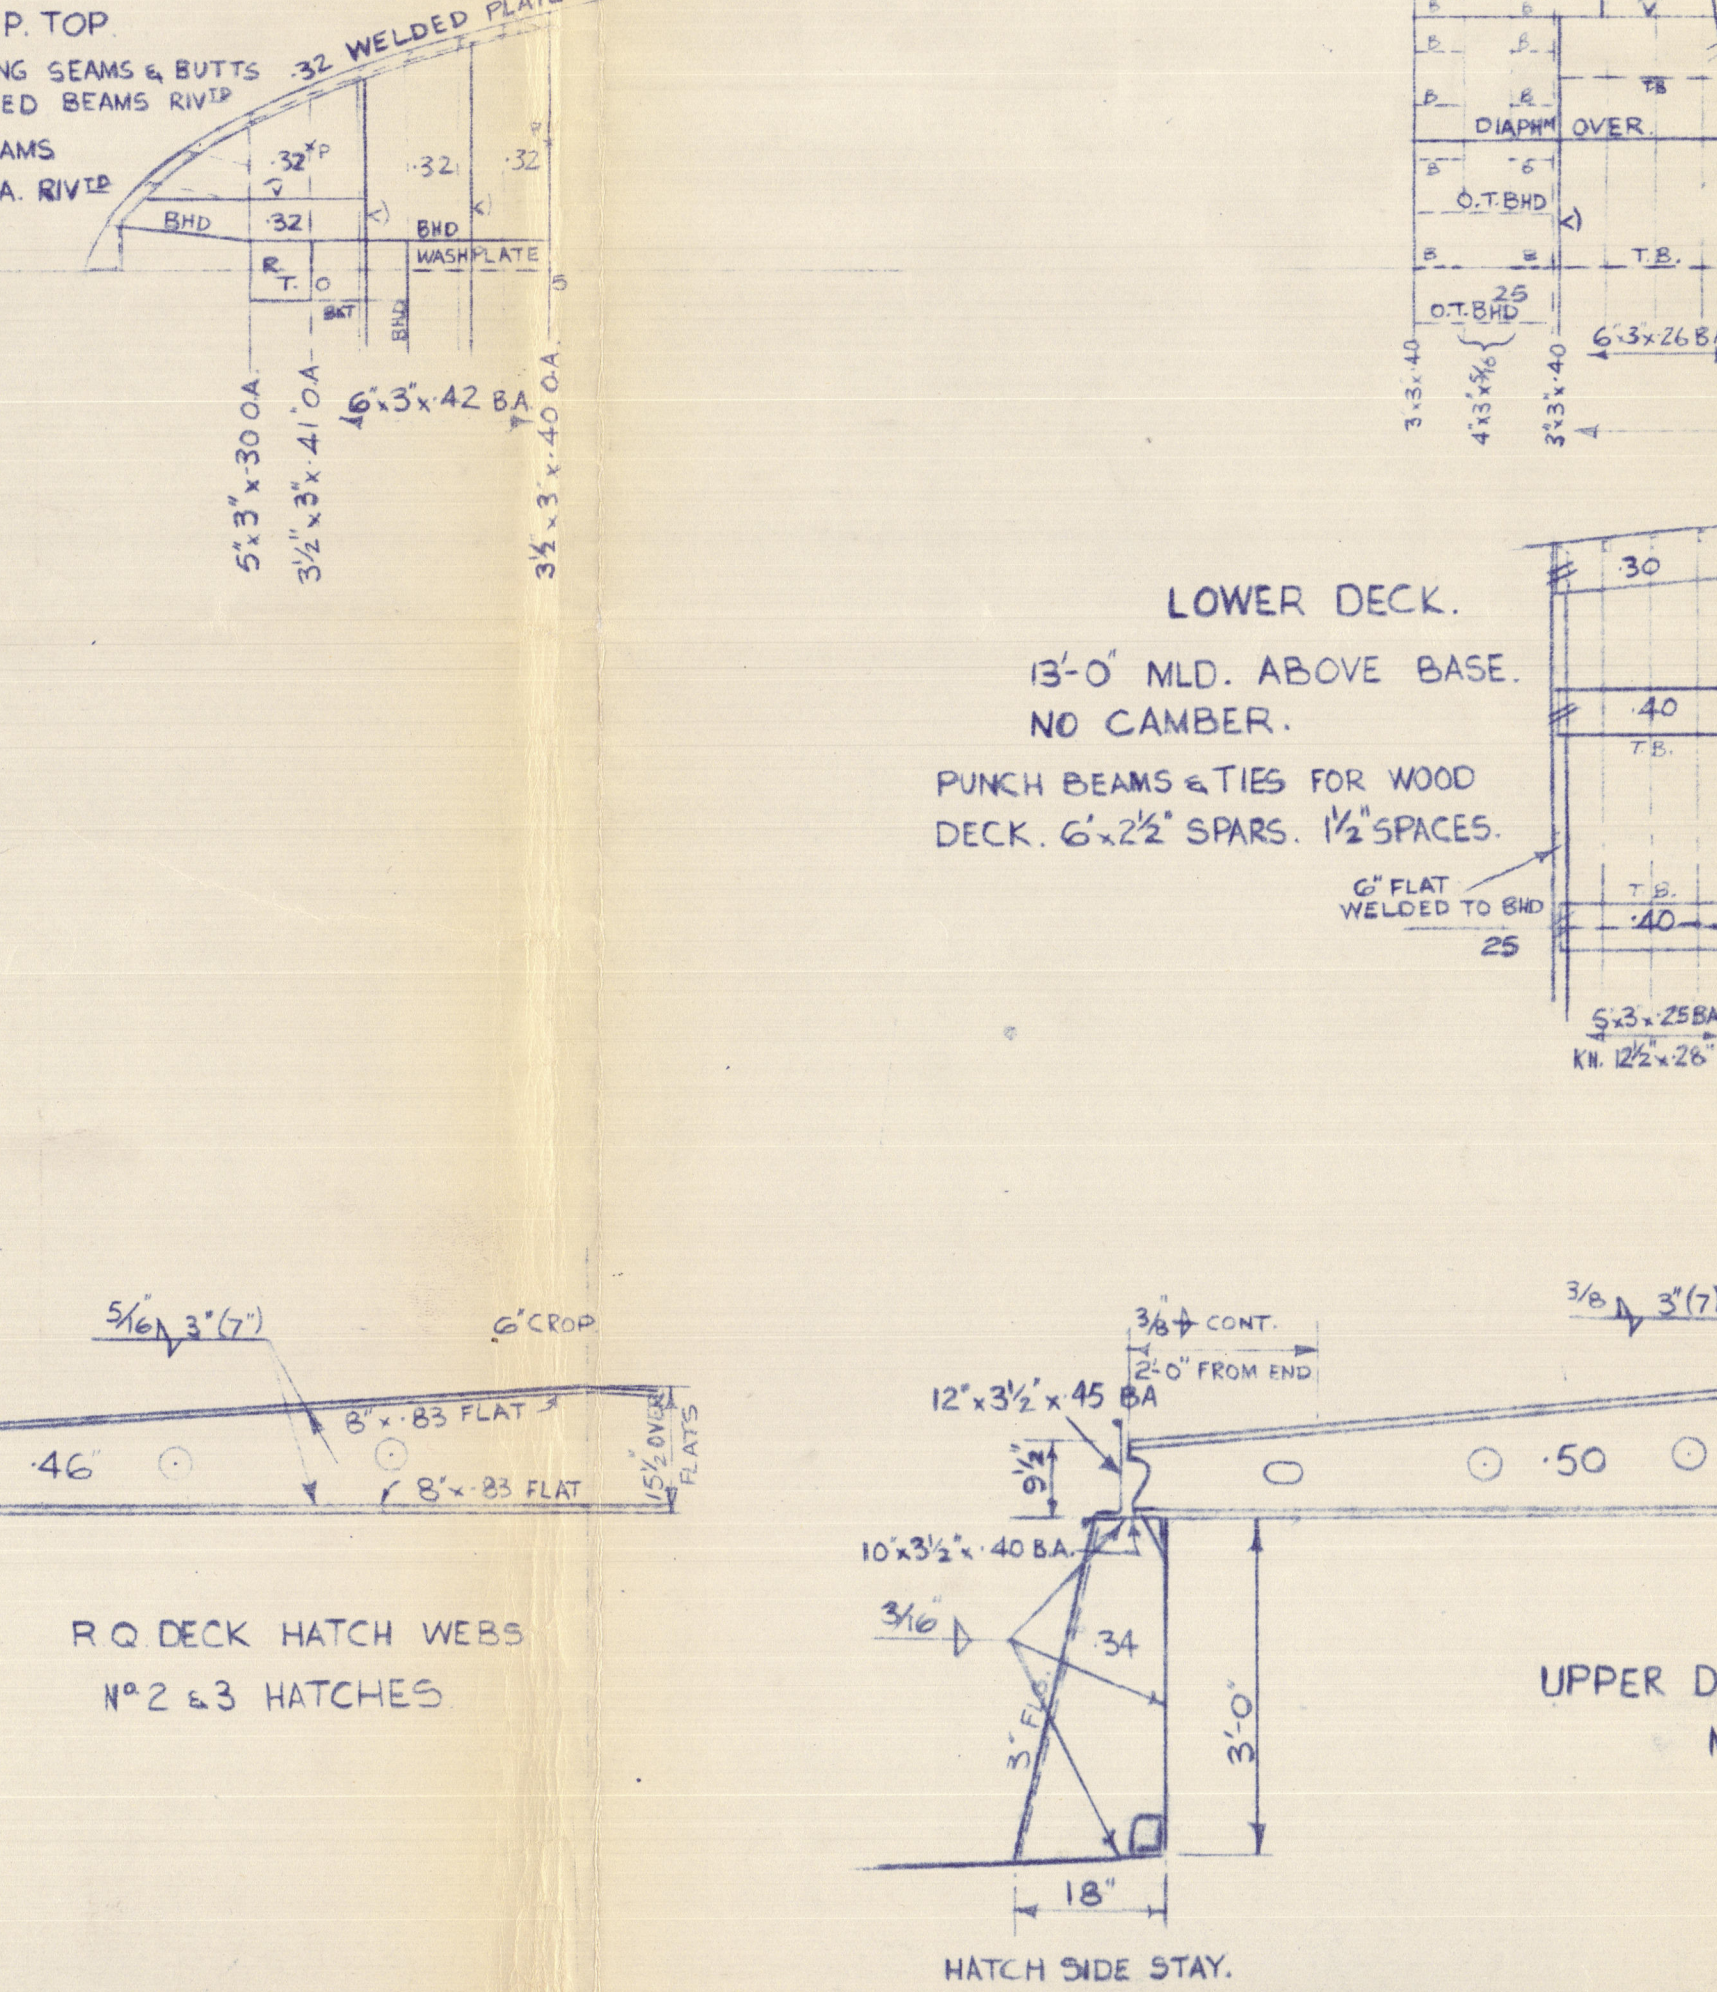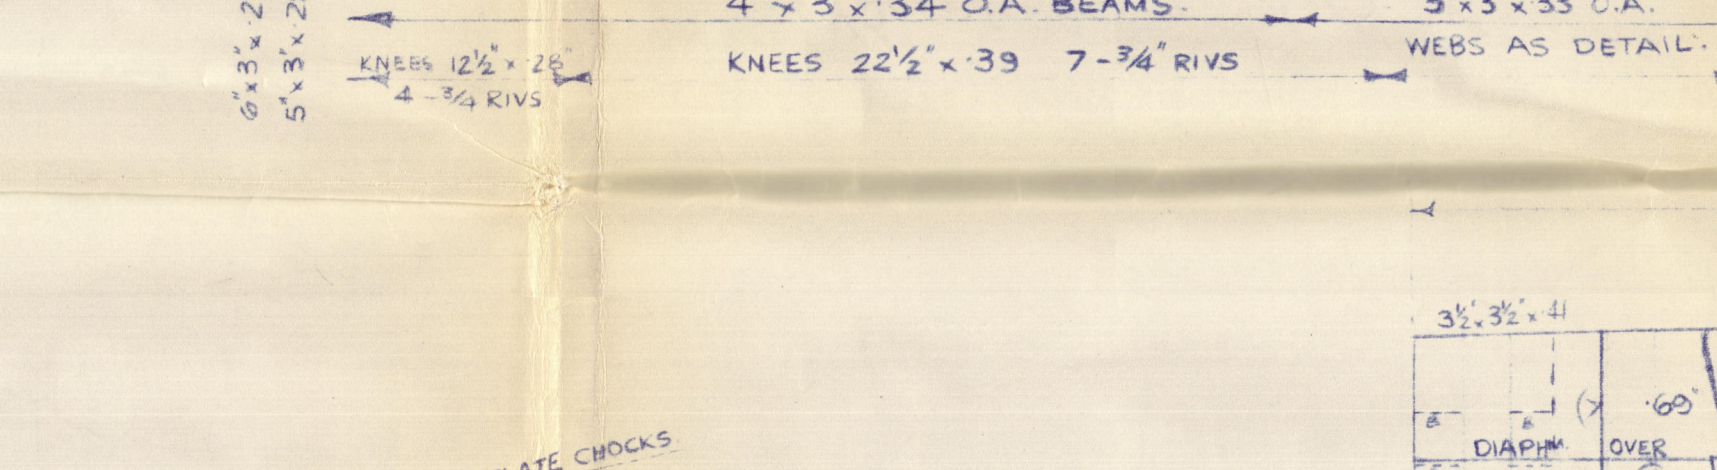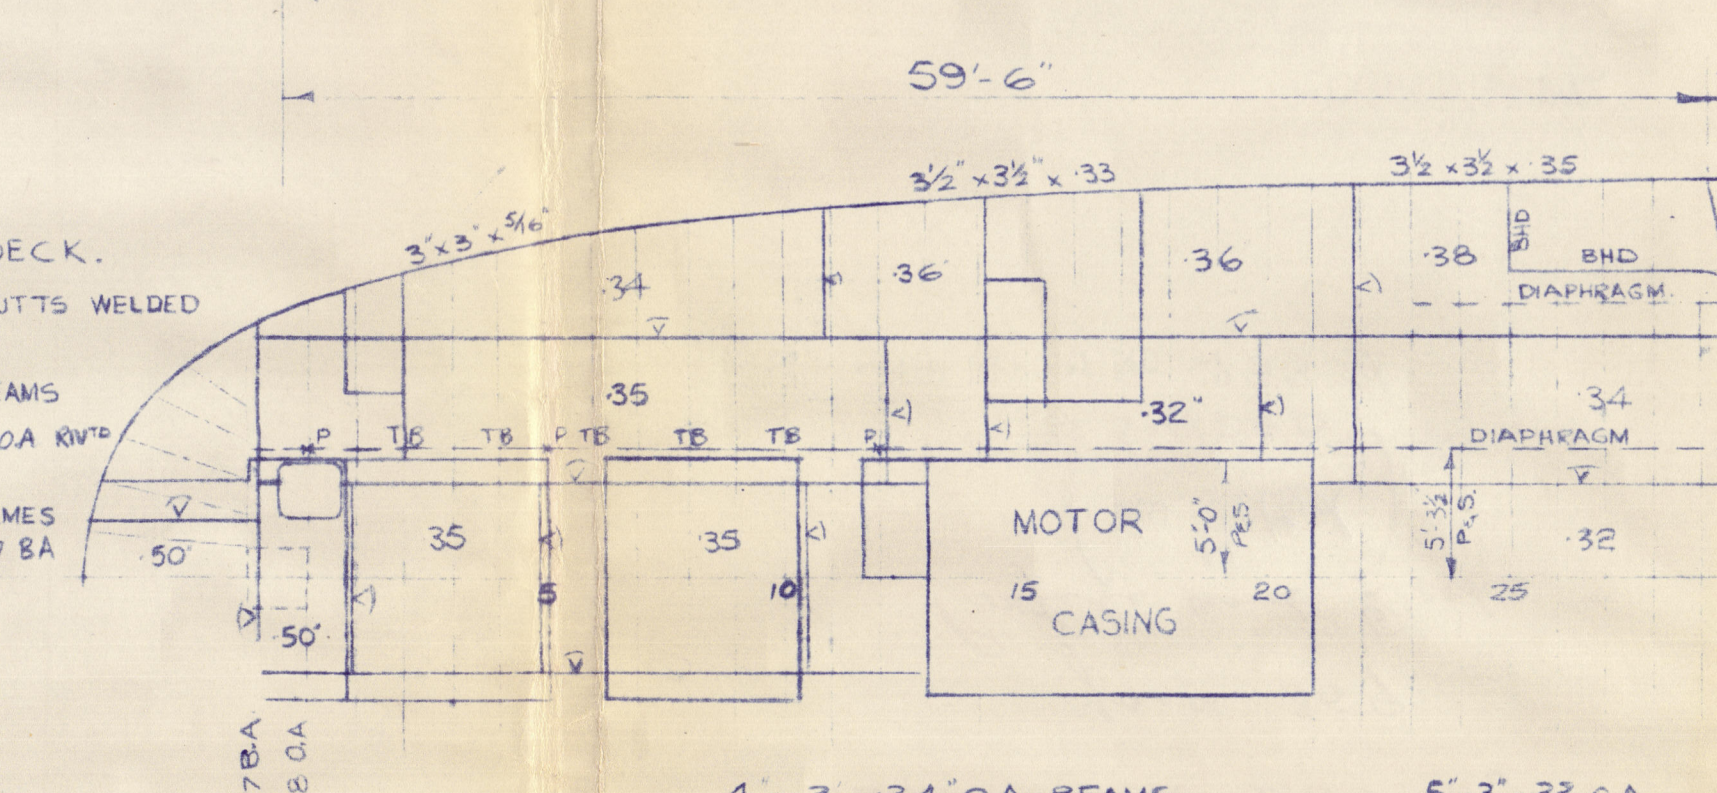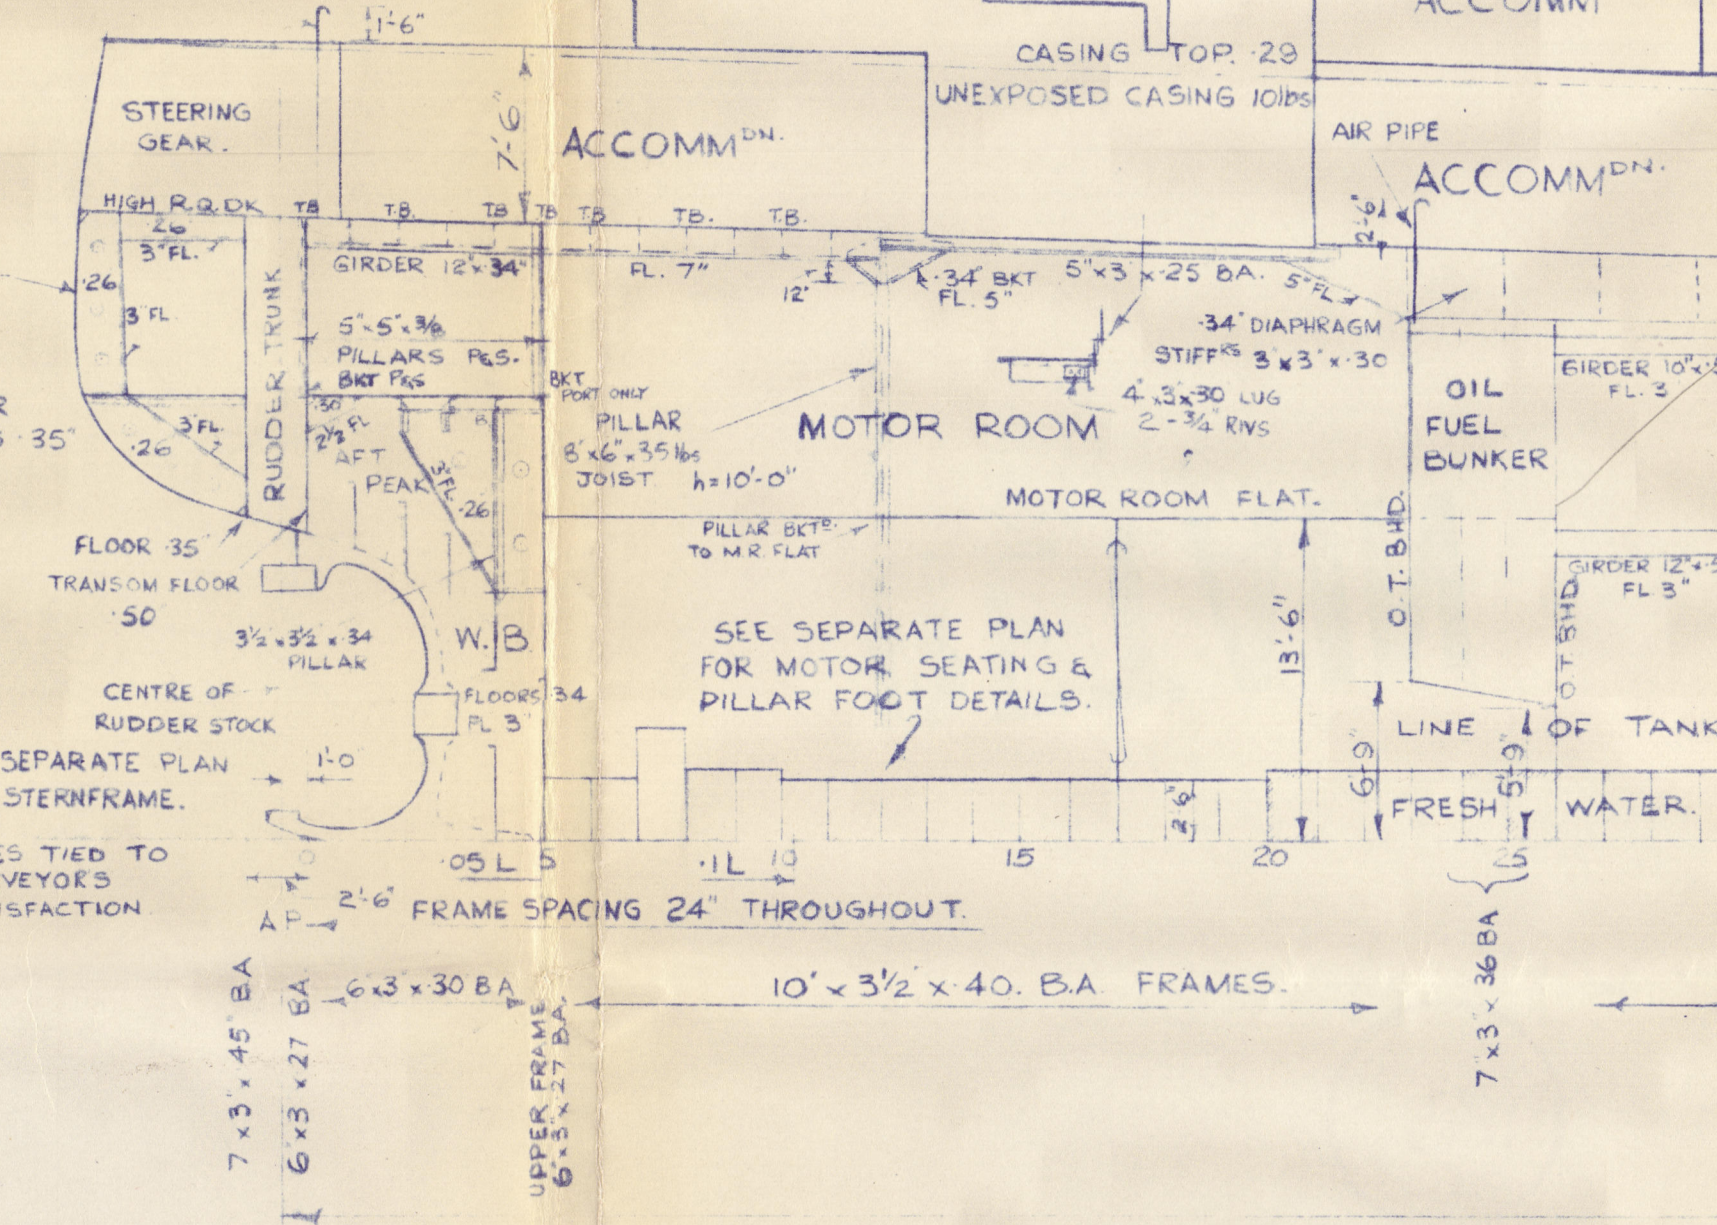





UPPER DECK HATCH WEBS. No 1 HATCH.

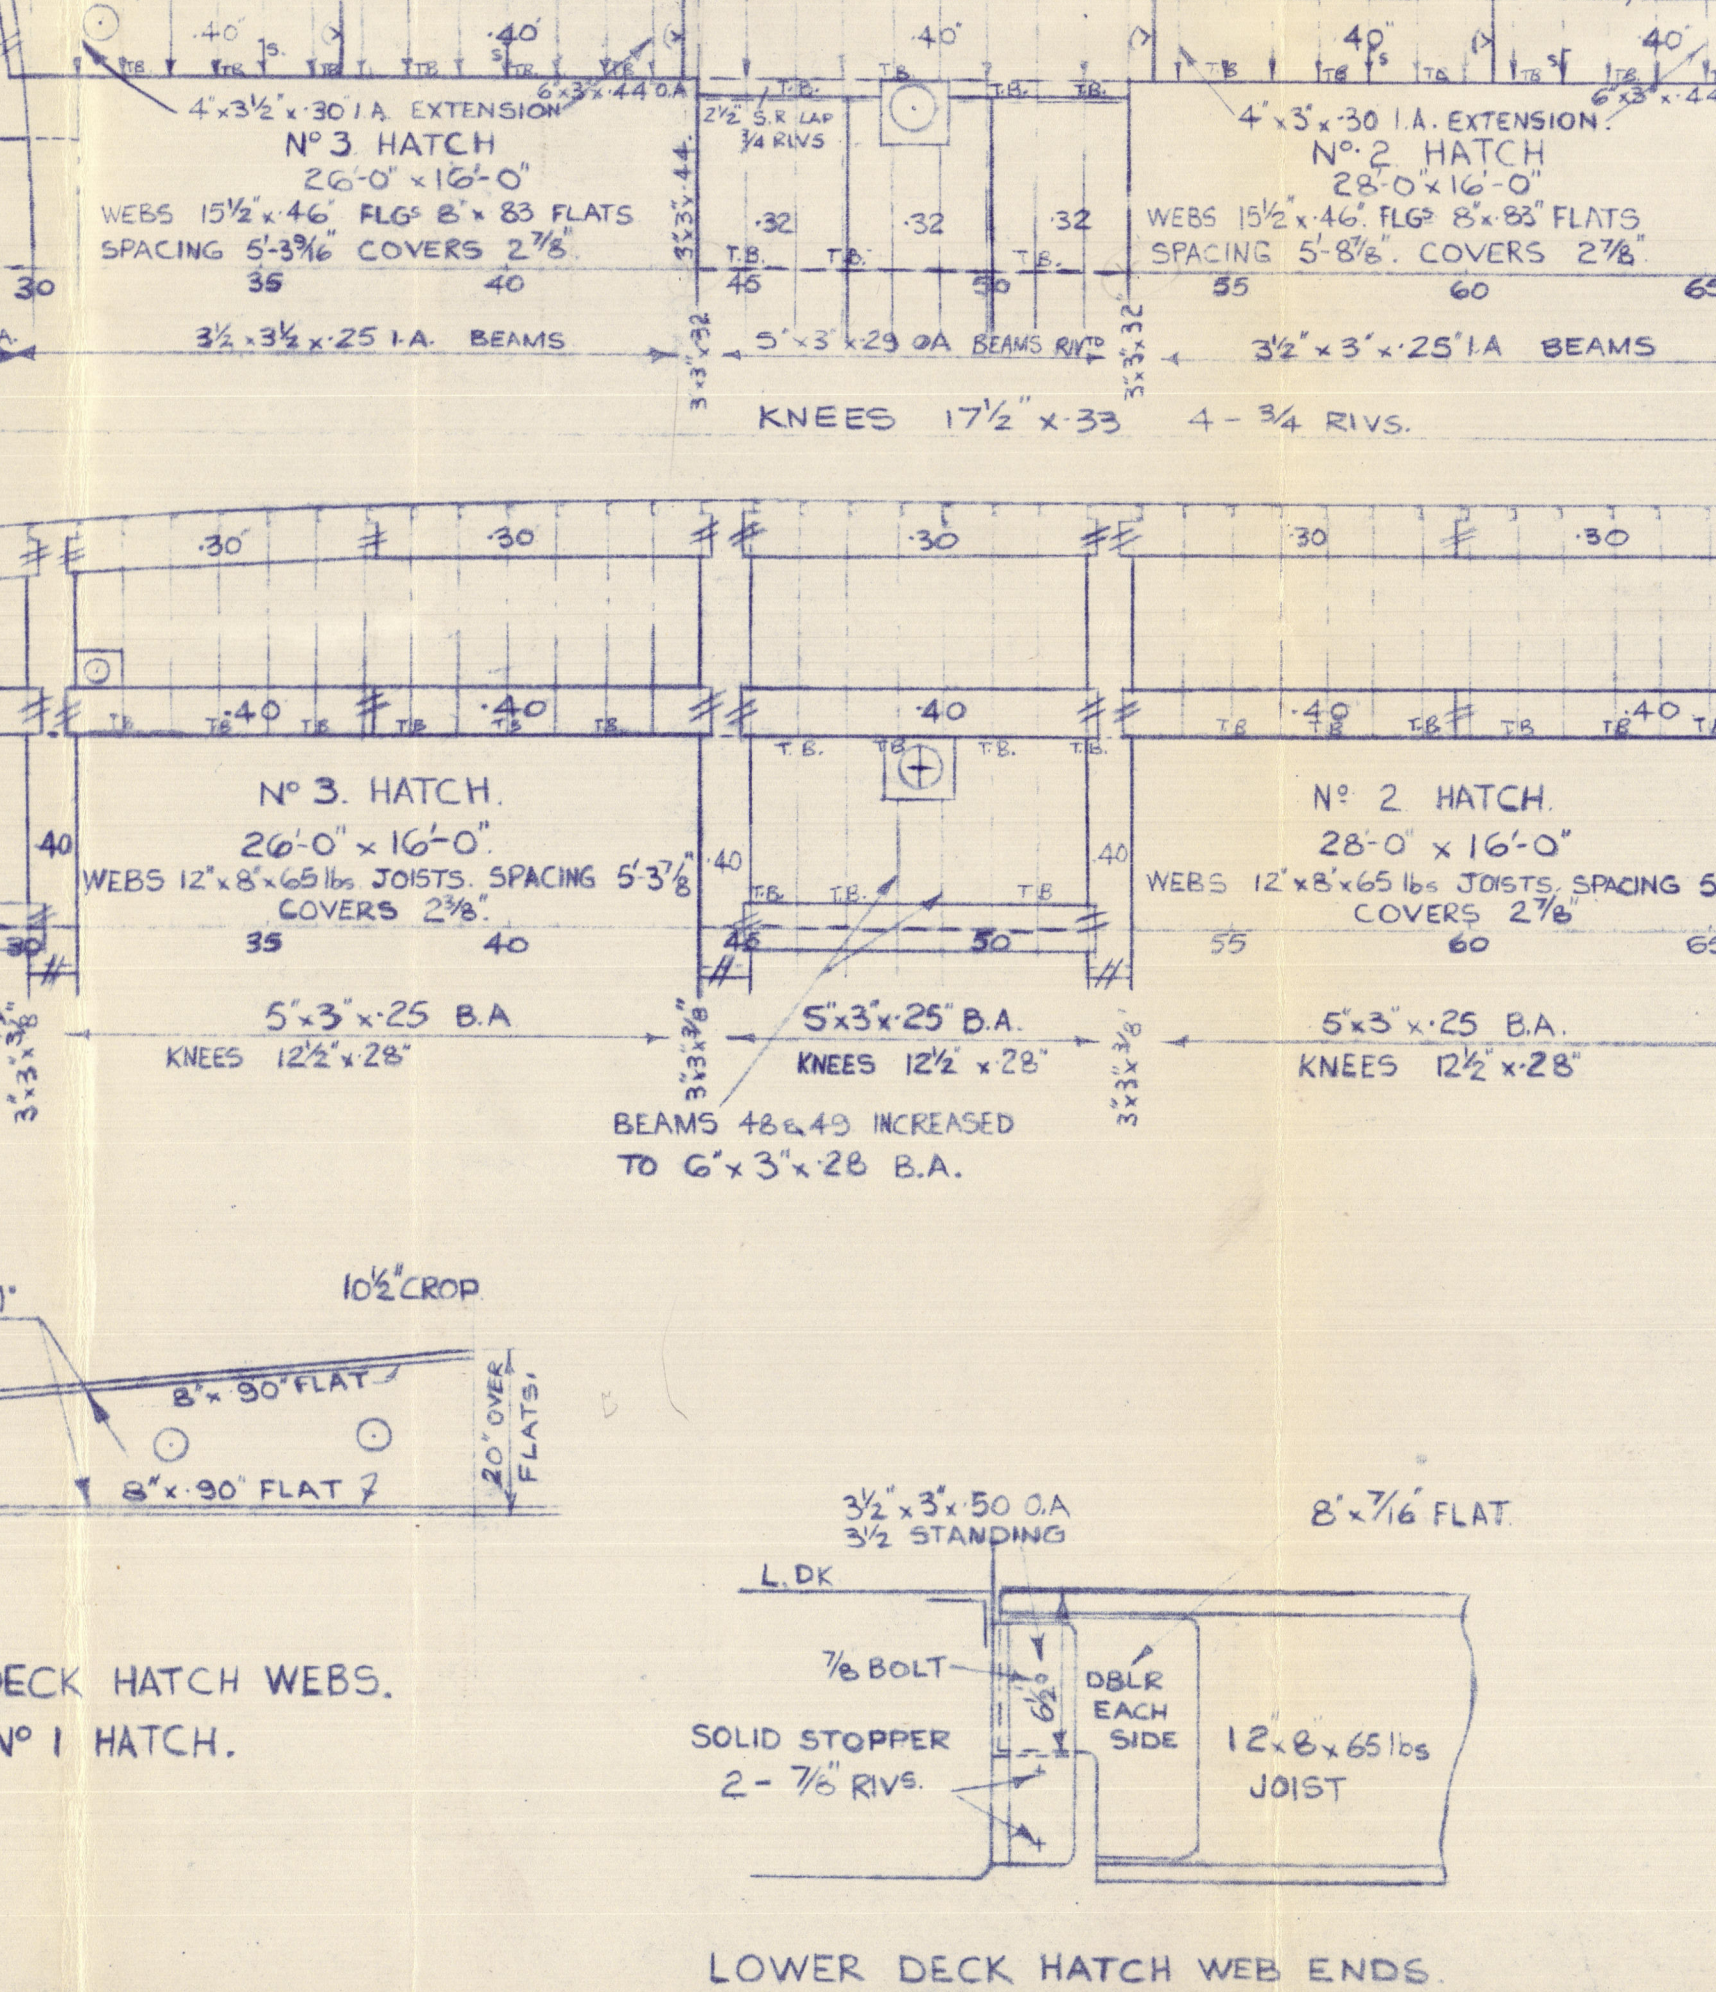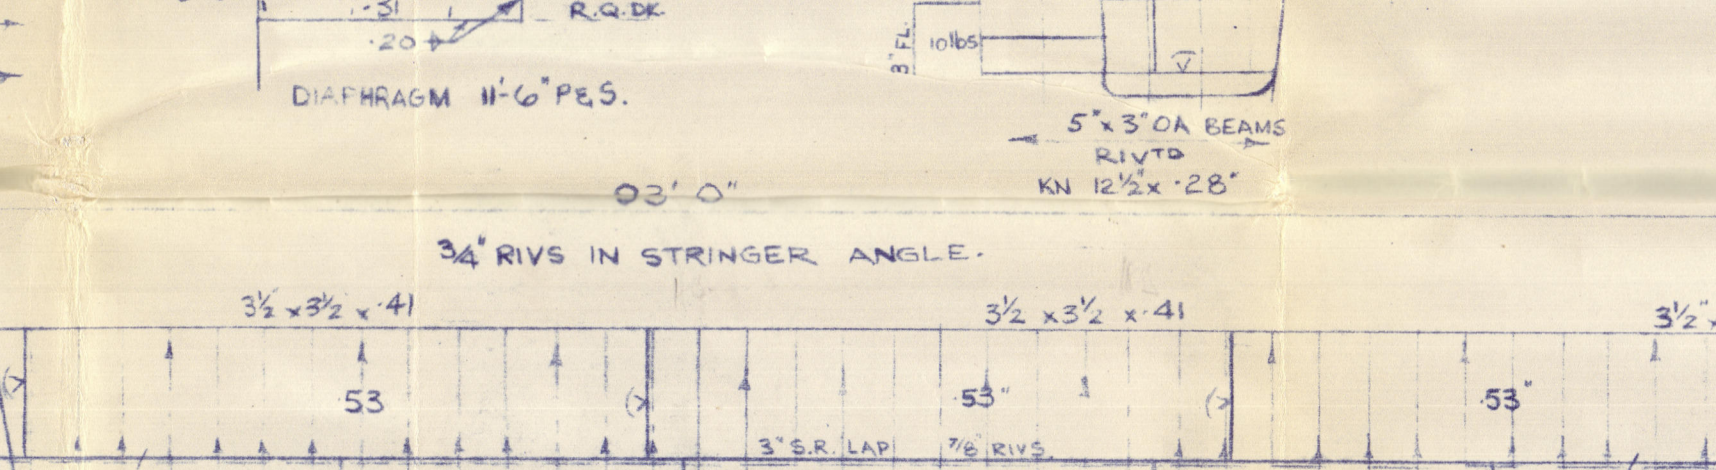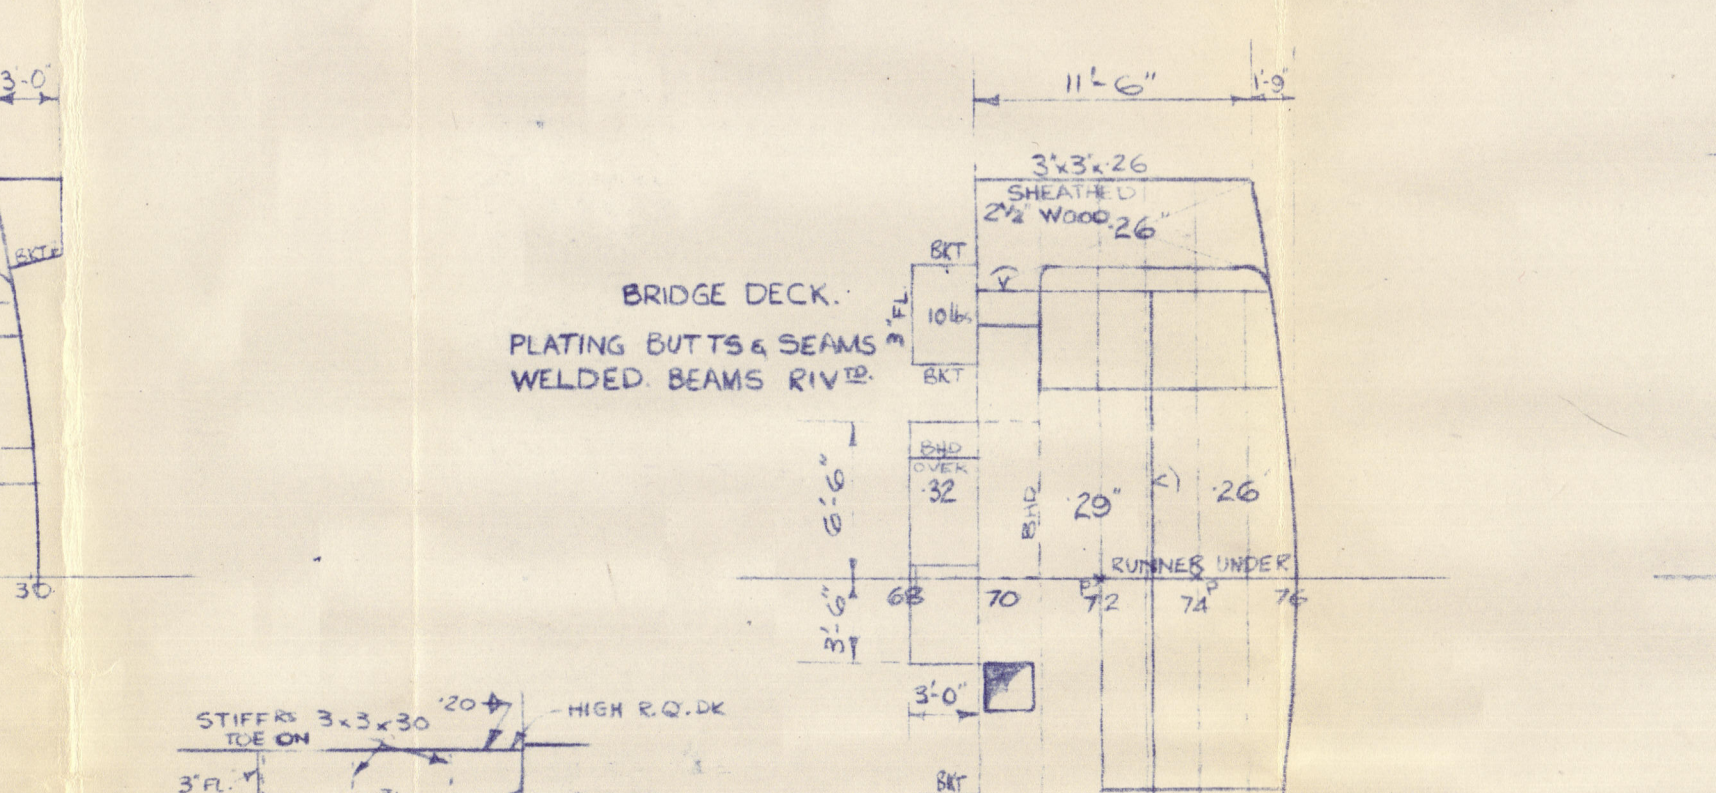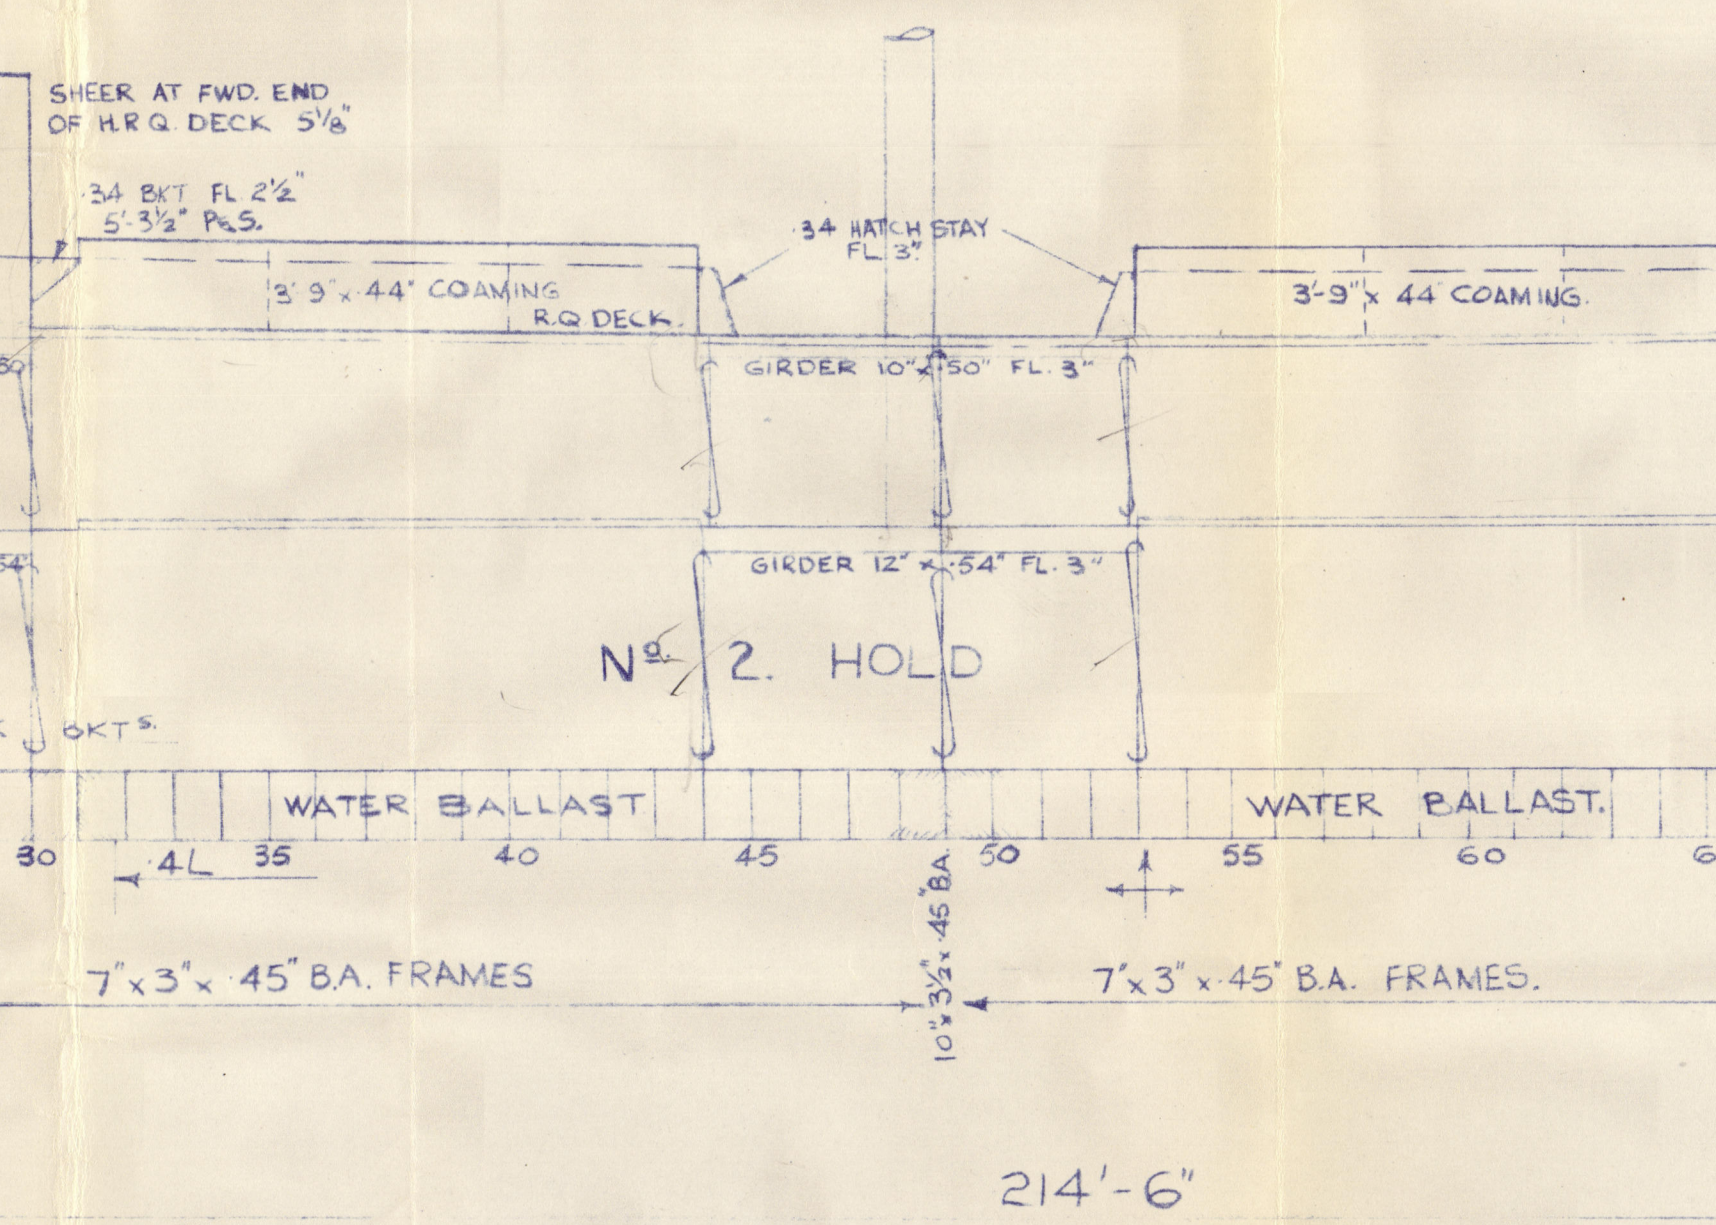




LOWER DECK HATCH WEB ENDS

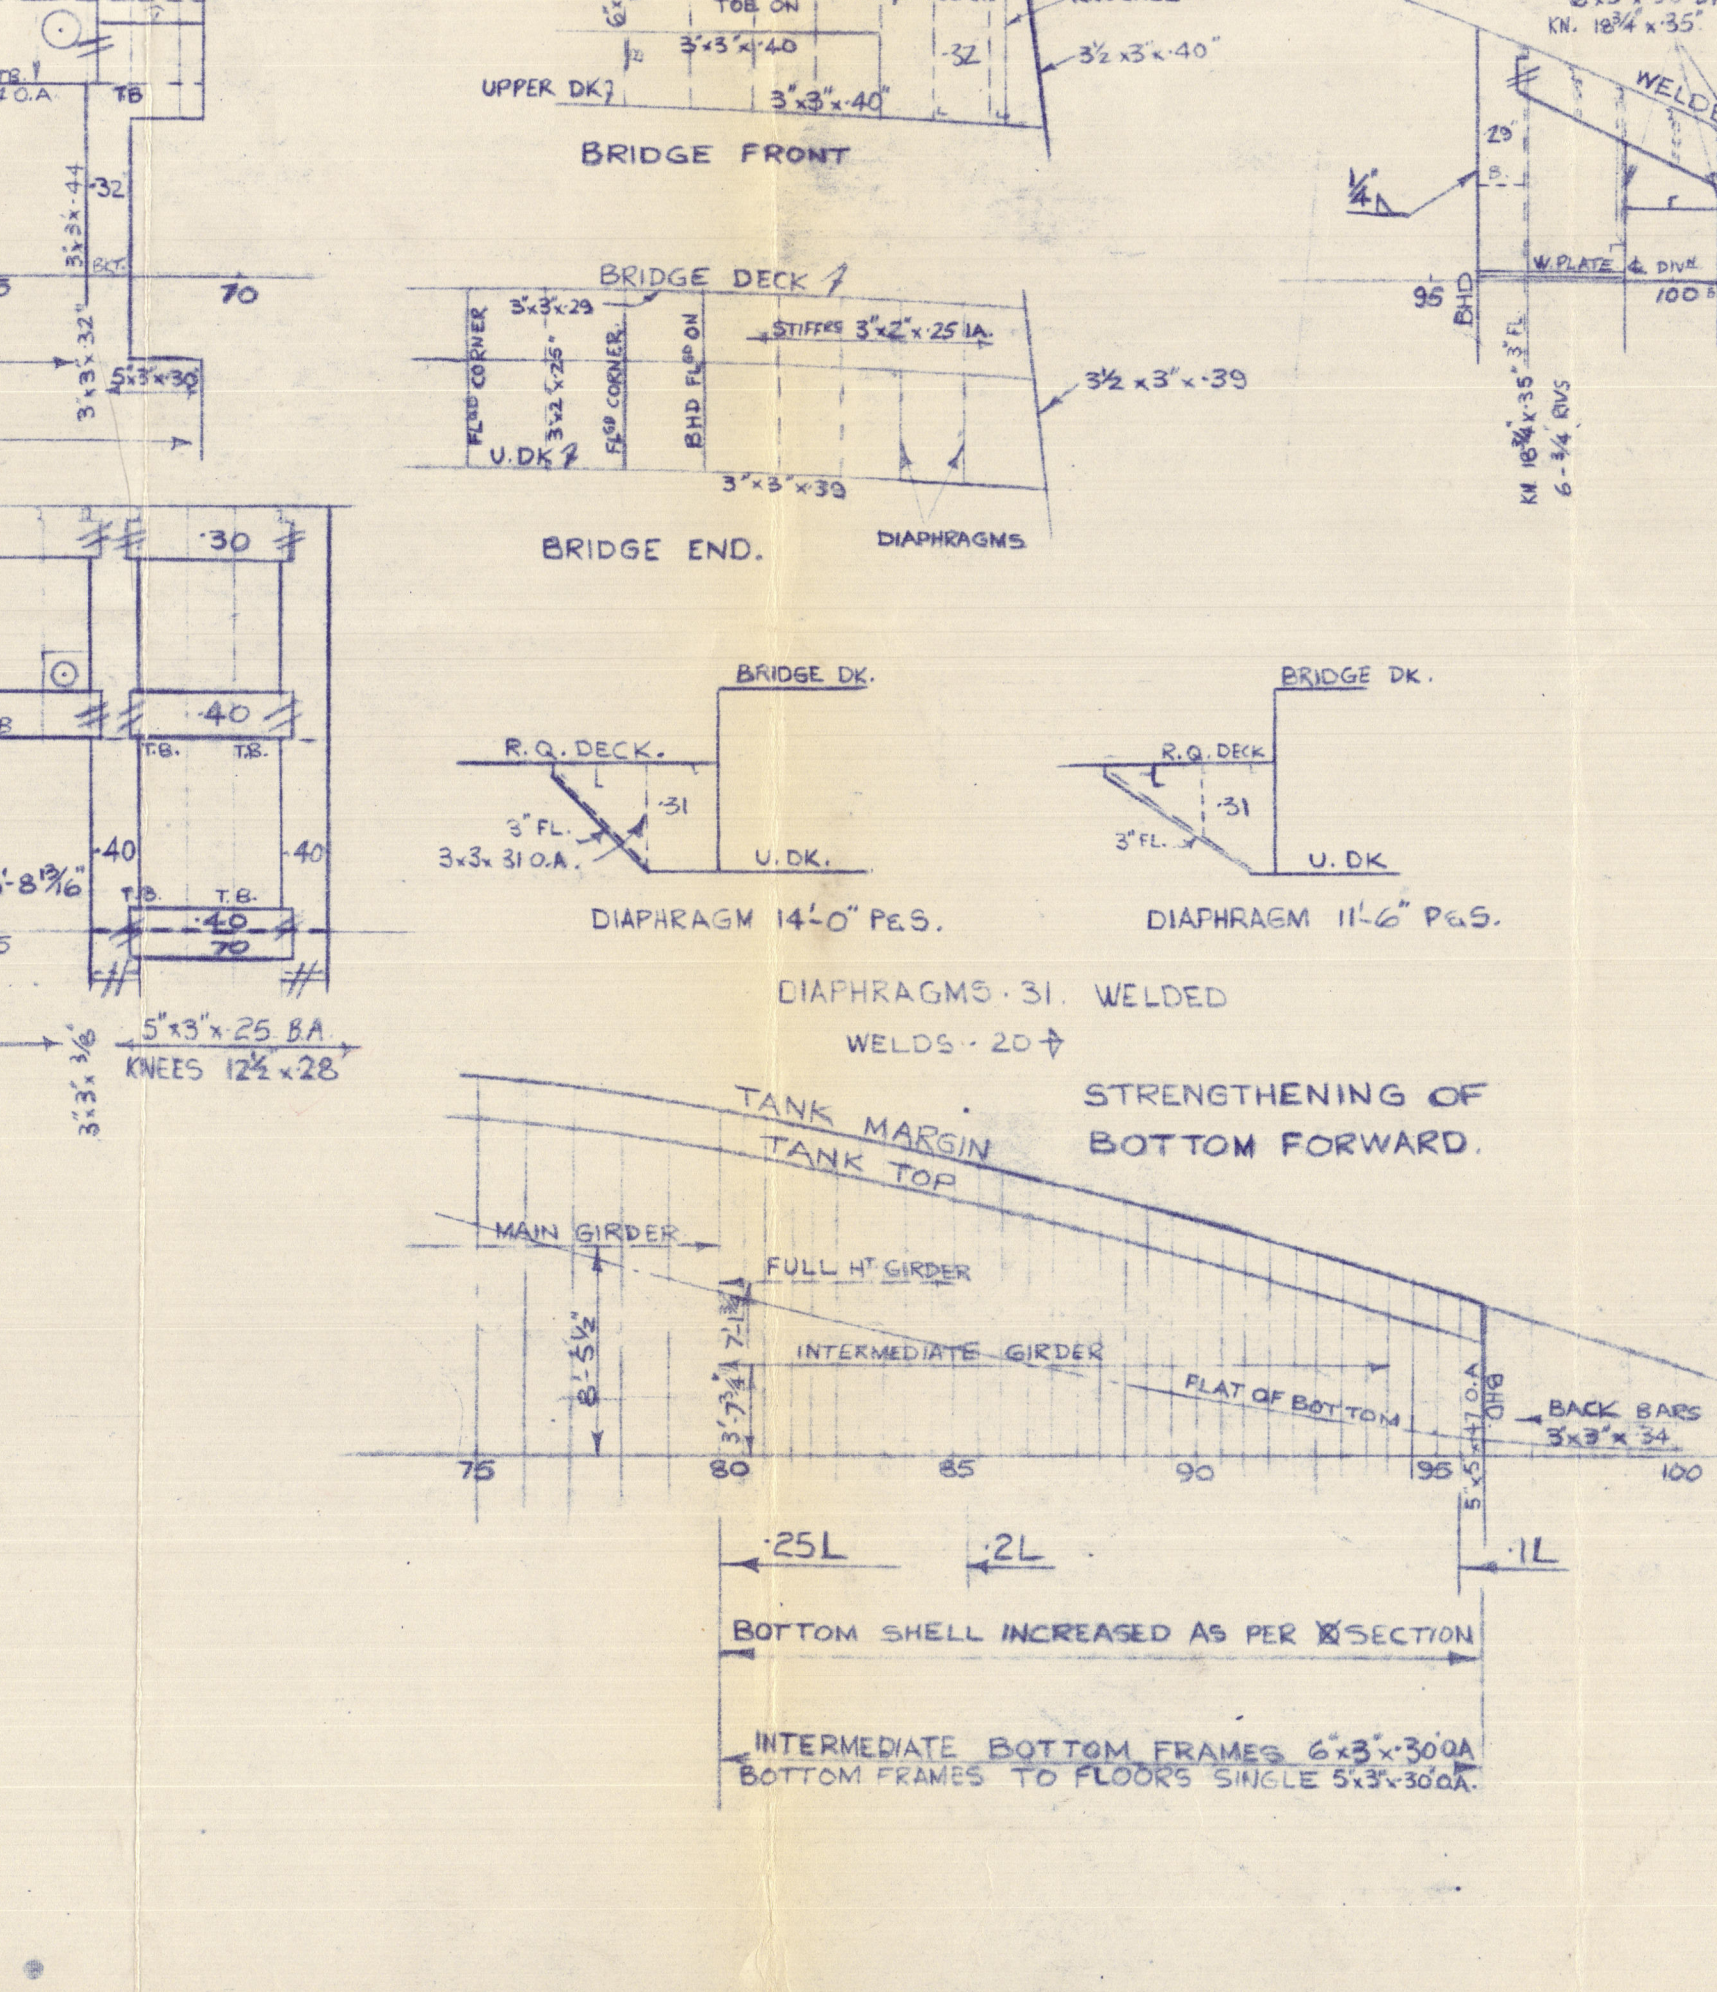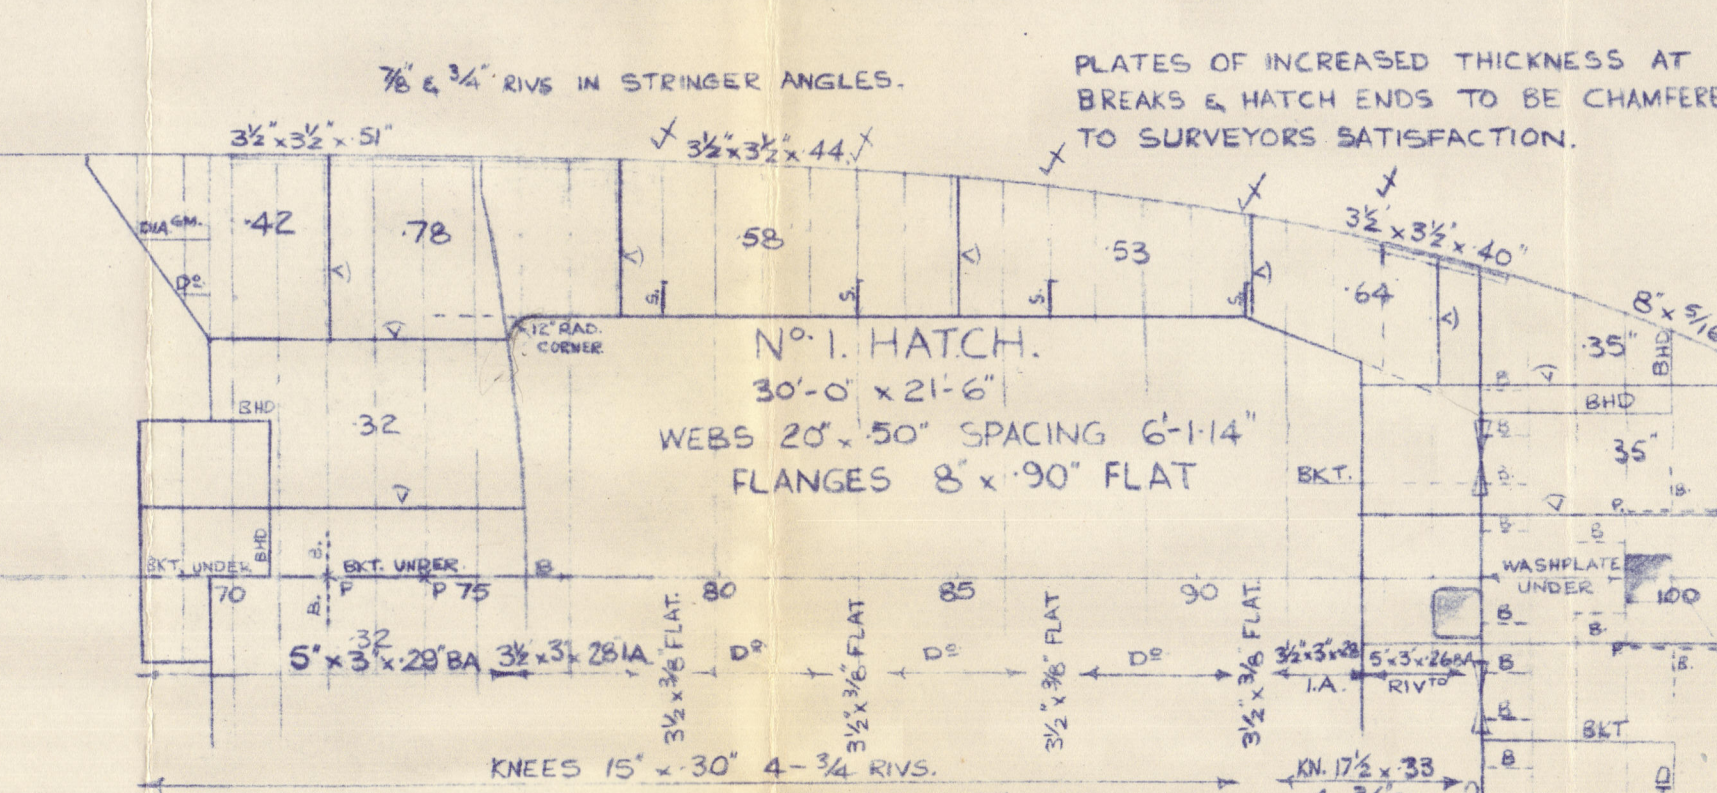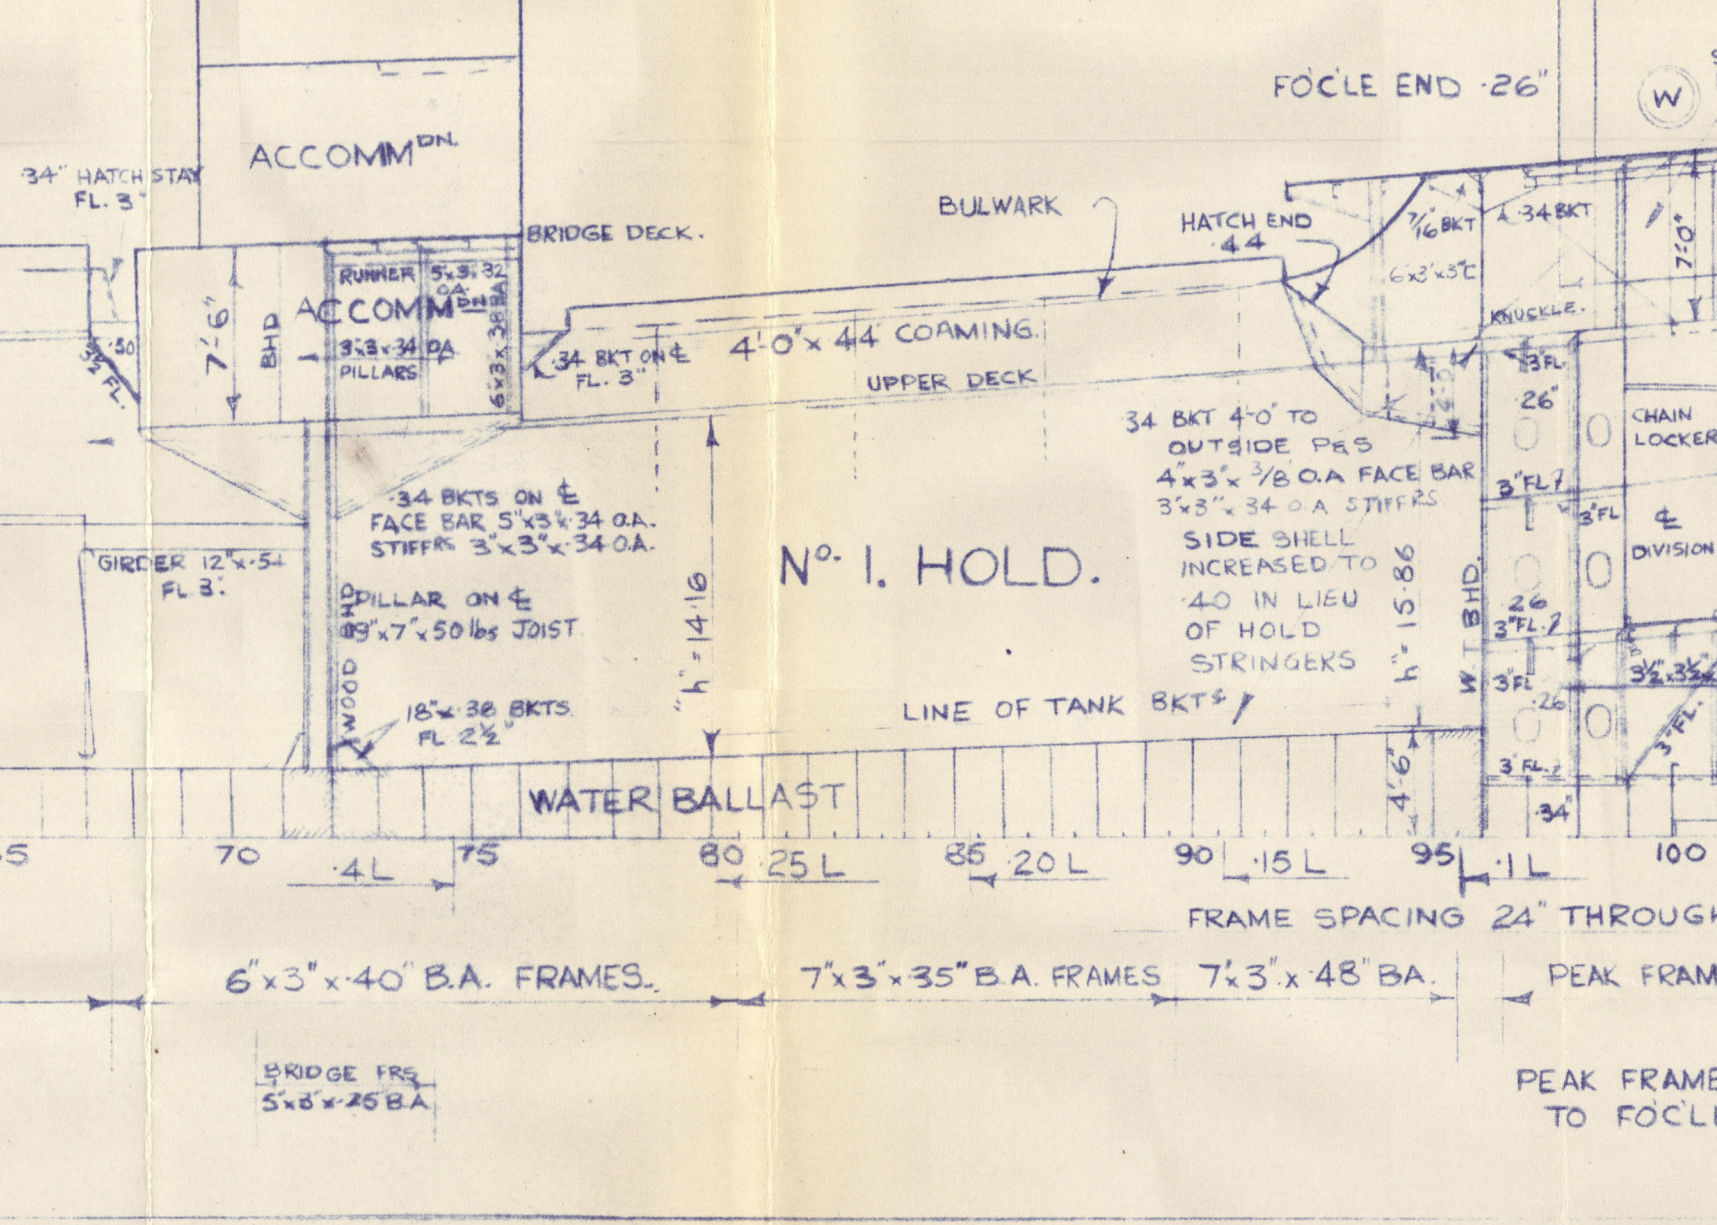

LOWER DECK HATCH WEB ENDS

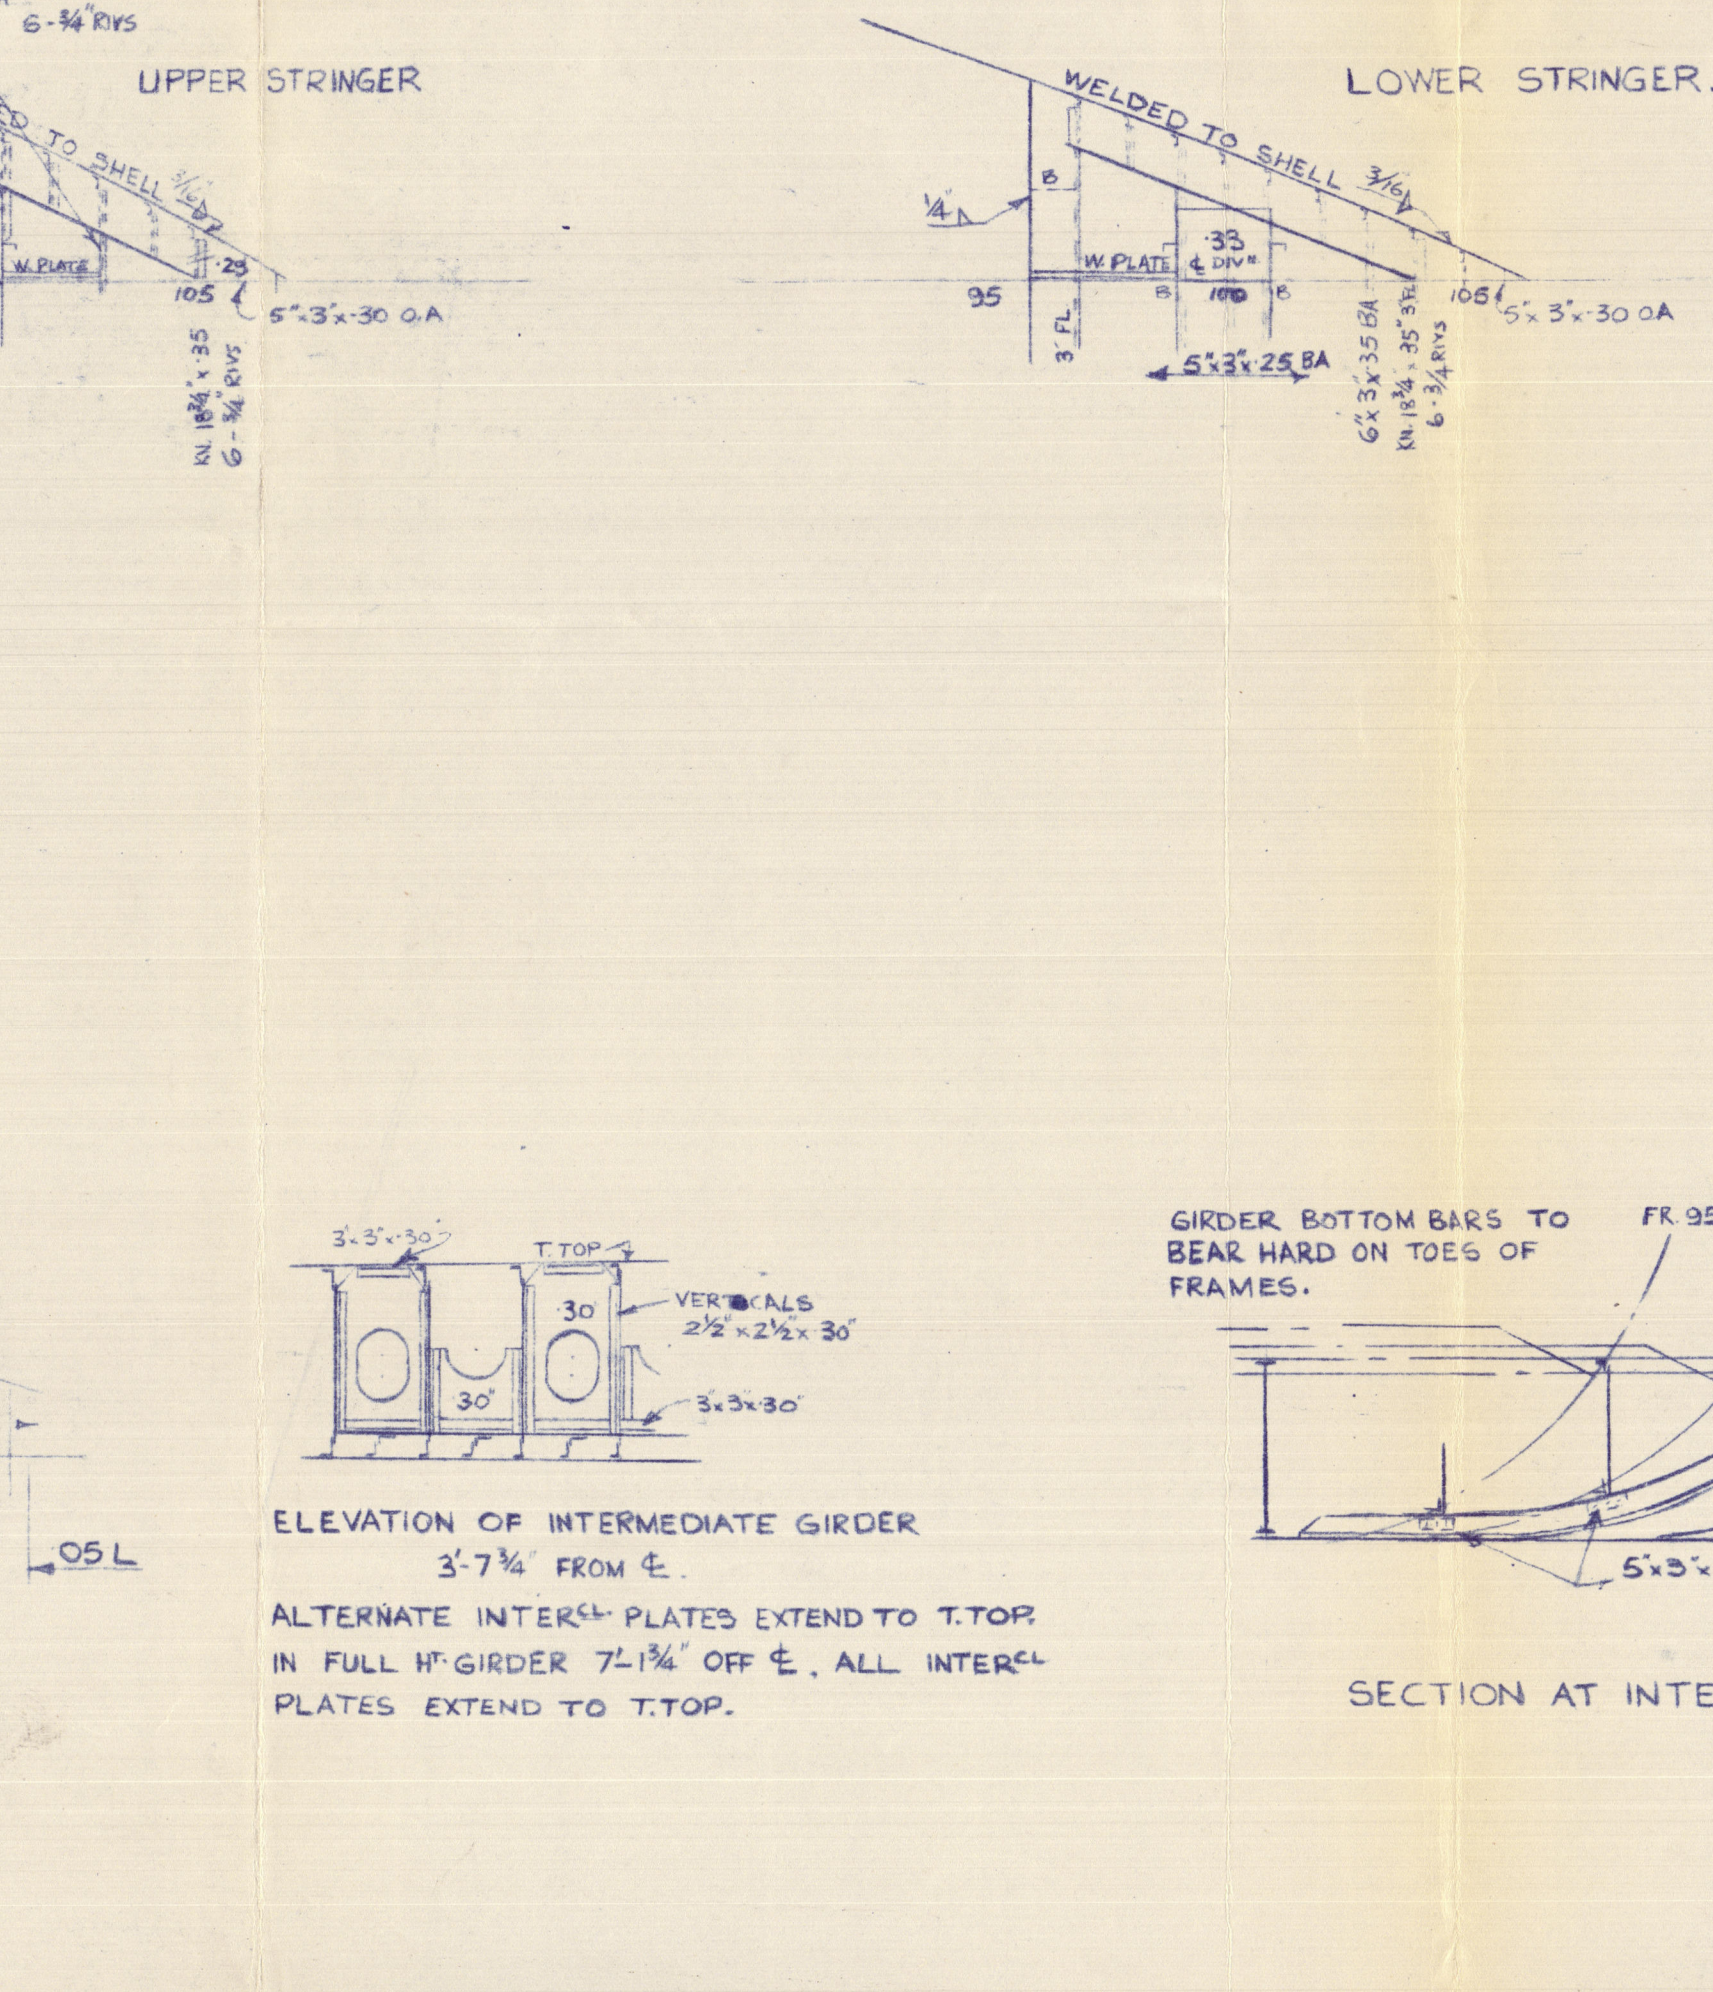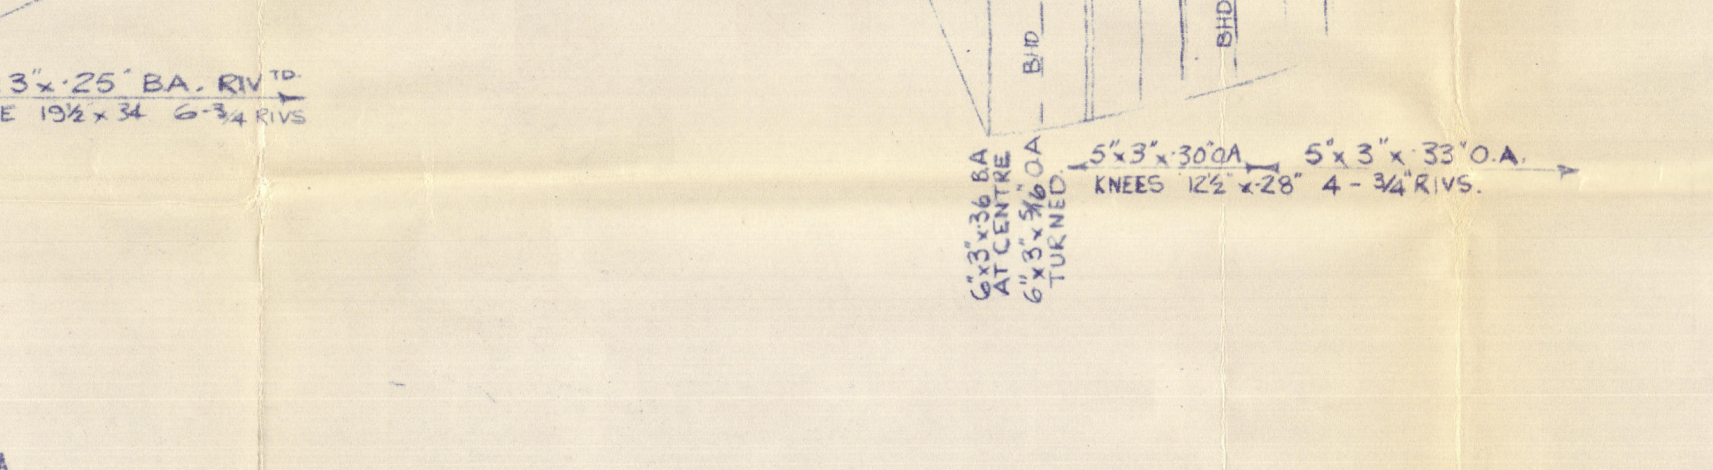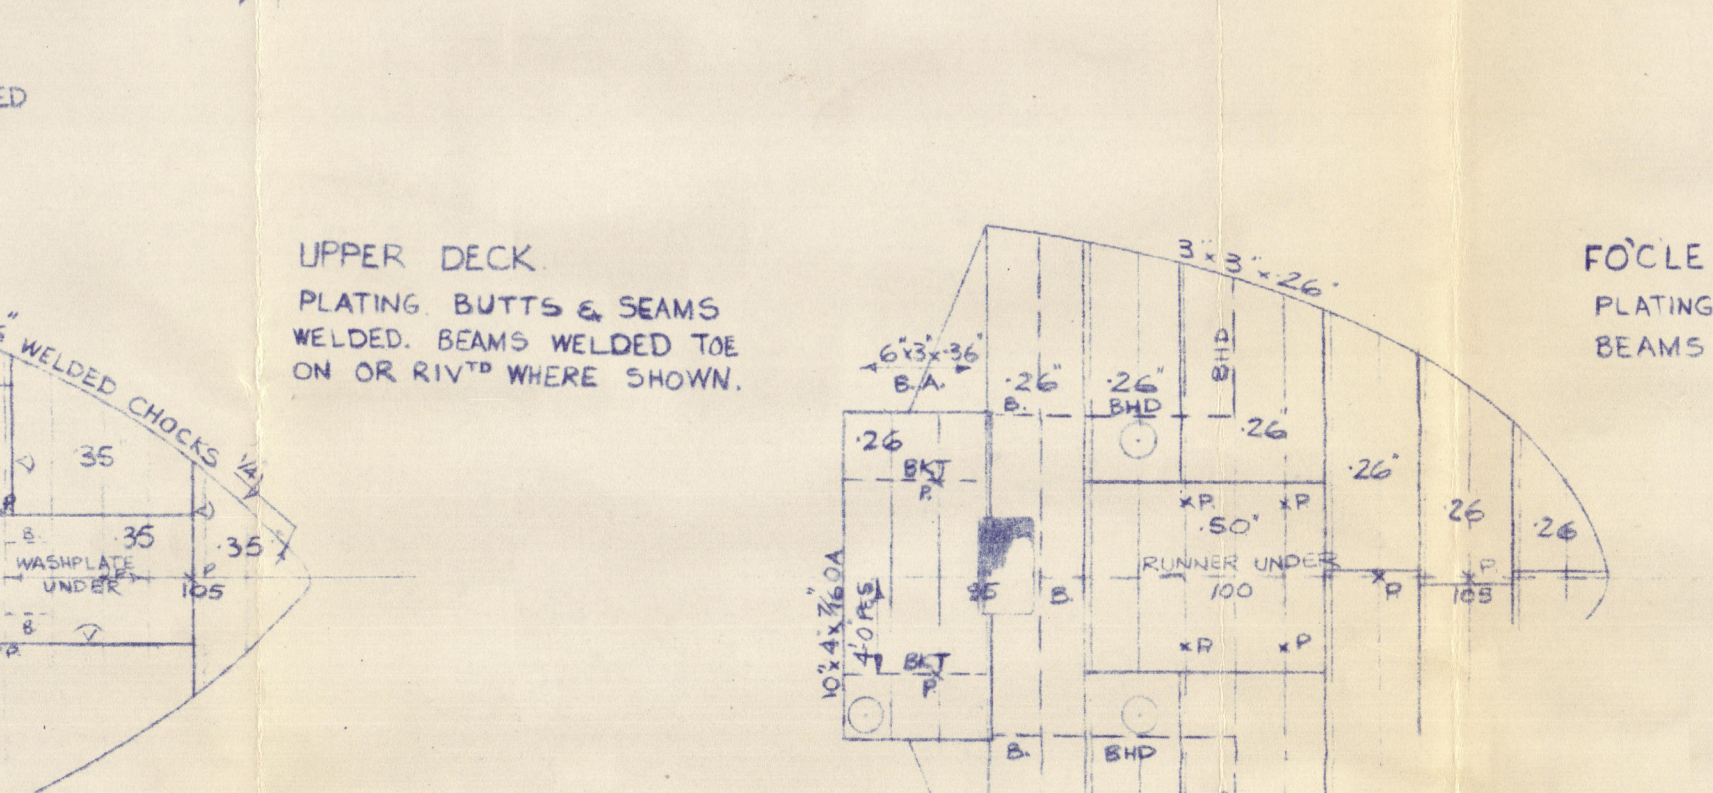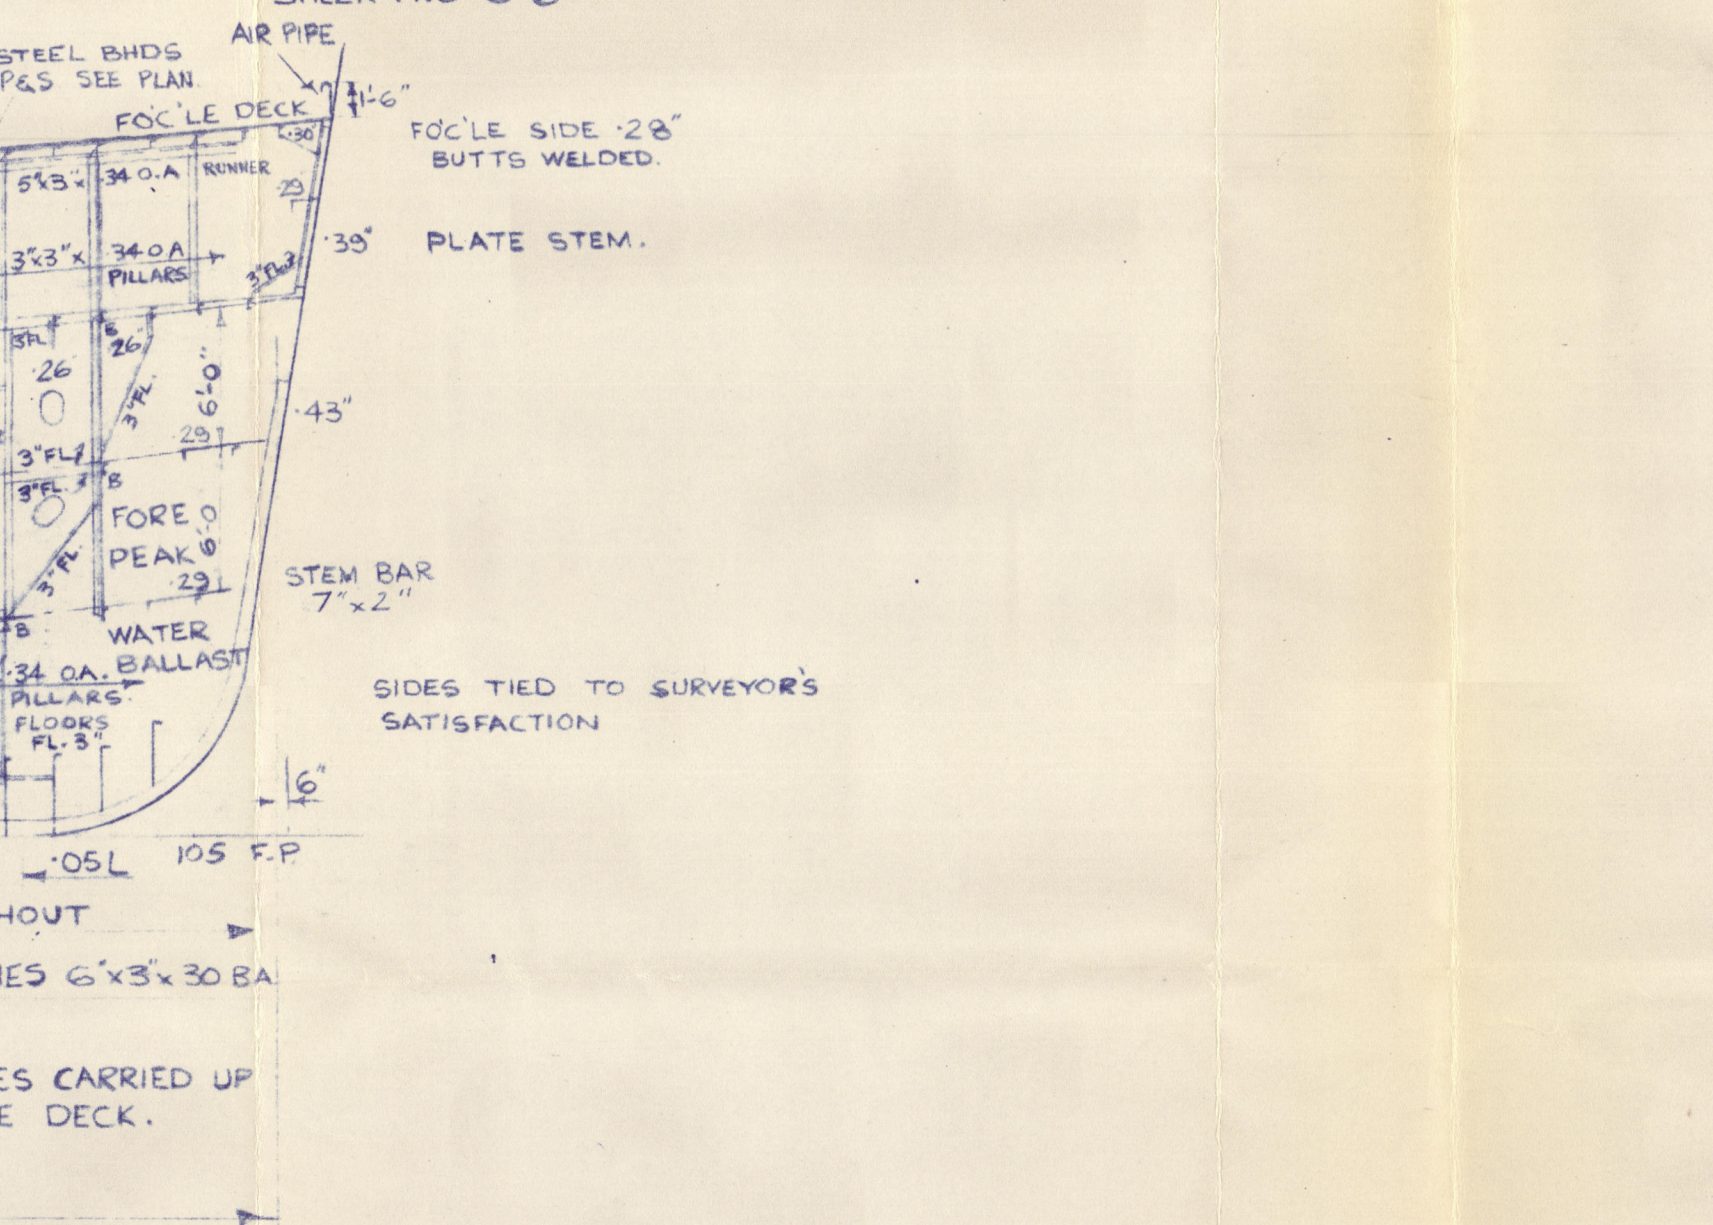

LOWER DECK HATCH WEB ENDS

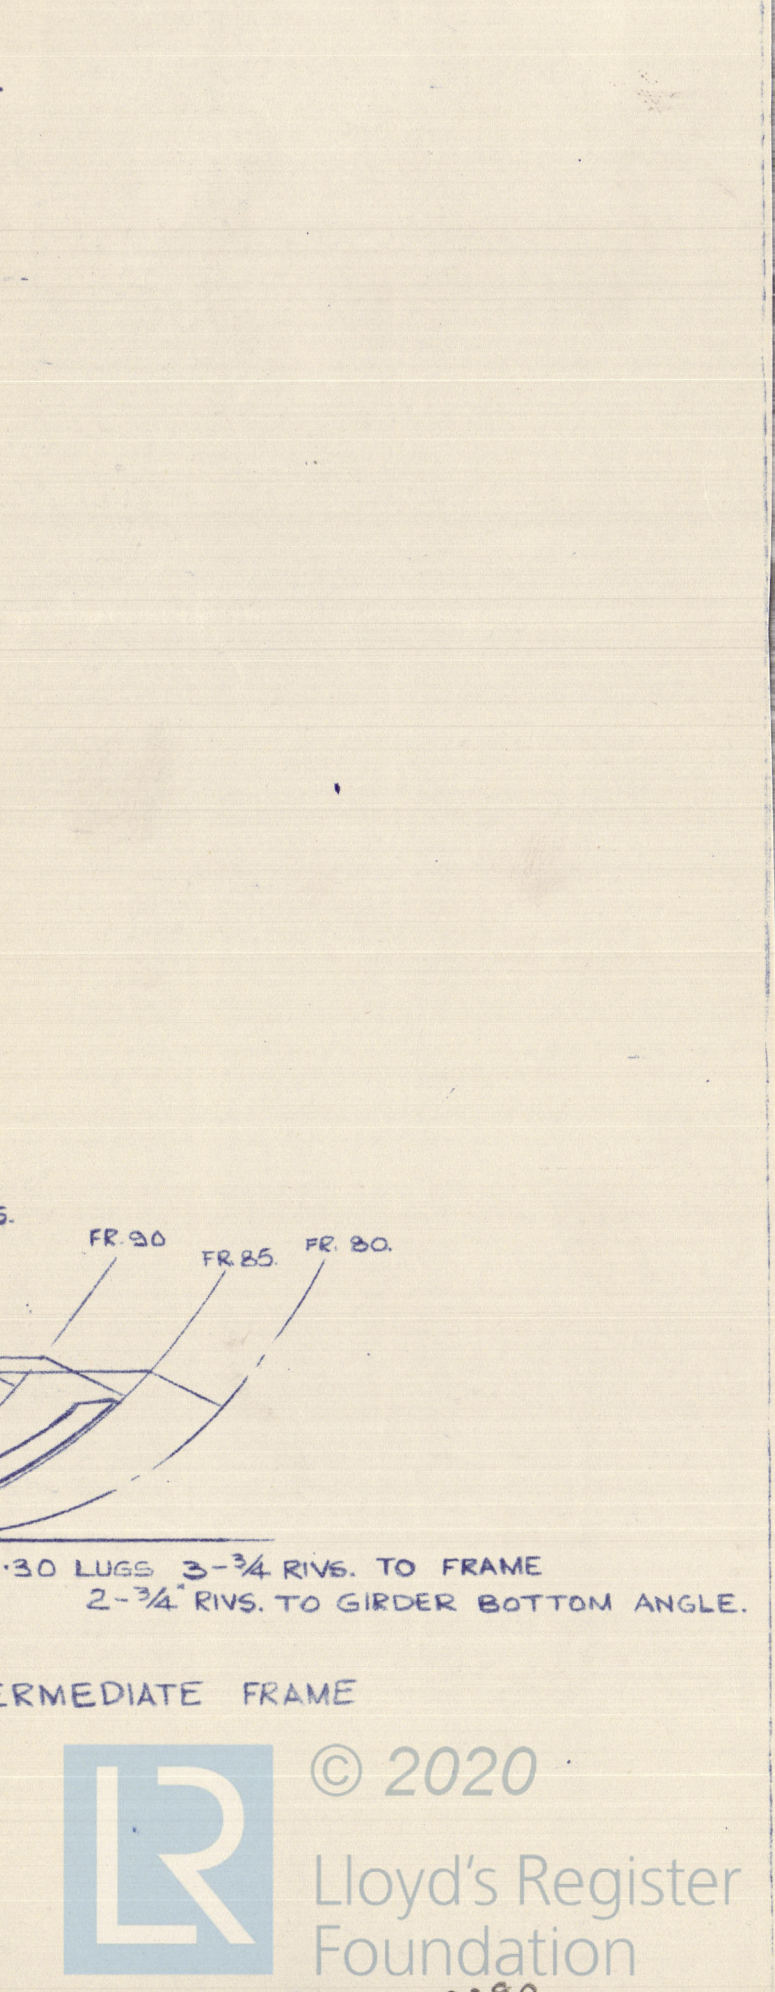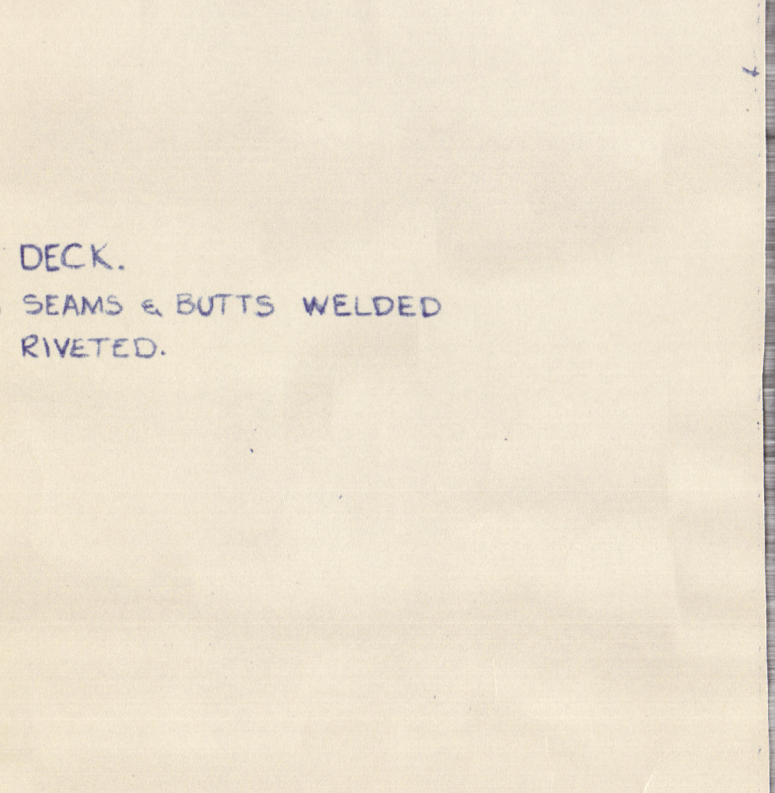 

LOWER DECK HATCH WEB ENDS

Bumtisland S.B. Co.

yard 359


Profile and Decks.

(As Fitted)

"TEESWOOD" ★

LEITH REPORT No. 23307.

RECORDS DEPT.
LONDON

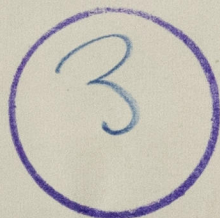

RETAIN



© 2020

Lloyd's Register
Foundation

003391-003400-0080