


H.M. TUG DEXTEROUS.
DIESEL ELECTRIC PADDLE TUGS.
PROFILE & STEEL DECKS.

(AS FITTED)


DRG. N° 40147.
SCALE - 1/4" = 1 FOOT.
DATE - MAY 1954.

RECORDS DEPT.
LONDON.

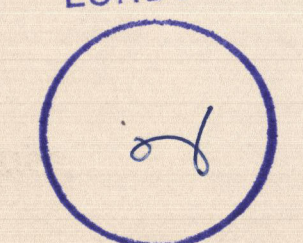

GLASGOW REPORT No. 44638

NAME OR NO. OF SHIP	CONTRACTOR'S NAME, ADDRESS, DATE	ACTION OR REMARKS	AUTHORITY	INSPECTING OFFICER'S NAME, ADDRESS, DATE
2088 & 2089	YARROW & CO. LTD.	SUBMISSION TO LLOYDS.		
H.M.S. DIRECTOR & H.M.S. DEXTEROUS	D.O.	APPROVED BY LLOYDS.	LETTER DATED 25-6-54	

 

N°40147

N°40147

