




M.V. NOS 331-2

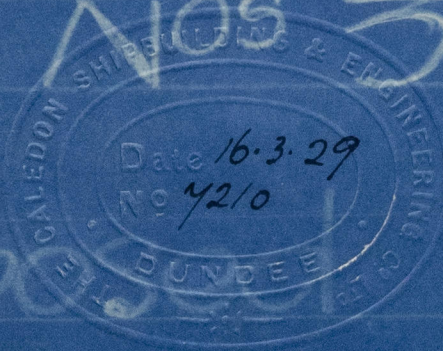

910

Proposed Scarph in
Rudder Casting. -

Scale $\frac{3}{4}$ - One foot. -

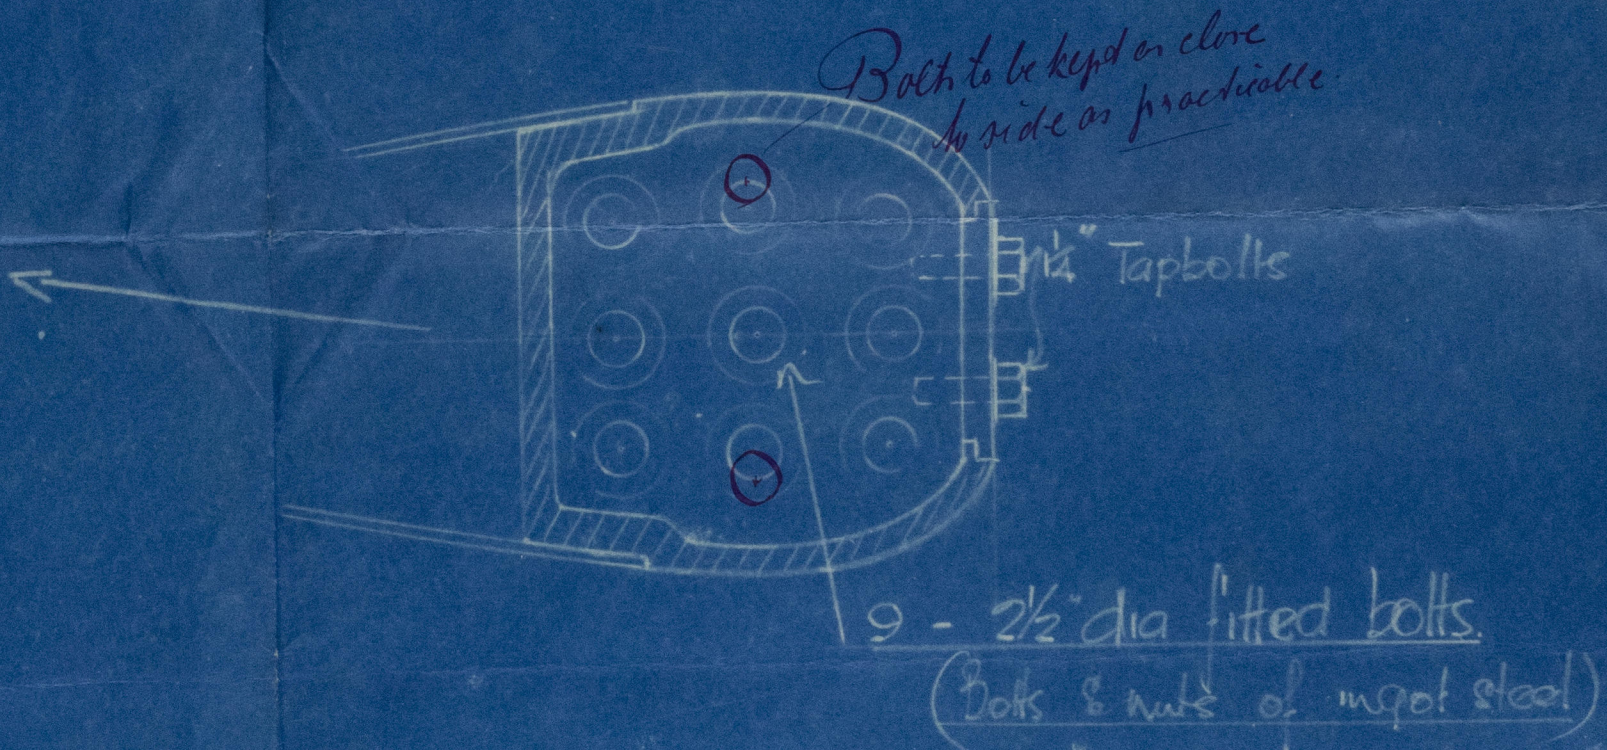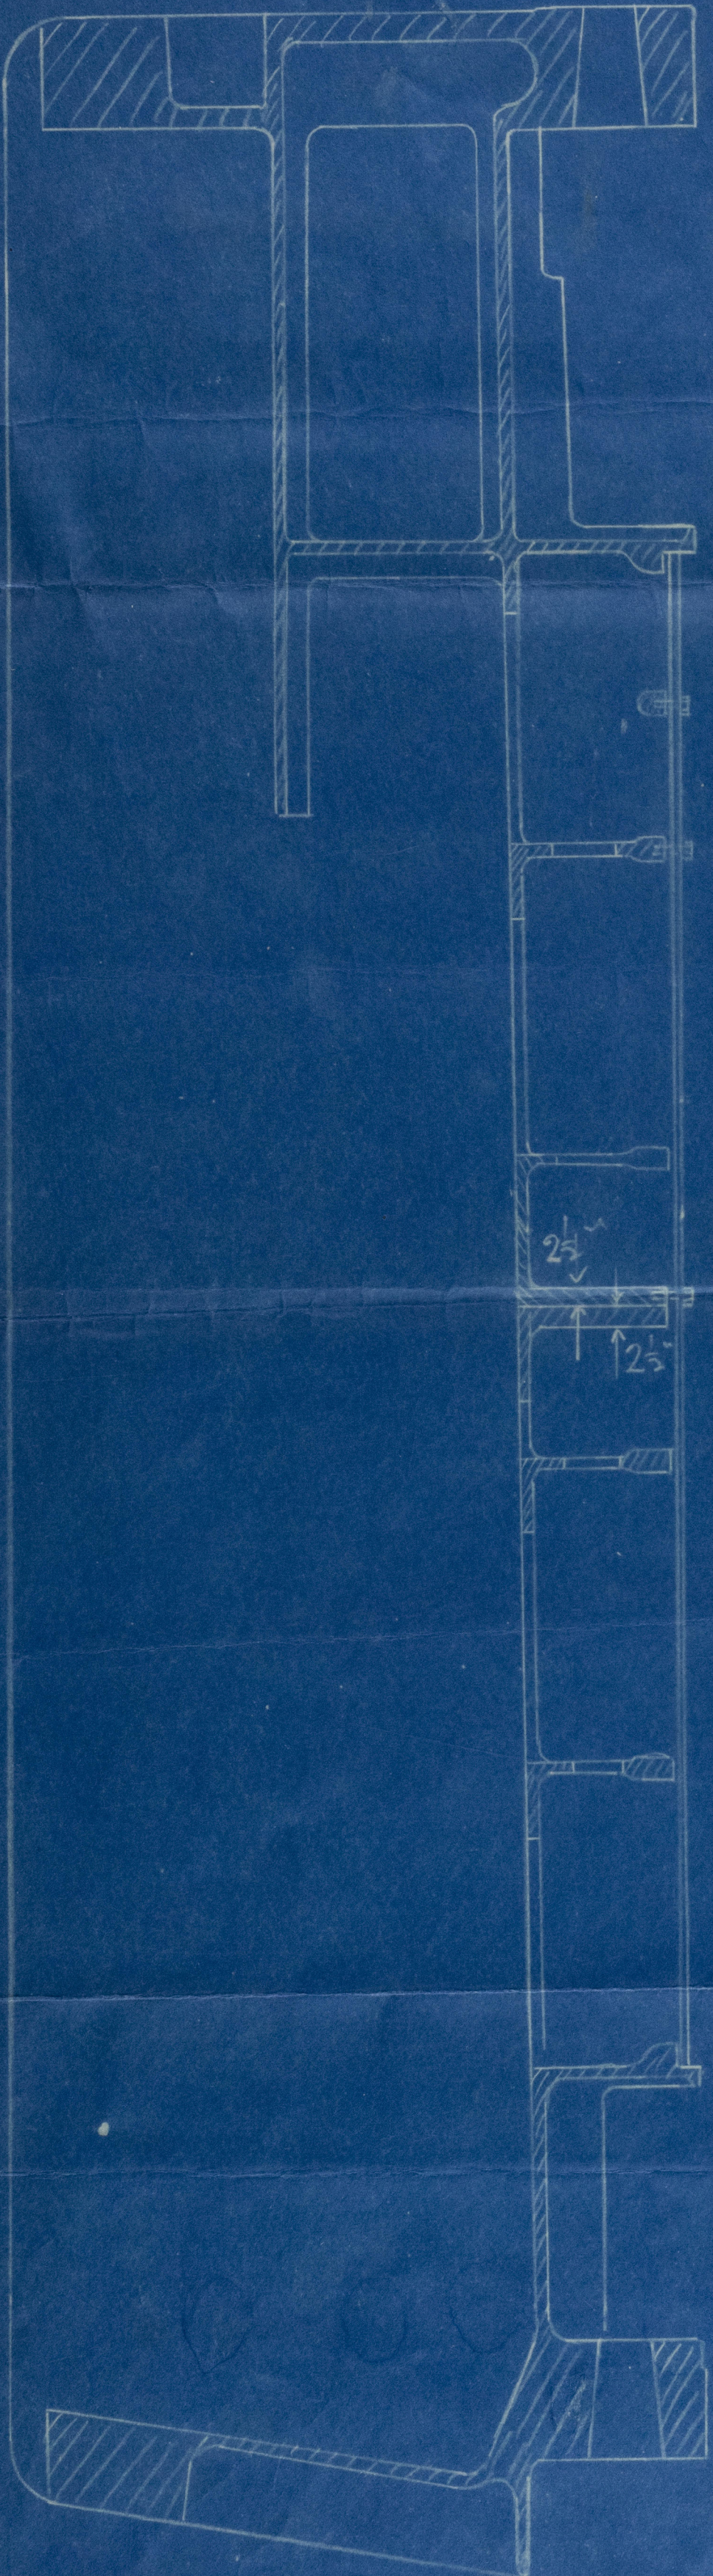

W.S.
18.3.29.



© 2020
Lloyd's Register
Foundation

003401-003408-0087

(12)

Messrs. The Caledon S. & E. Co.


Nos 331/2.

Proposed Scarph in Rudder.
Casting.

331 - m.v. *"Talisie"*

332 - M.V. *"Tanimbar"*

L

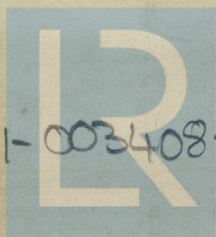

© 2020

003401-003408-0087

Lloyd's Register
Foundation