


See sketch for extension of girder to Bulkhead 15.

12/14/57  
Office  
Ing. Sjögren

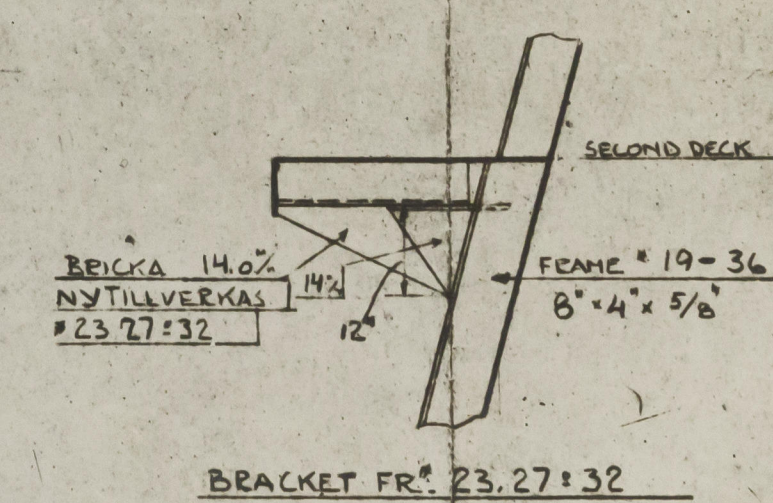

RÄTTAD ENL. LLOYDS GODKÄNNANDE D.31-1-49 17/50

**HELSINGBORG'S VARFS A.B.**  
HÄLSINGBORG - 8. FEB. 1949

ALTERED ARRANGEMENT OF HOLD #1 SECOND DECK	"SOMMEN" 1/3 SKAGERN, HÄLSINGBORG Köl 315.
RIT. AV: <i>[Signature]</i>	1:48 7/24 29-1-49
KOP. AV:	
GR. AV:	
GODK. AV: <i>[Signature]</i>	RITN. NO. <b>R-904</b>

003409-003416-0063