

Amended computation for alteration to forecastle.

Lloyd's Register of Shipping.

SURVEYS FOR FREEBOARD.

(COMPUTATION FOR STEAMER, SAILING SHIP, TANKER.)

Index. No. **34972**
(For London Office only).

Ship's Name GLENGARRIFF.	Official Number 165154.	Nationality and Port of Registry British Belfast	Gross Tonnage	Date of Build 1936	Port of Survey
Moulded Dimensions: Length 197.33'	Breadth 30.5'	Depth 14.33			Date of Survey 23.10.42
Moulded displacement at moulded draught = 85 per cent. of moulded depth		1556	tons		Surveyor's Signature
Coefficient of fineness for use with Tables .743					Particulars of Classification +100A1.

Depth for Freeboard (D).	Depth correction.	Round of Beam correction.
Moulded depth 14.33	(a) Where D is greater than Table depth $R = \frac{D - \text{Table depth}}{1.21} = \frac{14.33 - 13.15}{1.21} = +1.84''$	Moulded Breadth (B) 30.5
Stringer plate03	(b) Where D is less than Table depth (if allowed) (Table depth - D) R =	Standard Round of Beam = $\frac{B \times 12}{50} = 7.32$
Sheathing on exposed deck $T \left(\frac{L-S}{L} \right) =$	If restricted by superstructures	Ship's Round of Beam = 8.50
Depth for Freeboard (D) = 14.36		Difference = .68
		Restricted to
		Correction = $\frac{\text{Diff}}{4} \times \left(1 - \frac{S_1}{L} \right) = 17 \times .2227 = -.04''$

DEDUCTION FOR SUPERSTRUCTURES.

	Mean Covered Length (S)	Equivalent Enclosed Length (S ₁)	Height	Height Correction	Effective Length (E)
Poop enclosed					
„ overhang					
R.Q.D. enclosed ...	112.42	112.42	4.0'	✓	112.42
„ overhang					
Bridge enclosed... ..	11.00	11.00	7.0'	✓	11.00
„ overhang aft					
„ overhang forward					
F'cle enclosed <i>Exclud.</i>	29.50	29.50	7.0'	✓	29.50
„ overhang83	.42			.42
Trunk aft					
„ forward					
Tonnage opening aft ...					
„ „ forward					
Total	153.75	153.34			153.34

Standard Height of Superstructure	6.00'
„ „ R.Q.D.	3.649'
Deduction for complete superstructure	25.73''
Percentage covered $\frac{S}{L} =$	77.92
„ „ $\frac{S_1}{L} =$	77.71
„ „ $\frac{E}{L} =$	77.71
Percentage from Table, Line A. (corrected for absence of forecastle (if required))	✓
Percentage from Table, Line B. (corrected for absence of forecastle (if required))	72.48
Interpolation for bridge less than 2L (if required)	✓
Deduction = $25.73 \times 72.48 =$	-18.65

SHEER CORRECTION.

Station	Standard Ordinate	S	M	Product	Actual Ordinate	Effective Ordinate	S	M	Product
A.P.	29.73	1		29.73	35.5	39.70	1		39.70
$\frac{1}{4}$ L from A.P. ...	13.23	4		52.92	16.0	17.67	4		70.68
$\frac{2}{4}$ L „ ...	3.27	2		6.54	4.5	4.37	2		8.74
Amidships	-	4		-	-	-	4		-
$\frac{3}{4}$ L from F.P. ...	6.54	2		13.08	9.25	9.25	2		18.50
$\frac{1}{4}$ L „ ...	26.46	4		105.84	32.5	32.50	4		130.00
F.P.	59.46	1		59.46	72.5	72.50	1		72.50
Total				267.57					340.12

Correction = $\frac{\text{Difference between sums of products}}{18} \left(\frac{.75 - S}{2L} \right) = \frac{72.55 - 3896}{18} = -1.45''$

If limited on account of midship superstructure. ✓

Mean actual sheer aft = Excess.
Mean standard sheer aft = Excess.

Mean actual sheer forward = Excess.
Mean standard sheer forward = Excess.


Length of enclosed superstructure forward of amidships = **> 12**
„ „ aft of „ = **> 12**

Actual height of R.Q.D. = **4.00'**
Staves and „ = **3.65**
Difference = **.35 = 4.2''**

Deduction for Tropical Freeboard.	Deduction for Fresh Water.	TABULAR FREEBOARD corrected for Flush Deck (if required)
Addition for Winter and Winter North Atlantic Freeboard.	Displacement in salt water at summer load water line	Correction for coefficient
Depth to <i>R.Q.</i> Deck = 18.36	$\Delta =$ 1838	$.743 + .68 = 1.423 / 1.36$
Summer freeboard = 4.46	Tons per inch immersion at summer load water line	Depth Correction 1.84
Moulded draught (d) = 13.90	T = 12.18	Deduction for superstructures 18.65
Deduction for Tropical freeboard and addition for Winter freeboard = $\frac{d}{4}$ inches = 3.48 = 3 1/2''	Deduction = $\frac{\Delta}{40T}$ inches = 3.77	Sheer correction 1.45
Addition for Winter North Atlantic Freeboard (if required) = 5 1/2''	= 3 3/4''	Round of Beam correction04
		Correction for Thickness of Deck amidships
		Other corrections, scantlings, etc. <i>height of main Quarter Deck</i> 48.00
		49.84 20.14 +29.70
		Summer Freeboard = 53.40

SUMMER FREEBOARD amidships from Centre of Disc to top of Deck Line, Wood, Steel Deck :-	
Tropical Fresh Water Line above Centre of Disc	7 1/4''
Fresh Water Line „ „	3 3/4''
Tropical Line „ „	3 1/2''
Winter Line below „ „	3 1/2''
Winter North Atlantic Line „ „	5 1/2''
Tropical Fresh Water Freeboard	4' - 5 1/2''
Fresh Water „ „	4' - 10 1/4''
Tropical „ „	4' - 1 3/4''
Winter „ „	4' - 2''
Winter North Atlantic „ „	4' - 11''

A new form should be prepared if any alterations that affect the freeboard have been made. If no such alterations have been made, the Surveyor should endorse the form on this side with his signature and the date.

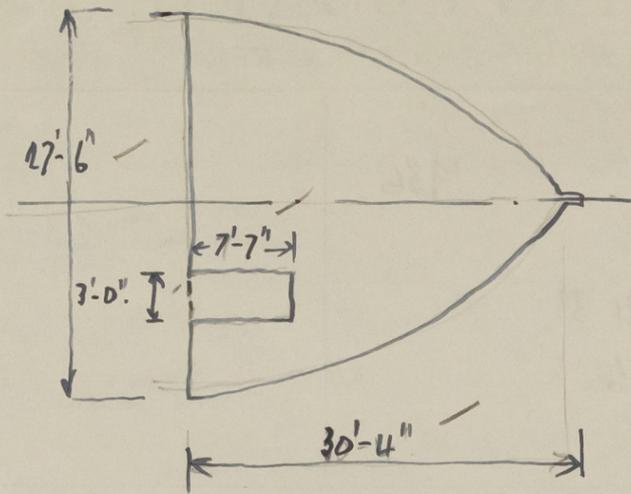

$$\text{hears } \frac{7.58 \times 3.0}{27.5} = .83'' \text{ equiv. overhang}$$

$$30.33 \text{ total length}$$

$$\underline{29.50} \text{ equiv. enclosed}$$

Trade of ship _____

Names of sister ships _____

Builder's name and yard number _____

Owners _____

Fee £ _____



© 2021

Lloyd's Register
Foundation