

Lloyd's Register of Shipping.

Ship's Name "GLEN GARRIFF"


Official No. 165154.

Memorandum of alterations reported since ship was surveyed for assignment of Load Lines in _____

Strongly constructed steel house built at open Forecastle Front space as shown on sketch below, to accommodate 6 gunners. House fitted with substantial hinged steel door capable of being operated from both sides, coaming 18" high. One 14" dia and one 12" dia side scuttle having strong hinged deadlights fitted in way of fore end of house.

Existing w.c space on starboard side extended and one additional w.c fitted discharging overboard through existing w.c. sanitary discharge pipe.

One 10" dia side scuttle having strong hinged deadlight fitted at fore end of space.

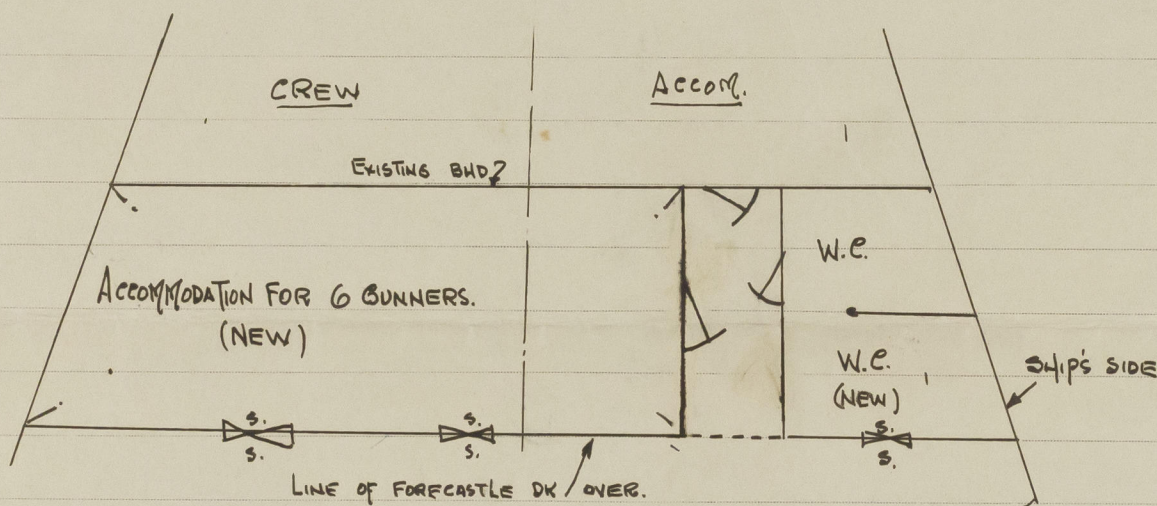

A copy of the above placed on board ship.

H. Little

Newcastle-on-Tyne
12th October 1942.

224