


DECK PLATING IN WAY OF TANK TO BE EXAMINED AND MODIFIED AS NECESSARY TO SUIT LLOYDS REQUIREMENTS.

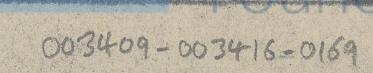

(1)

S. P. "Paris City"

NEWCASTLE-ON-TYNE, No. 105843.

Commission of Gross Brothers &

Water Ballast Tank.



© 2021

Lloyd's Register
003409-003416-0169
Foundation