


27 FEB 1941

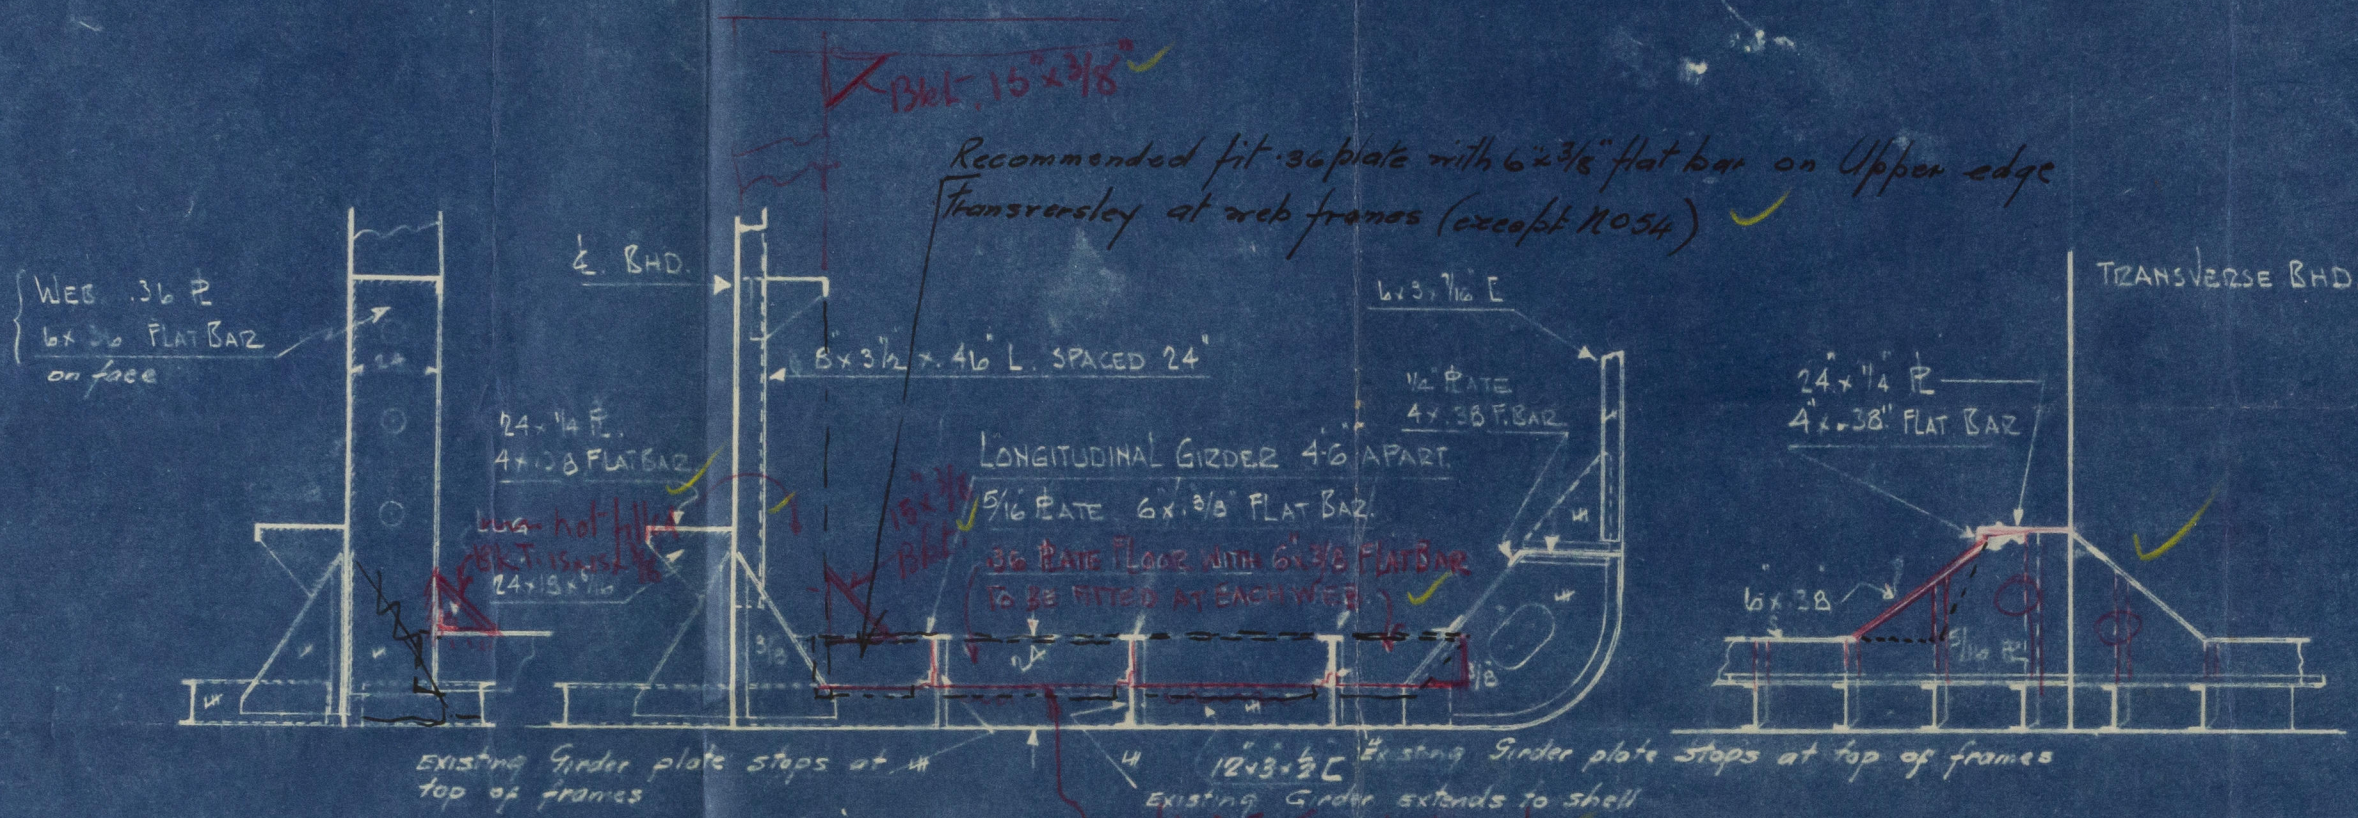

EXISTING CONSTRUCTION RIVETTED MARKED THUS

TYPICAL SECTION


SPACED 2 FEET.

New construction to be welded

LONGT. SECTION AT GIRDER.

NOTE:

No FLOOR PLATE TO BE FITTED AT WEB NO. 54.

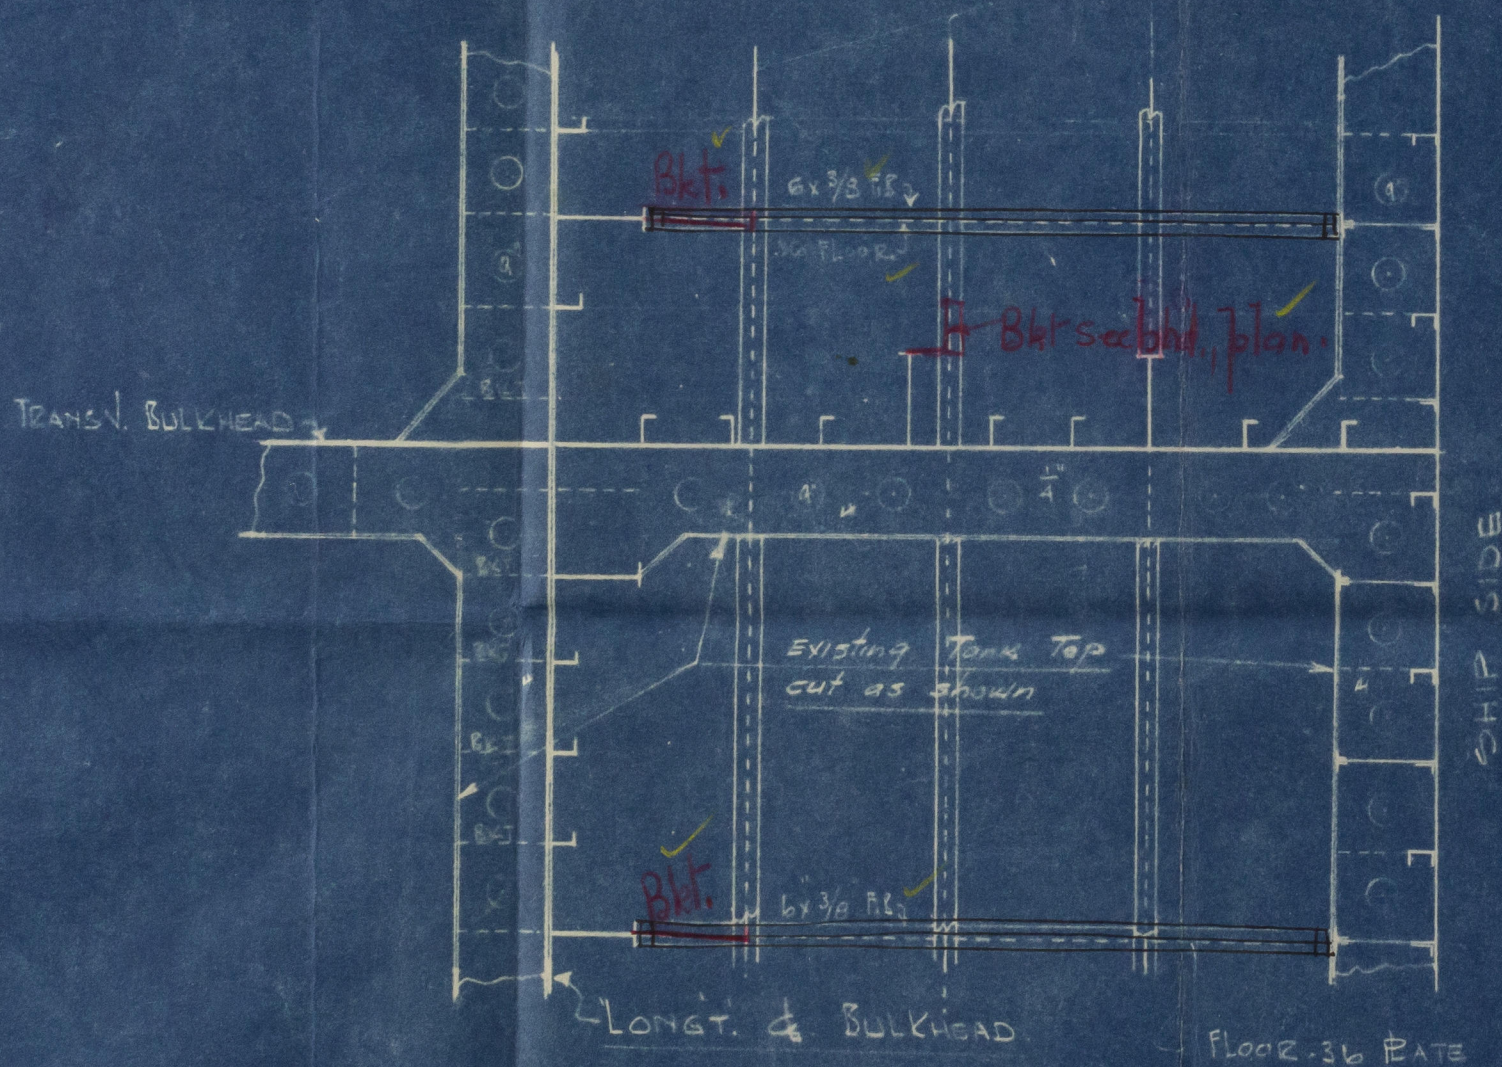

Alterations Note
In ship as in Red
Approved as in black

THE BRITISH CORPORATION REGISTER OF SHIPPING AND AIRCRAFT

Approved (Initials) E.R.M. May 19/1940.

MARINE INDUSTRIES, LIMITED
SOREL, P. Q.

SS. "THUNDER BAY"
MODIFICATION TO DOUBLE BOTTOM

MADE
TRADED
CHECKED
CONTRACT No. 83
MAY 11th 1940
14 x 11 FT.
No. 2

APPROVED BY BOARD OF STEAMSHIP INSPECTION: 28-5-40


APPROVED BY B.C. 22-5-40

003418 003426 0036

Modification to Double Bkm.

SS PINEBRANCH.

27.2.41

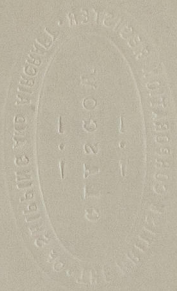

No 2.
Pinebranch -
Modification to B

Bottom

4.0.

003418-003420-0056



© 2020

Lloyd's Register
Foundation