

6.3.93

Midship Section

N^o 102

BP
60'0" x 14'0" MLDED x 7'6" MLDED DEPTH

Class. ~~III~~ A1. "For Jovian purposes"

5. Aug Edith

Hull Report No:

Lloyds Numbers. —

$\frac{1}{2}$ Breadth 7.0

1/2 Ginz 12.16

Depth 7.82


26. 99 small No

59.08

1593.56 PLATING NO

BEAMS. 4.2

DEPTH. 7.5

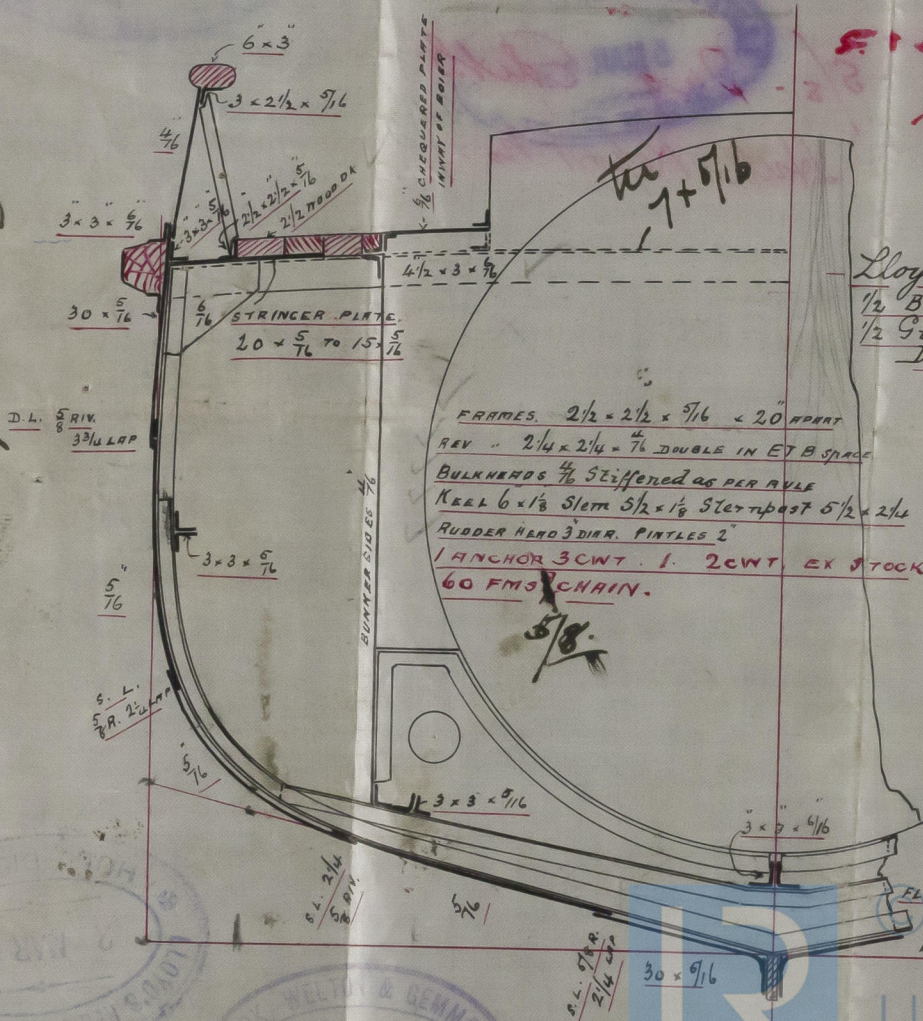

FLOORS 9 x 76
BOILER BEARERS
ENGINE FLOORS 5

Lloyd's Register
Foundation


003421-003428-0002

Cook wellson
Gemmello's 102

~~Canceled~~ 30/3/93

S/S *Tag* Edith
Hull Report No. 84/13

EDITH ✕

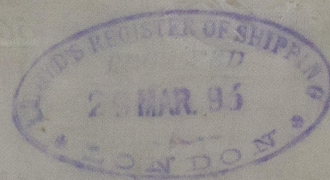

RETAIN



© 2020

Lloyd's Register
Foundation

003421-003428 0002