
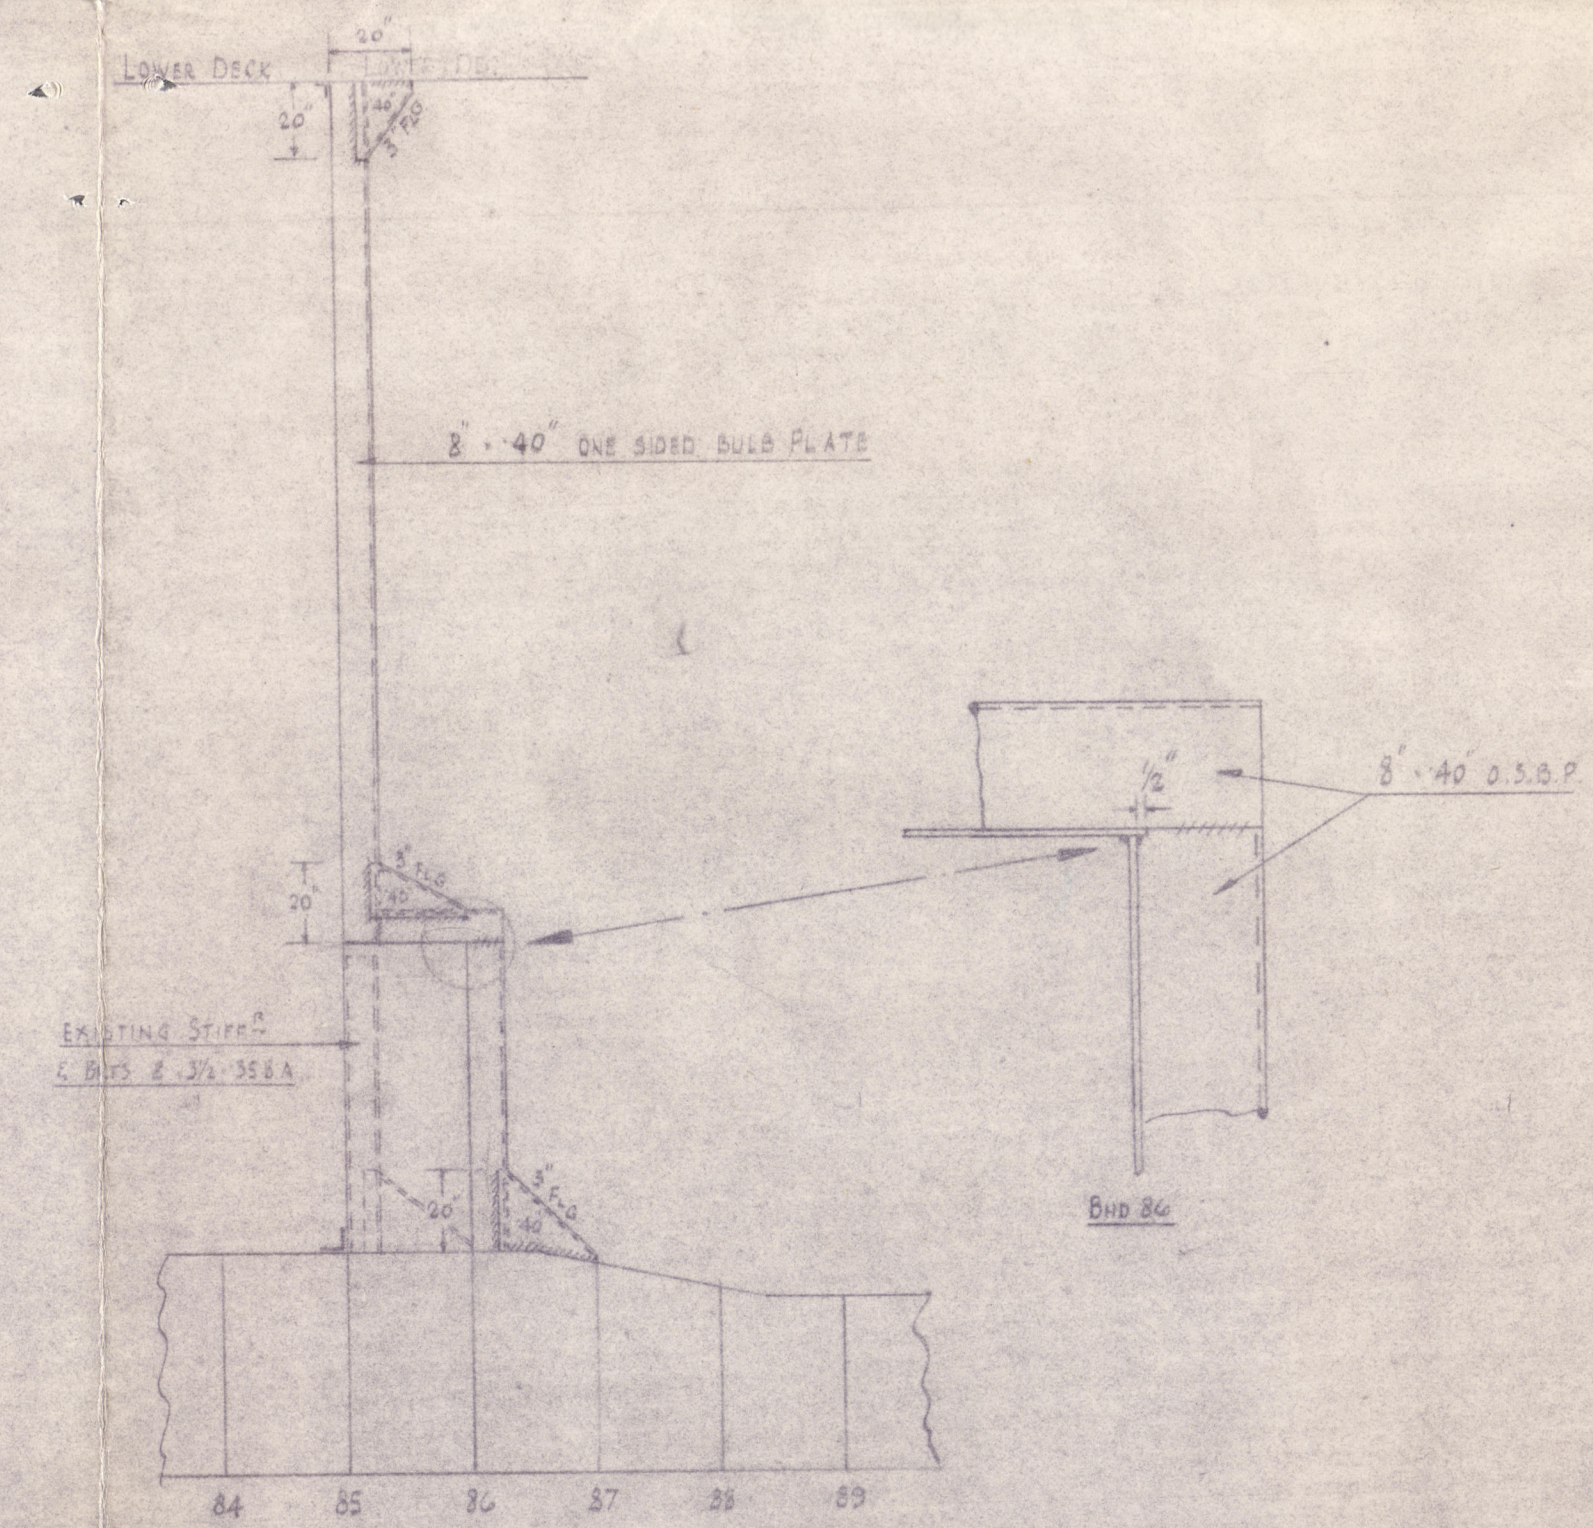
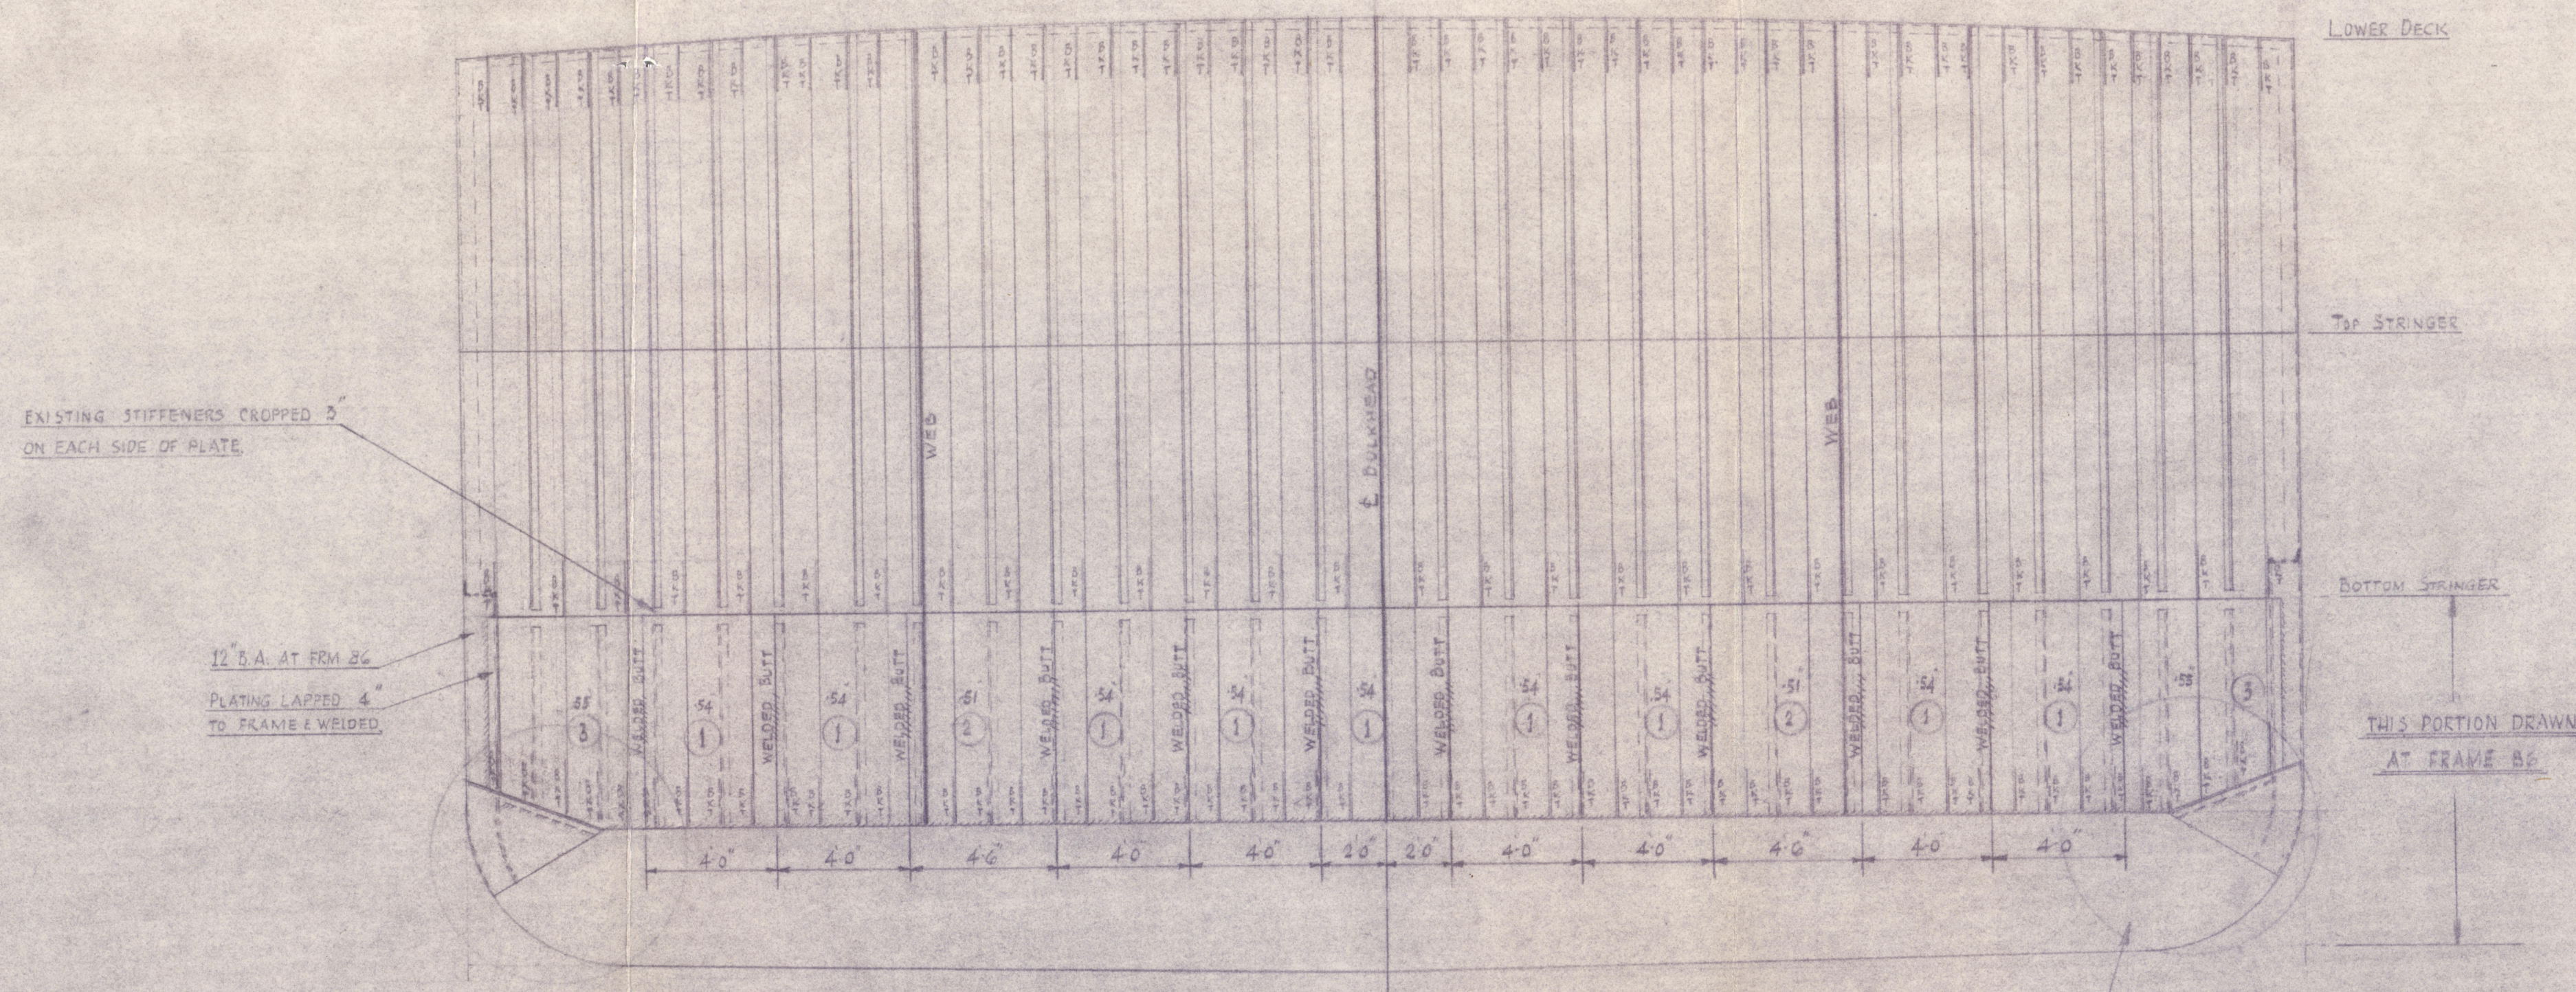
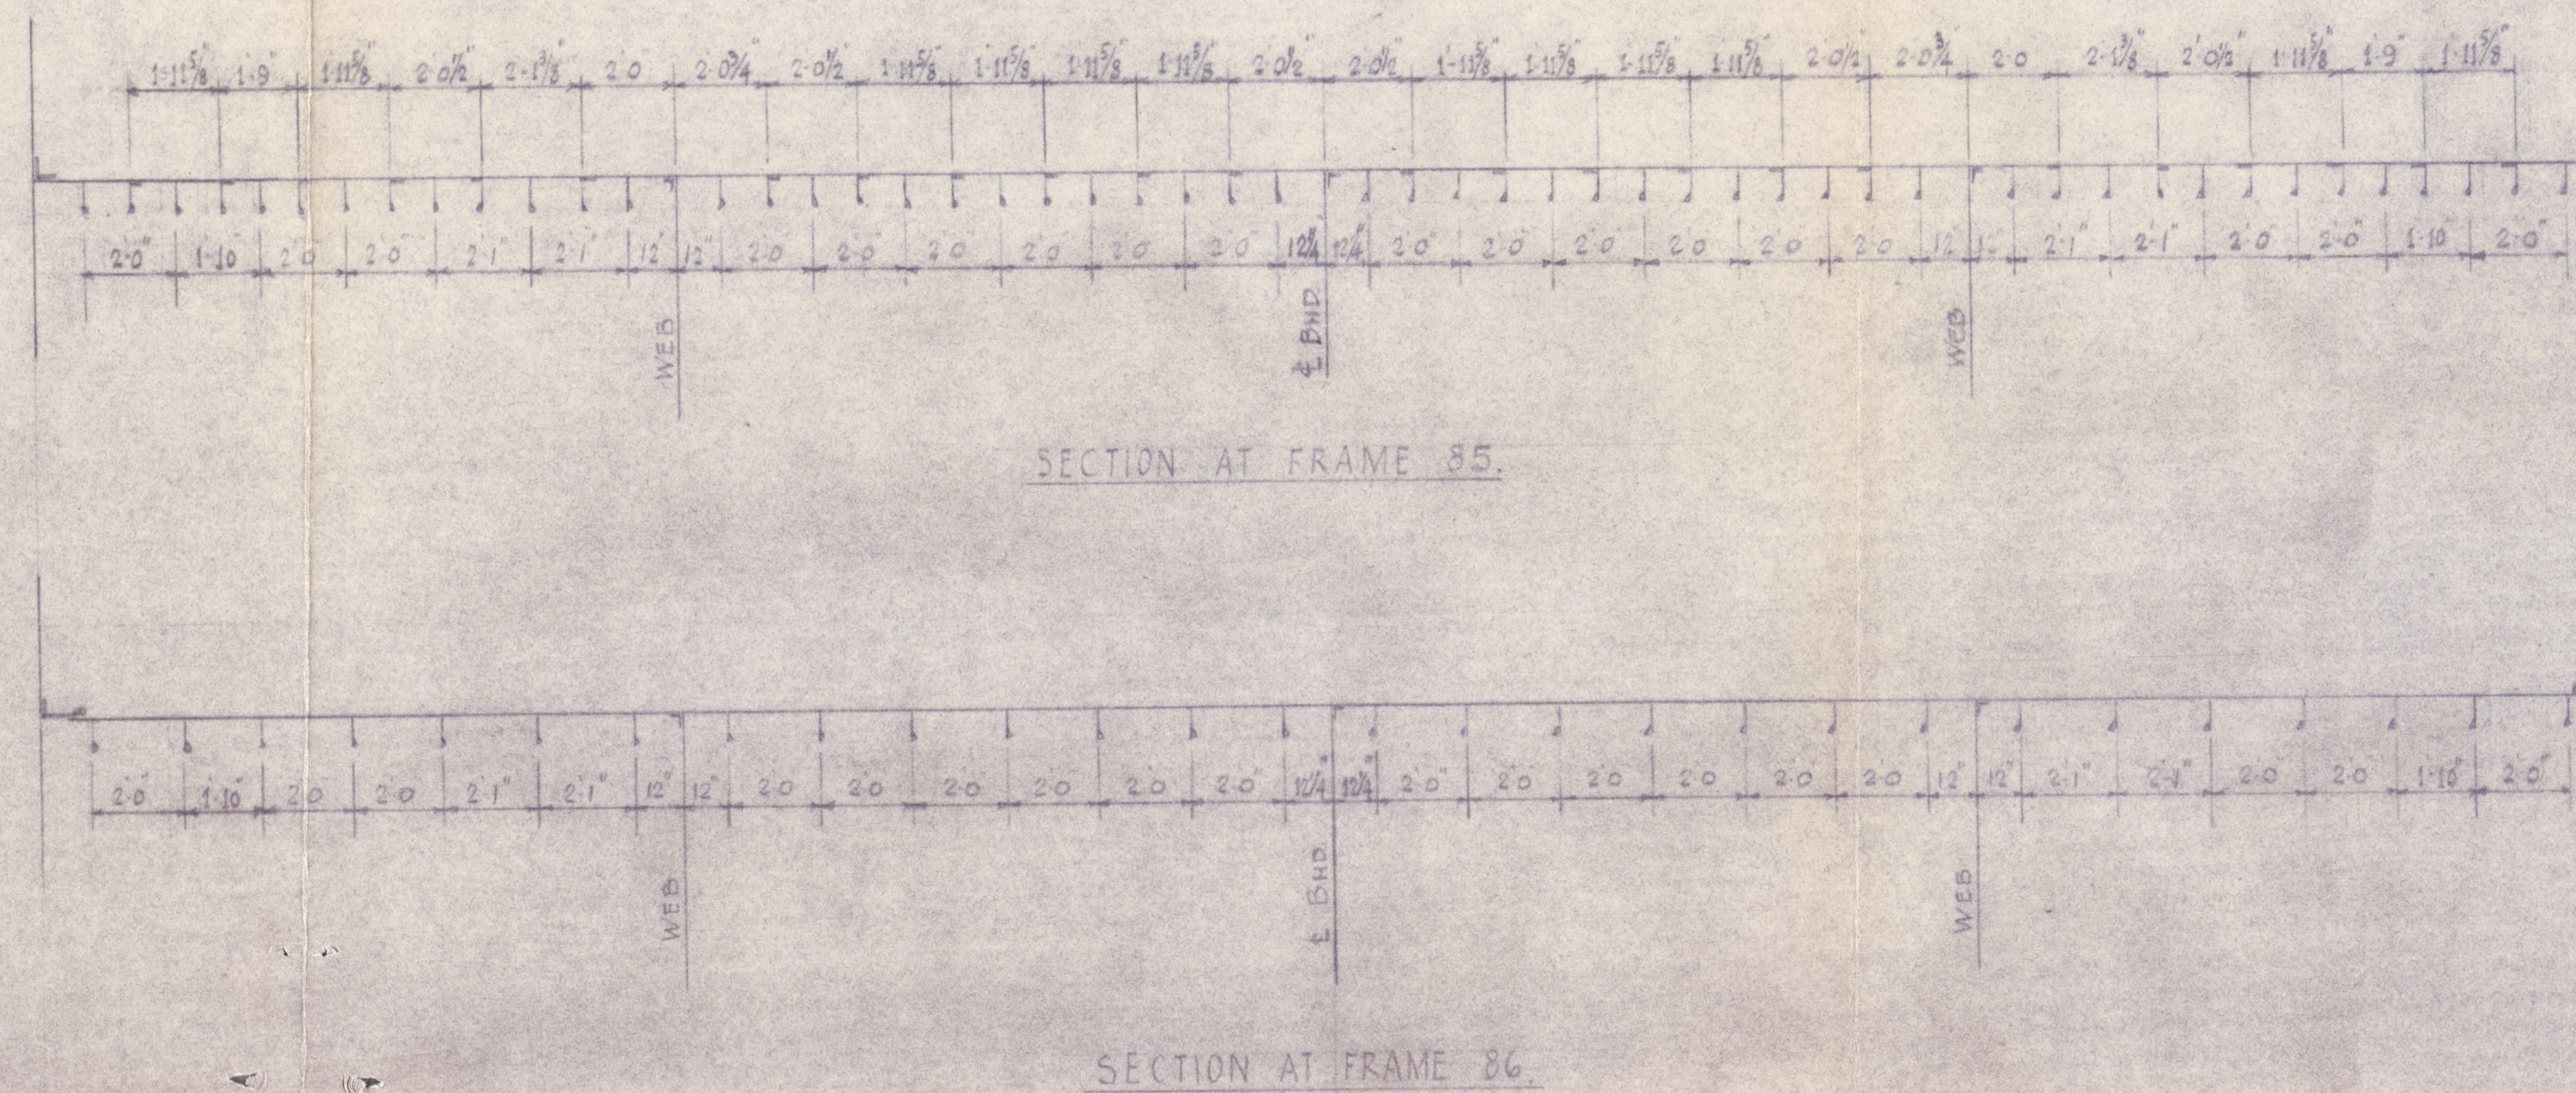


# "KING ALFRED"


## DETAIL OF MODIFICATION TO BHD. 85.

SCALE - 1/4" = ONE FOOT

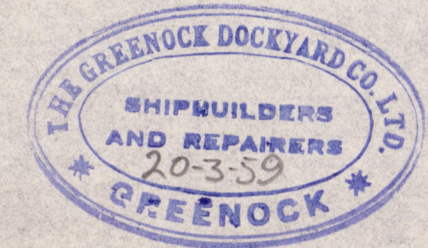

- ① 493 / B.R. 7 ~ 3 @ 22'6\"/>

BULKHEADS 85 & 86  
LOOKING AFT  
EXISTING STIFFENERS 8\"/>

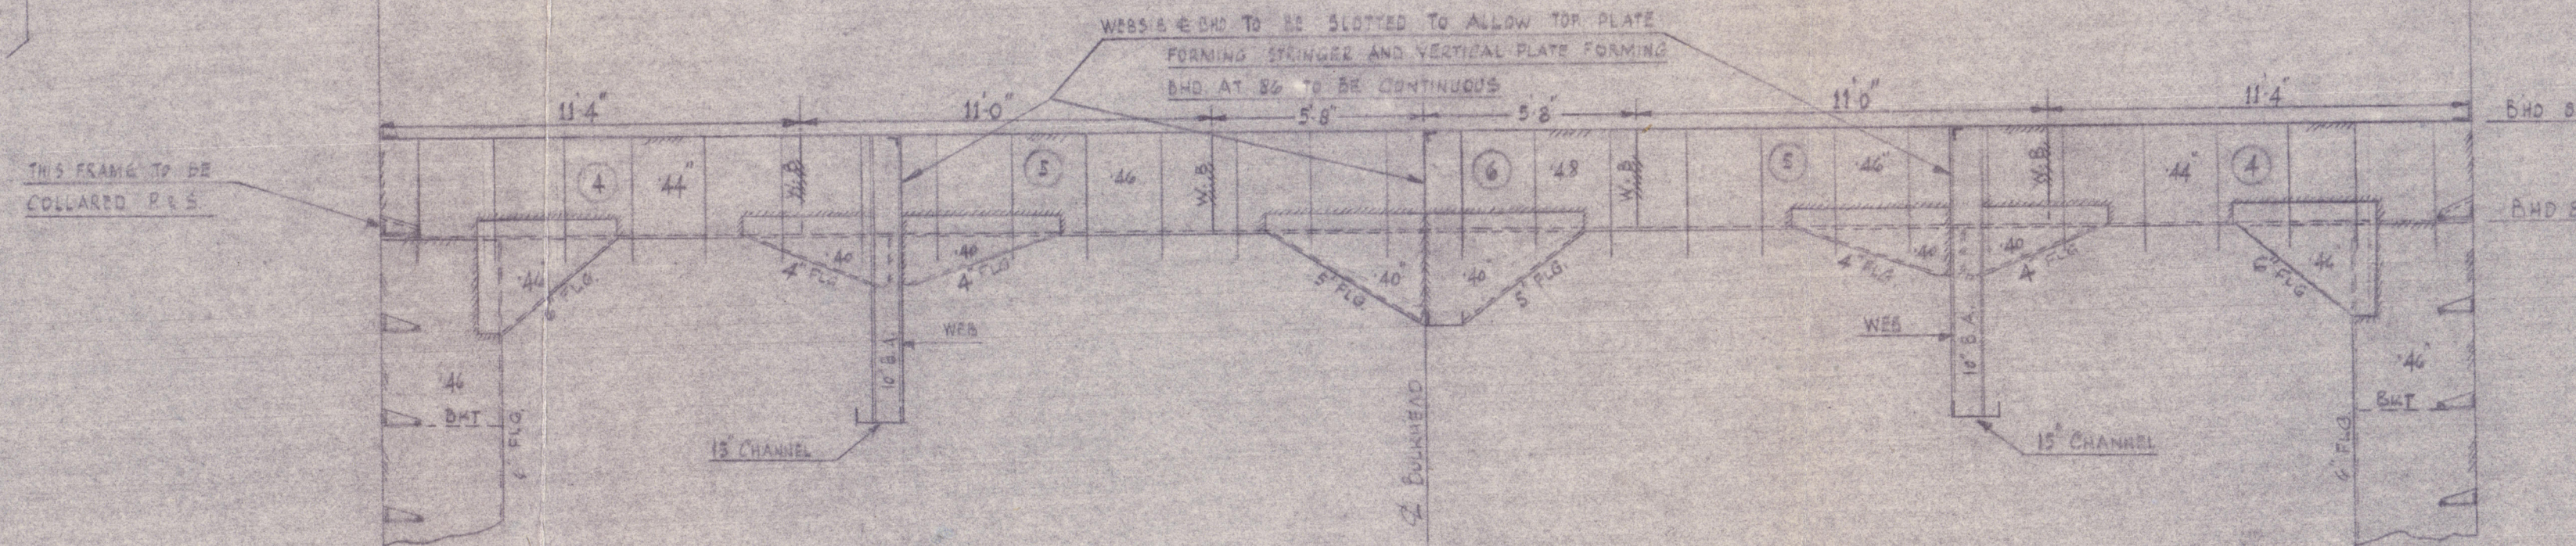

PLAN VIEW AT BOTTOM STRINGER  
ALL ORIGINAL STRINGER B.R.T. TO BE MODIFIED & USED

ELEVATION IN WAY OF ADDITIONAL STIFFENERS.



"<sup>u</sup>  
KING ALFRED

MODIFICATION TO BULKHEAD 85

CARRIED OUT AT S.S. (C) 3/59.

GREENOCK REPORT N<sup>o</sup> 26342.



© 2020

Lloyd's Register  
Foundation

003429-003433-0193