

OFFICE COPY
S/S. "KYLEQUEEN."



PROPOSED OIL FUEL CONVERSION.

SCALE: - 1/8" = 1 FOOT.


TO ACCOMPANY *Ant.* REPORT No. 31139
DATED. 3.56.

EXISTING.


PROPOSED.

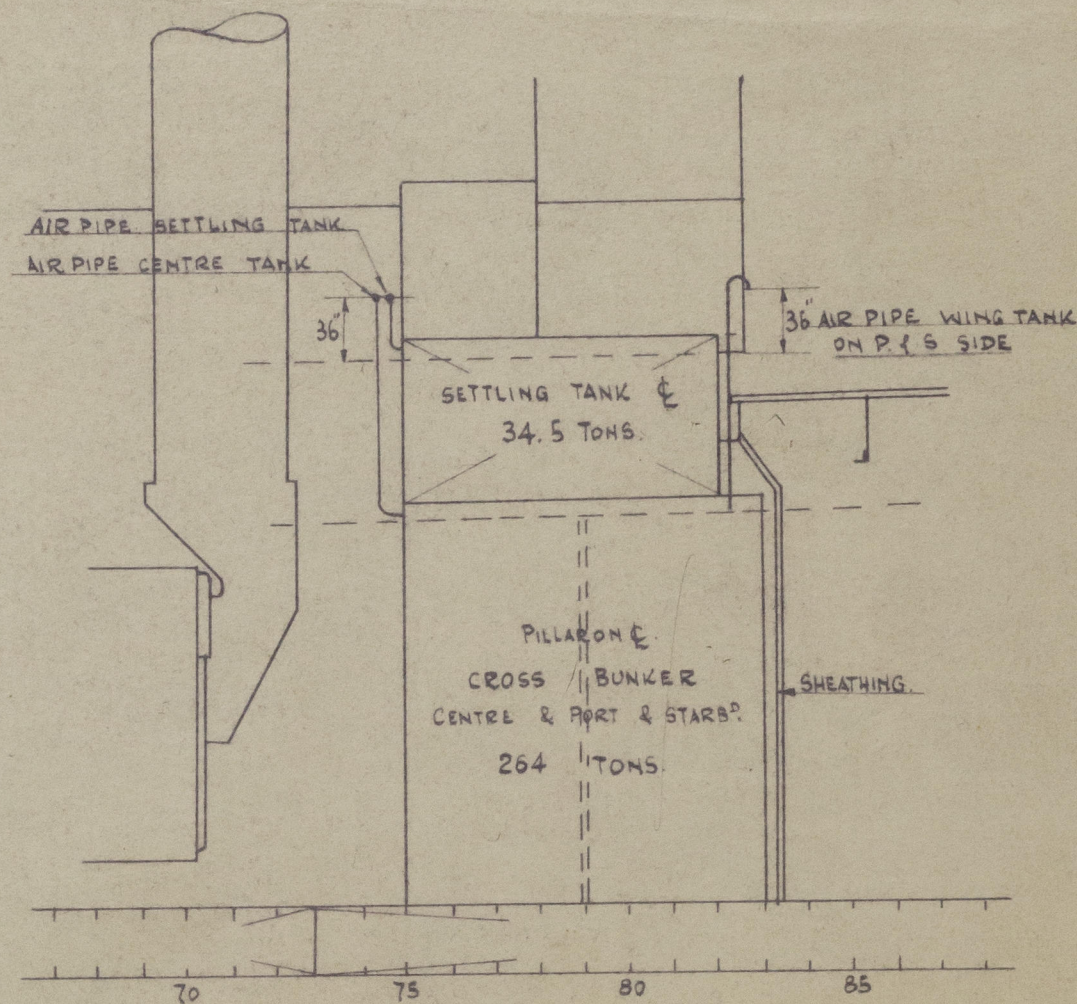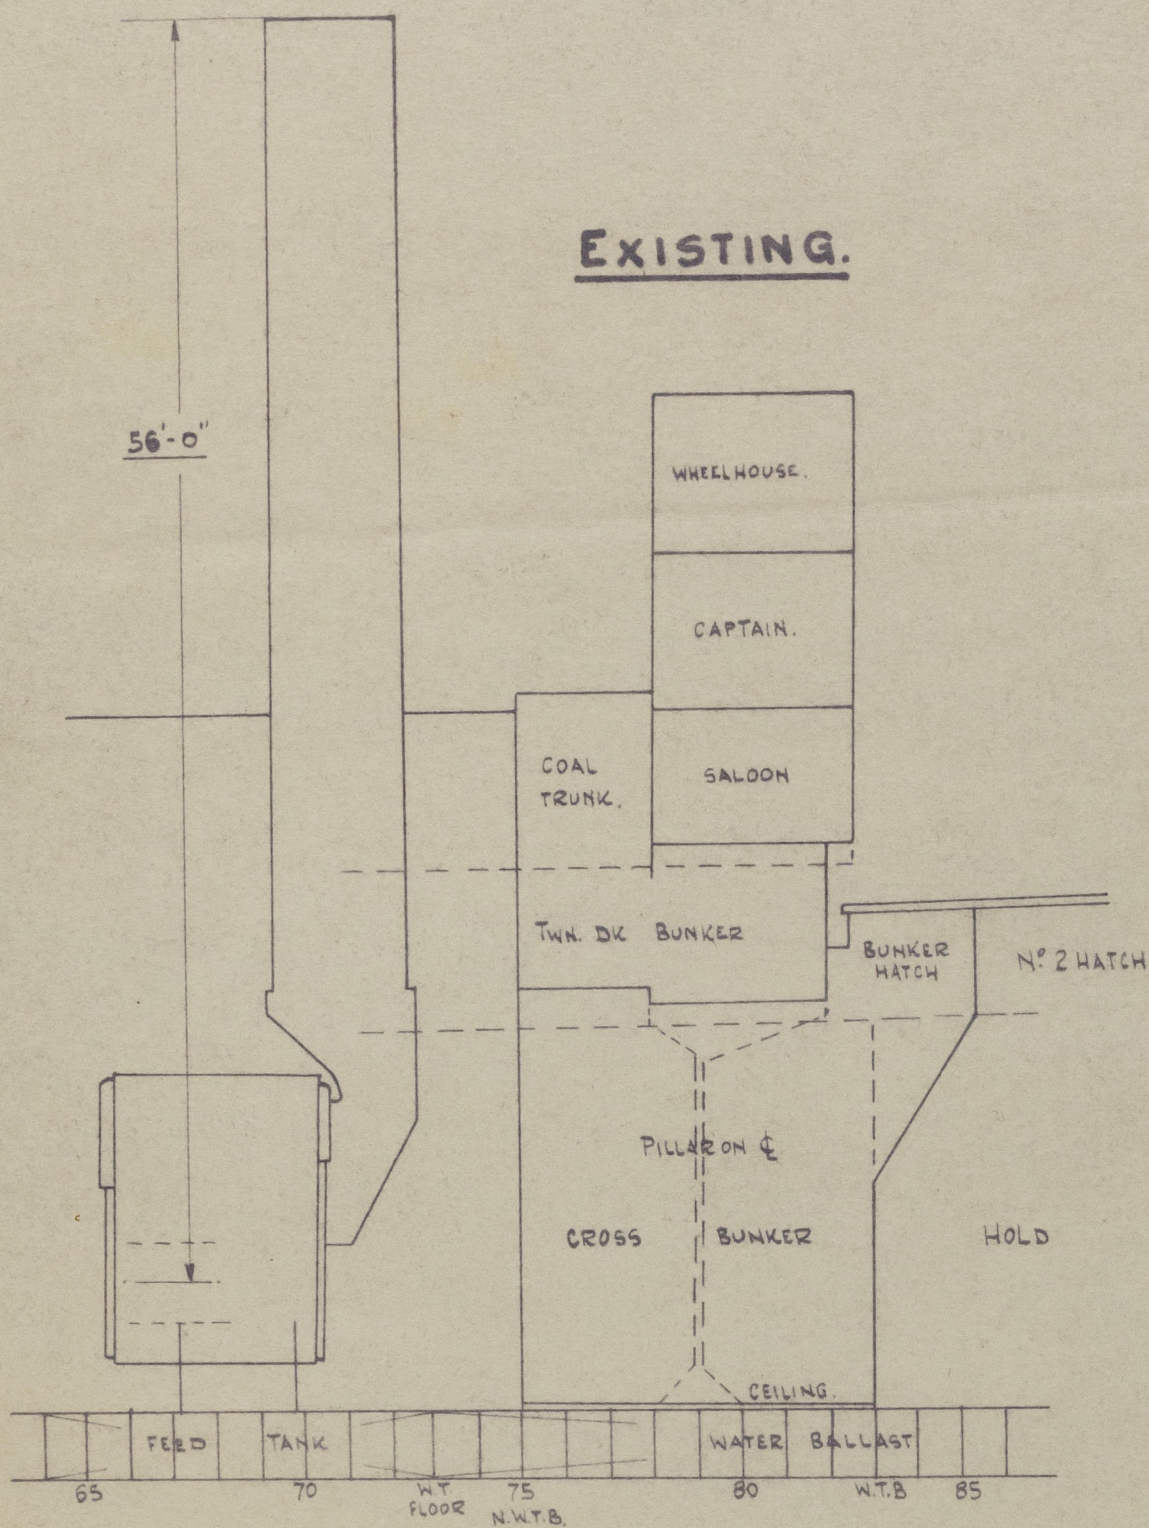


BRIDGE DECK

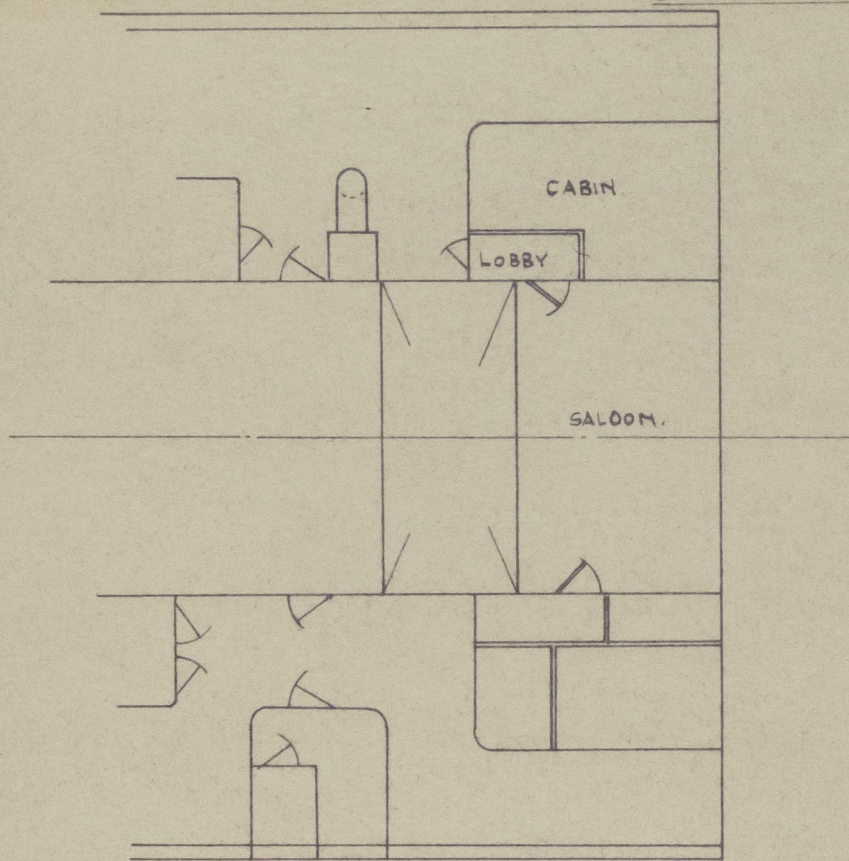


MAIN DECK

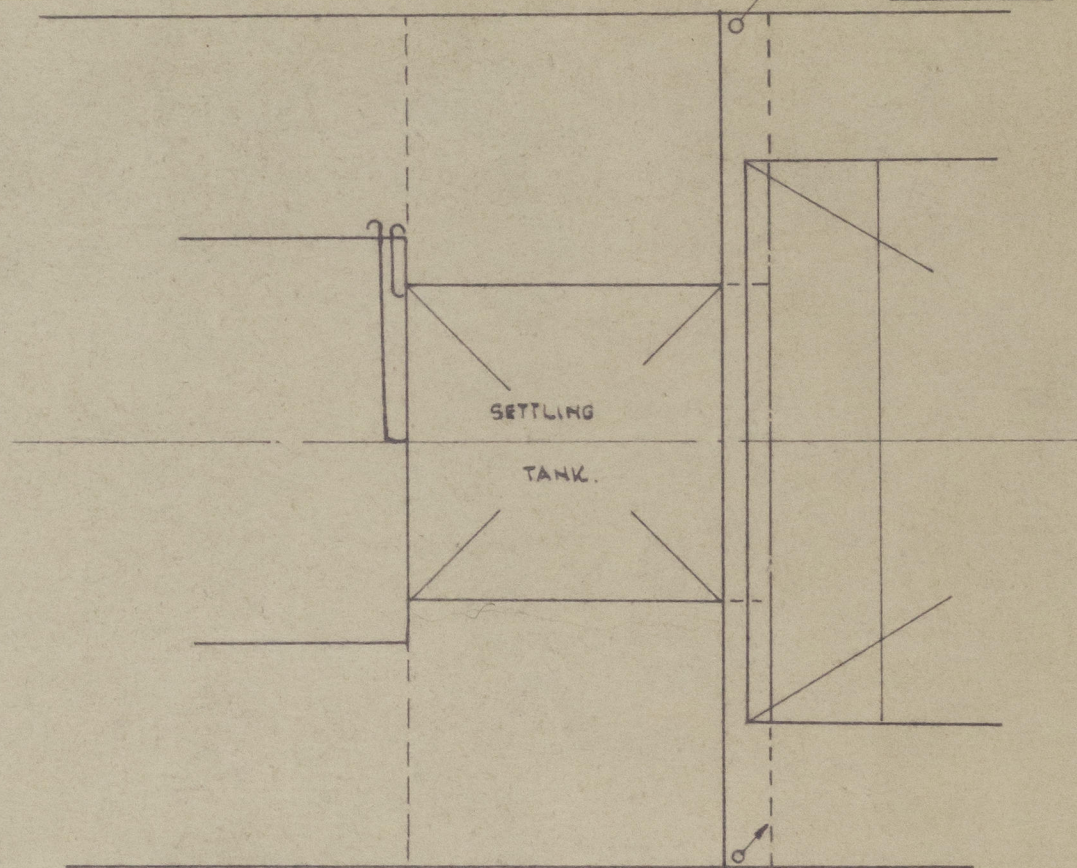

MAIN DECK

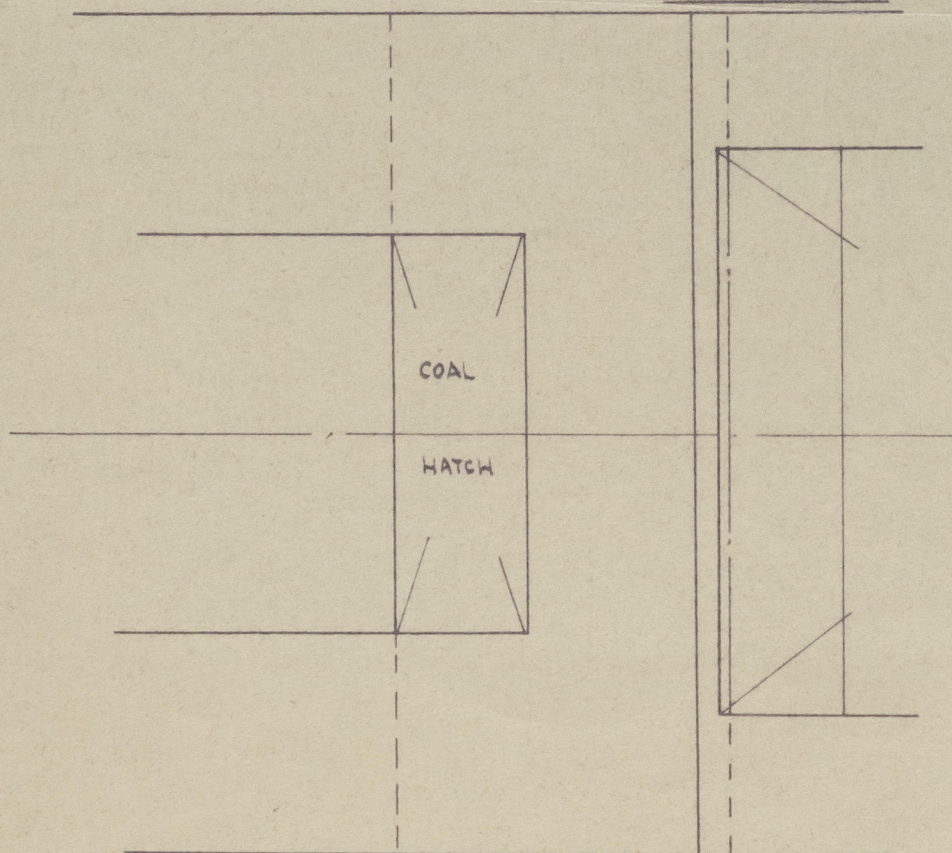

TANK TOP.

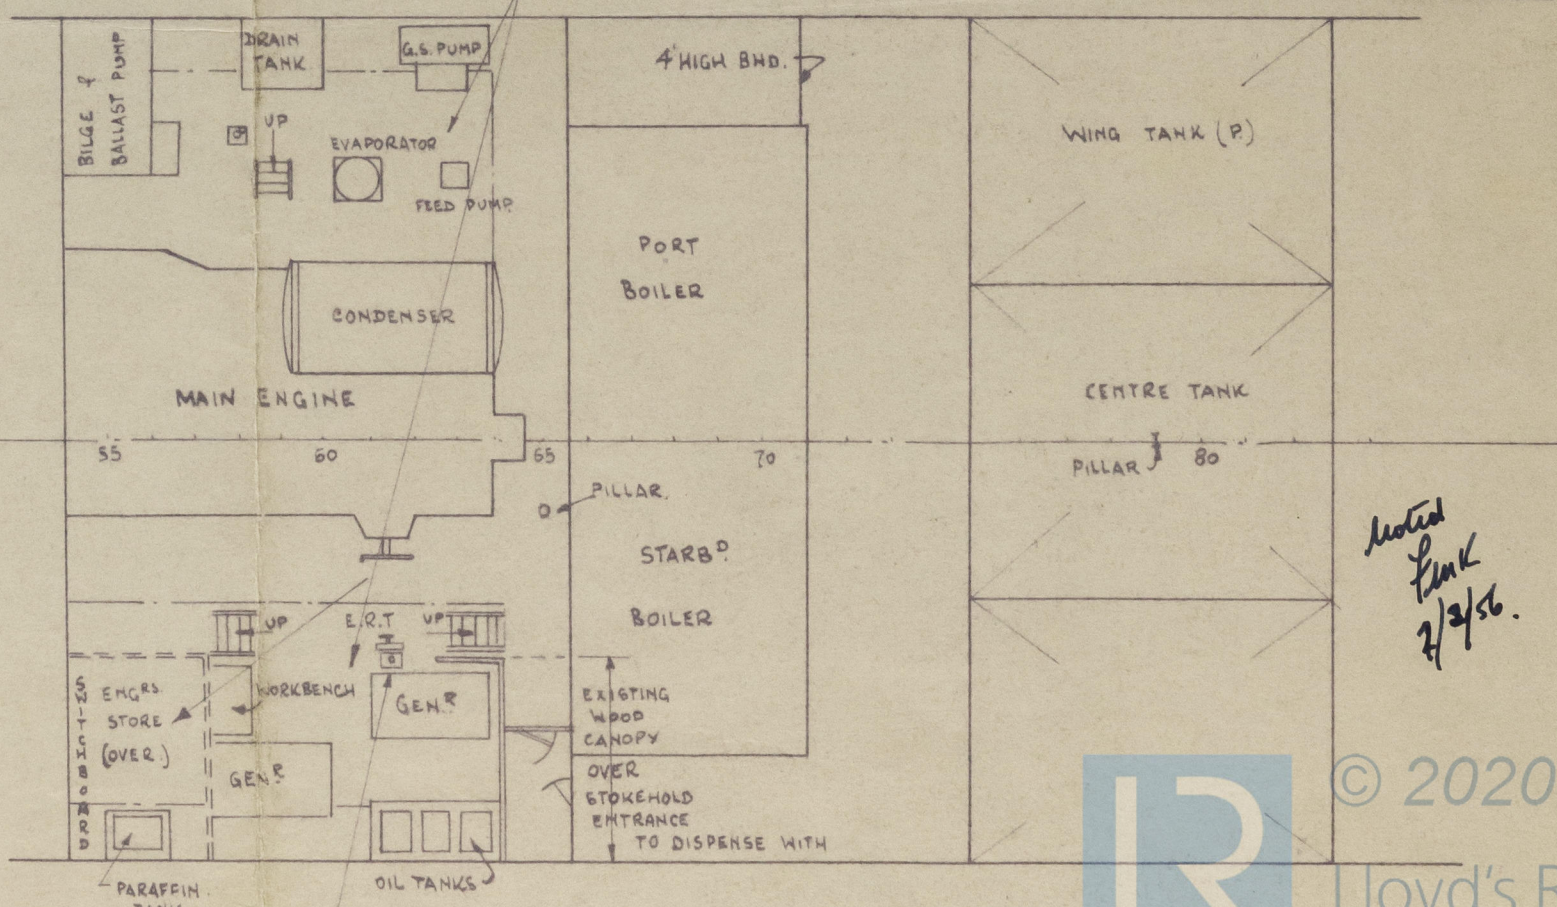

EXISTING.

WOOD STRUCTURE SHOWN IN RED.

EXISTING WOOD PLATFORM, ENGRS STORE & STRUCTURE IN WAY OF STOKHOLD ENTRANCE TO STRIP OUT & DISPOSE OF. NEW STEEL PLATFORM & STORE TO CONSTRUCT

Noted Link 2/2/56.



© 2020

Lloyd's Register Foundation

003434-003443-0284

"Kylqueen"

Ant 31139

Proposed Oil Fuel Conversion



© 2020

Lloyd's Register
Foundation

003434-003443-0284