




003434-003443-0289 1/2



003434-003443-0289 1/2

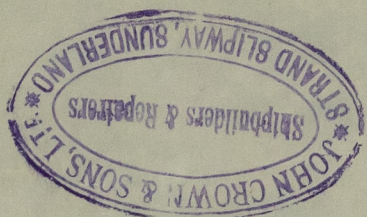

© 2020

Lloyd's Register
Foundation

J. CROWN & SONS, LIMITED, SUNDERLAND.

ENCLOSURE
FOR

Messrs
Lloyds Lunnerys.

0289 2/2

SUNDERLAND

MESSRS J. CROWN & SONS

S/S "SPRIGHTLY" (No 142)

MIDSHIP SECTION (AS BUILT)

BUNDERLAND RPT. No. 28560.

Transferred to Kylequeen



© 2020

Lloyd's Register
Foundation

003434-003443-0289 1/2