

GENERAL ARRANGEMENT OF TWIN SCREW MOTOR VESSELS


SCALE 1/16" = 1 FOOT

DIMENSIONS

LENGTH: FROM FORE PART OF STEM TO AFTER PART OF
STERNPOST ON RANGE OF 28 FT WATERLINE 453' 6"
BREADTH MOULDED 59' 0"
DEPTH MOULDED TO UPPER DECK 35' 3"

8 JUN 1929

Handwritten:
15.6.29

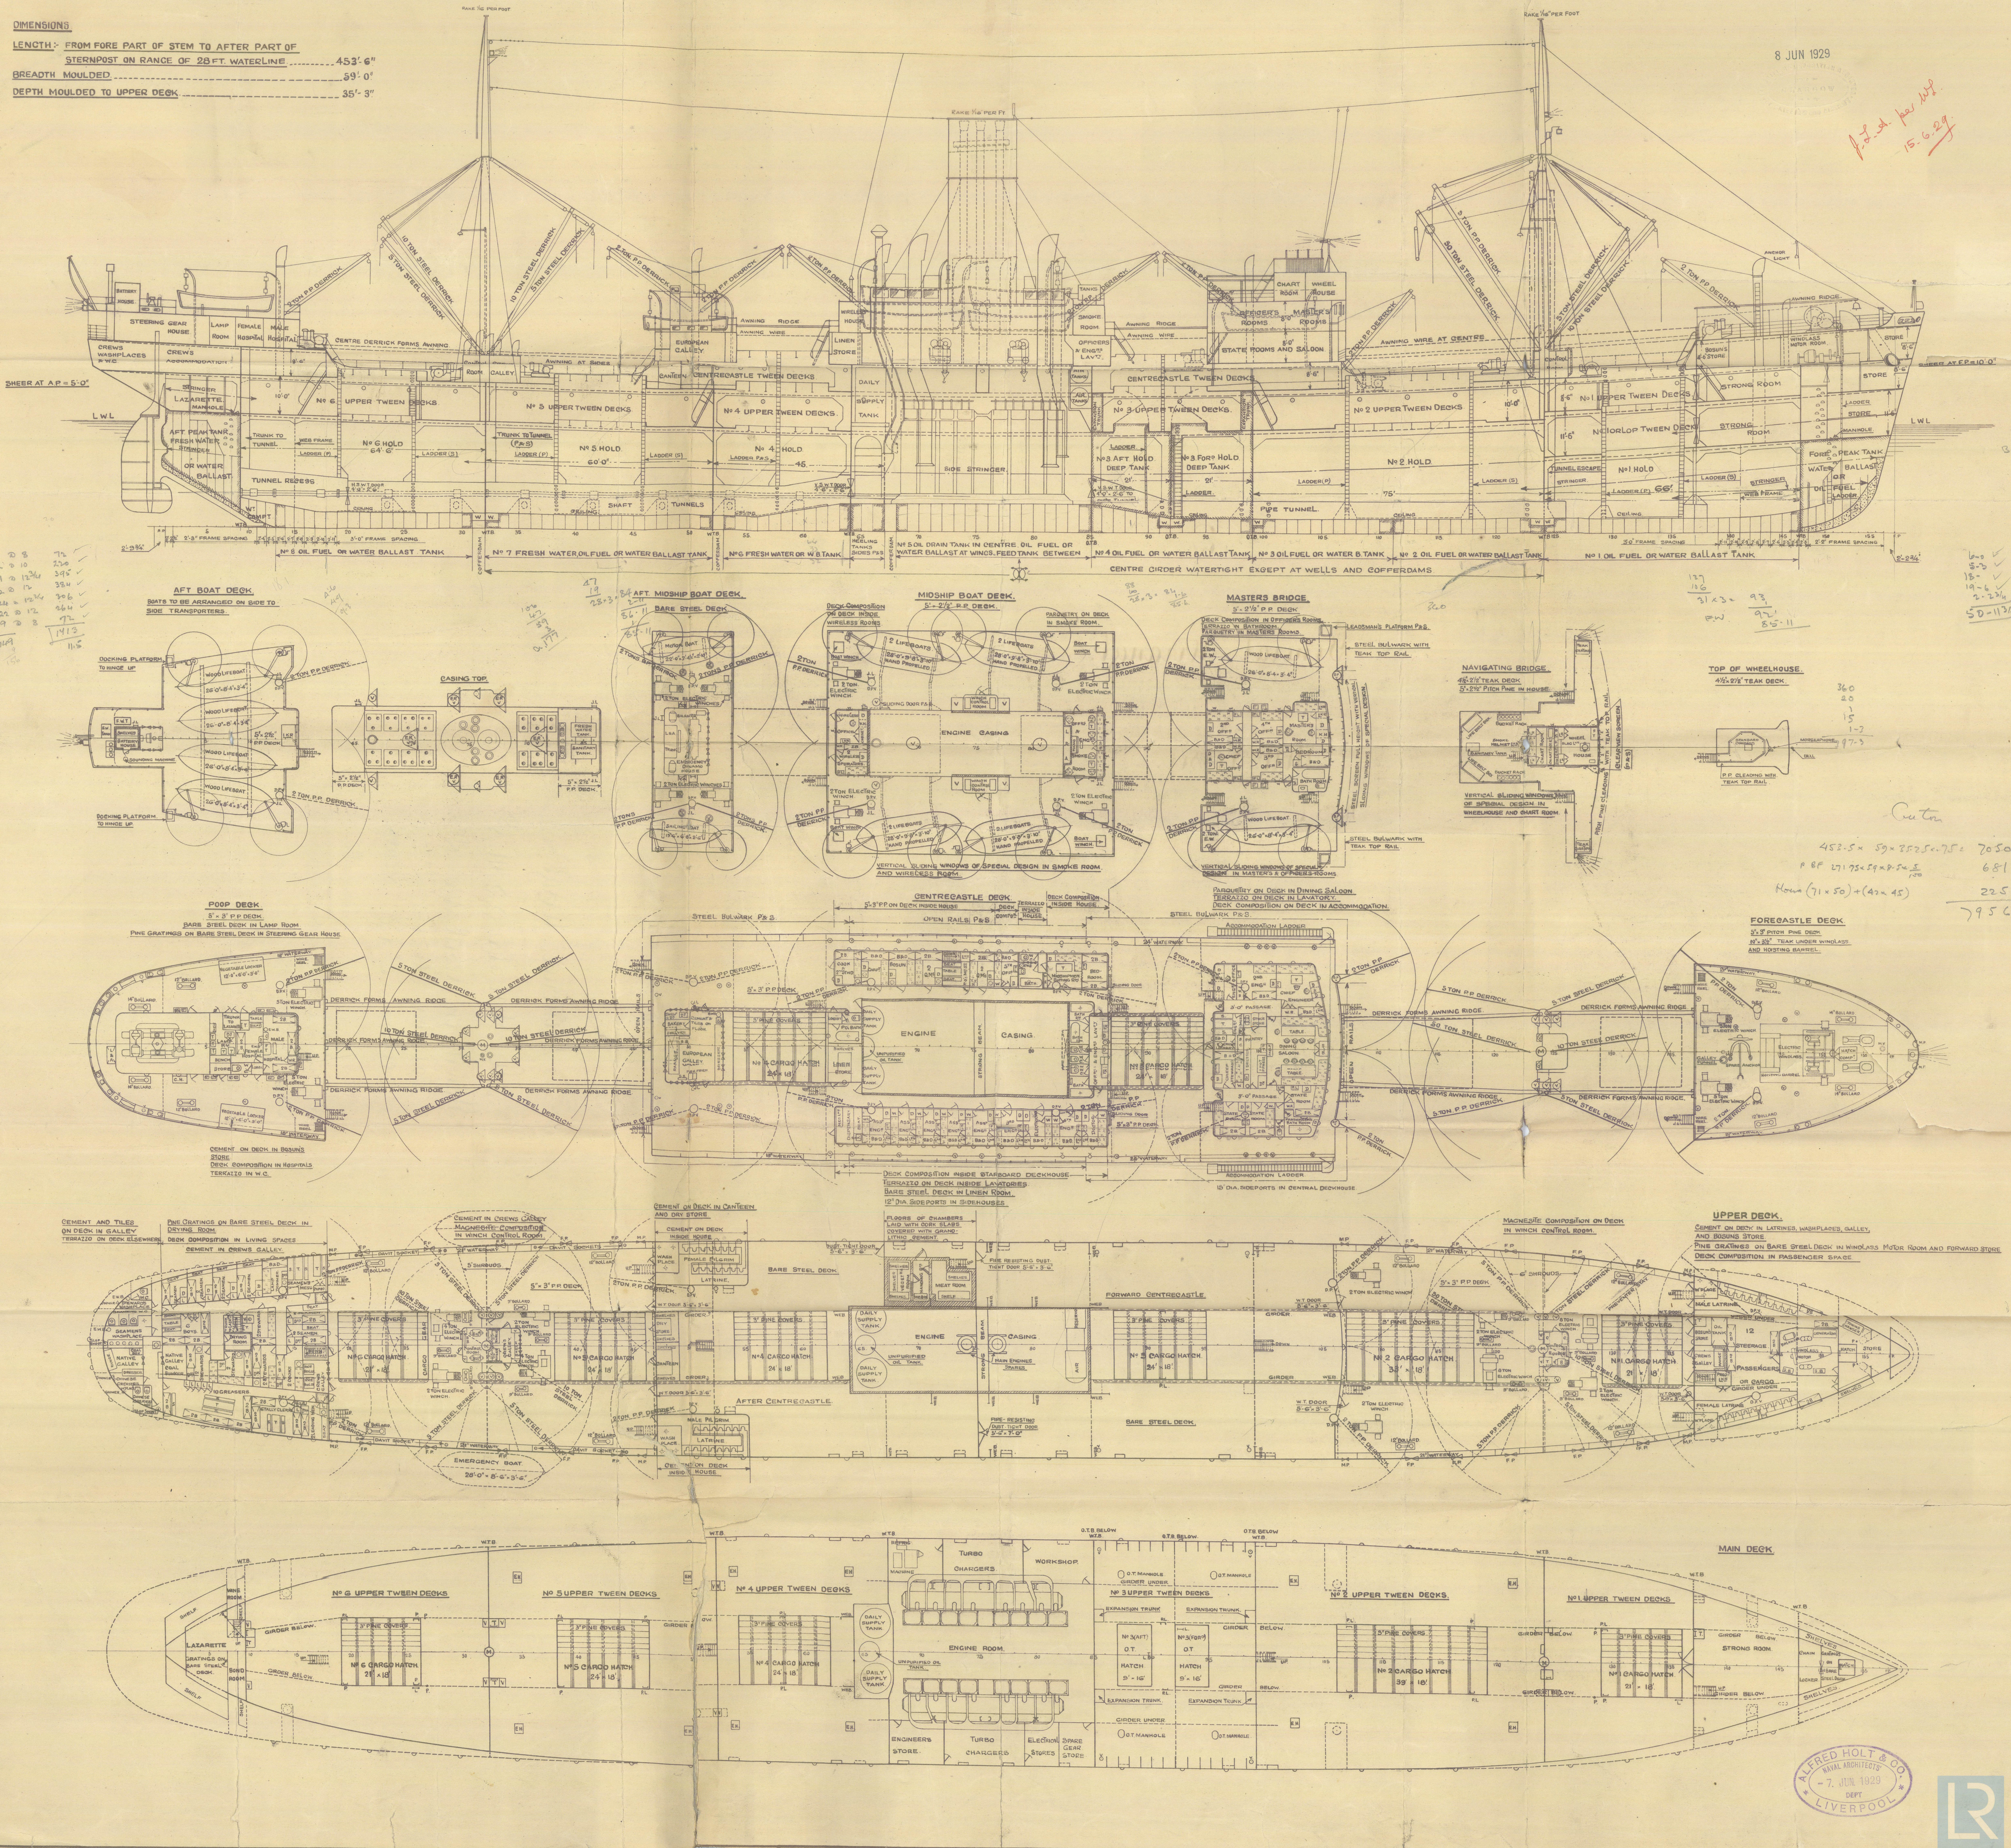

Handwritten:
453' 6"
59' 0"
35' 3"



2
RECORDS DEPT.
LONDON

General Aargt. 1

A. Holt also S.S.M. N^o.

Hawthorn Leslie also N^o 568.

Caledon S&C Co. N^o 334.


Scott's S&C Co. N^o 548.

12 - 6 - 29.

H.L. & Co. "DEUCALION"

CALEDON "MEMNON"

SCOTT'S "AJAX" ★

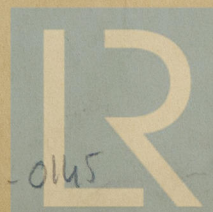

© 2020

Lloyd's Register
Foundation

003444-003449-0145

2

General Arrangt.
Galedon S&W Co. N°
Holt Nessel.

453'-6" x 59'-0" x 35'-3"

H. L. Leo
Caledon.

15-6-29.

003444-003449-0145

453'-6" x 59'-0" x 35'-3"

General Arrangt.



© 2020

Lloyd's Register
Foundation