

11 OCT. 1933

Lloyd's Register of Shipping.

(Report on Vessel No. 44347, Port Hull)

Lady Adelaide.

No.

SHIP FORGINGS OR CASTINGS.

I have to report that the undermentioned Iron or Steel Forgings or Castings, manufactured by Messrs T. S. Forster & Son Ltd. of Sunderland for the Vessel No. 586, being built by Messrs Cook, Welton & Gemmell, Beverley have been inspected by me as set forth below and found to be, so far as can be seen, Sound.

Mark on Forgings or Castings.

Lloyd's


No. 7041

J.D. 10.9.33

J. Dale
Sunderland

	STERN FRAME.	RUDDER FRAME.	STEM.
Material*	Scrap iron		
How made	Forged & Smithed		
If annealed			
Dimensions	6 x 3 3/4		
Progress on Inspection	Forging & Smithing		
Date when Inspected	10.9.33		
CASTINGS.			
Tests on Standard Test Pieces.			
Tensile Test—			
Tons per square inch			
Extension per cent.			
Cold Bending Test—			
Angle before fracture			
Drop Test—			
Height from ground			
Hammering Test—			
If made according to Rules and found satisfactory			

SKETCHES OF FRAMES SHOWING POSITION AND DESCRIPTION OF WELDS OF FORGINGS.

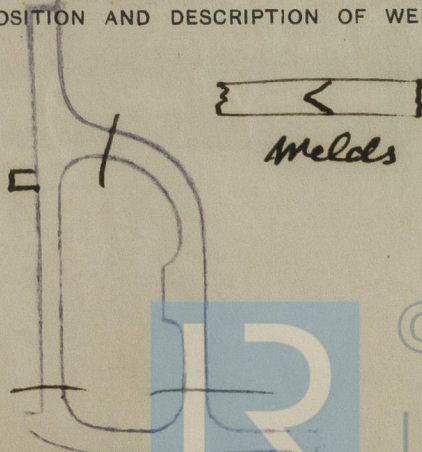

Fee (if any chargeable) £

To be paid at

* If of Iron, state whether scrap or puddled Iron. If of Steel, state whether made on the Open Hearth process.

