


US Fernland

Jan. 6-52

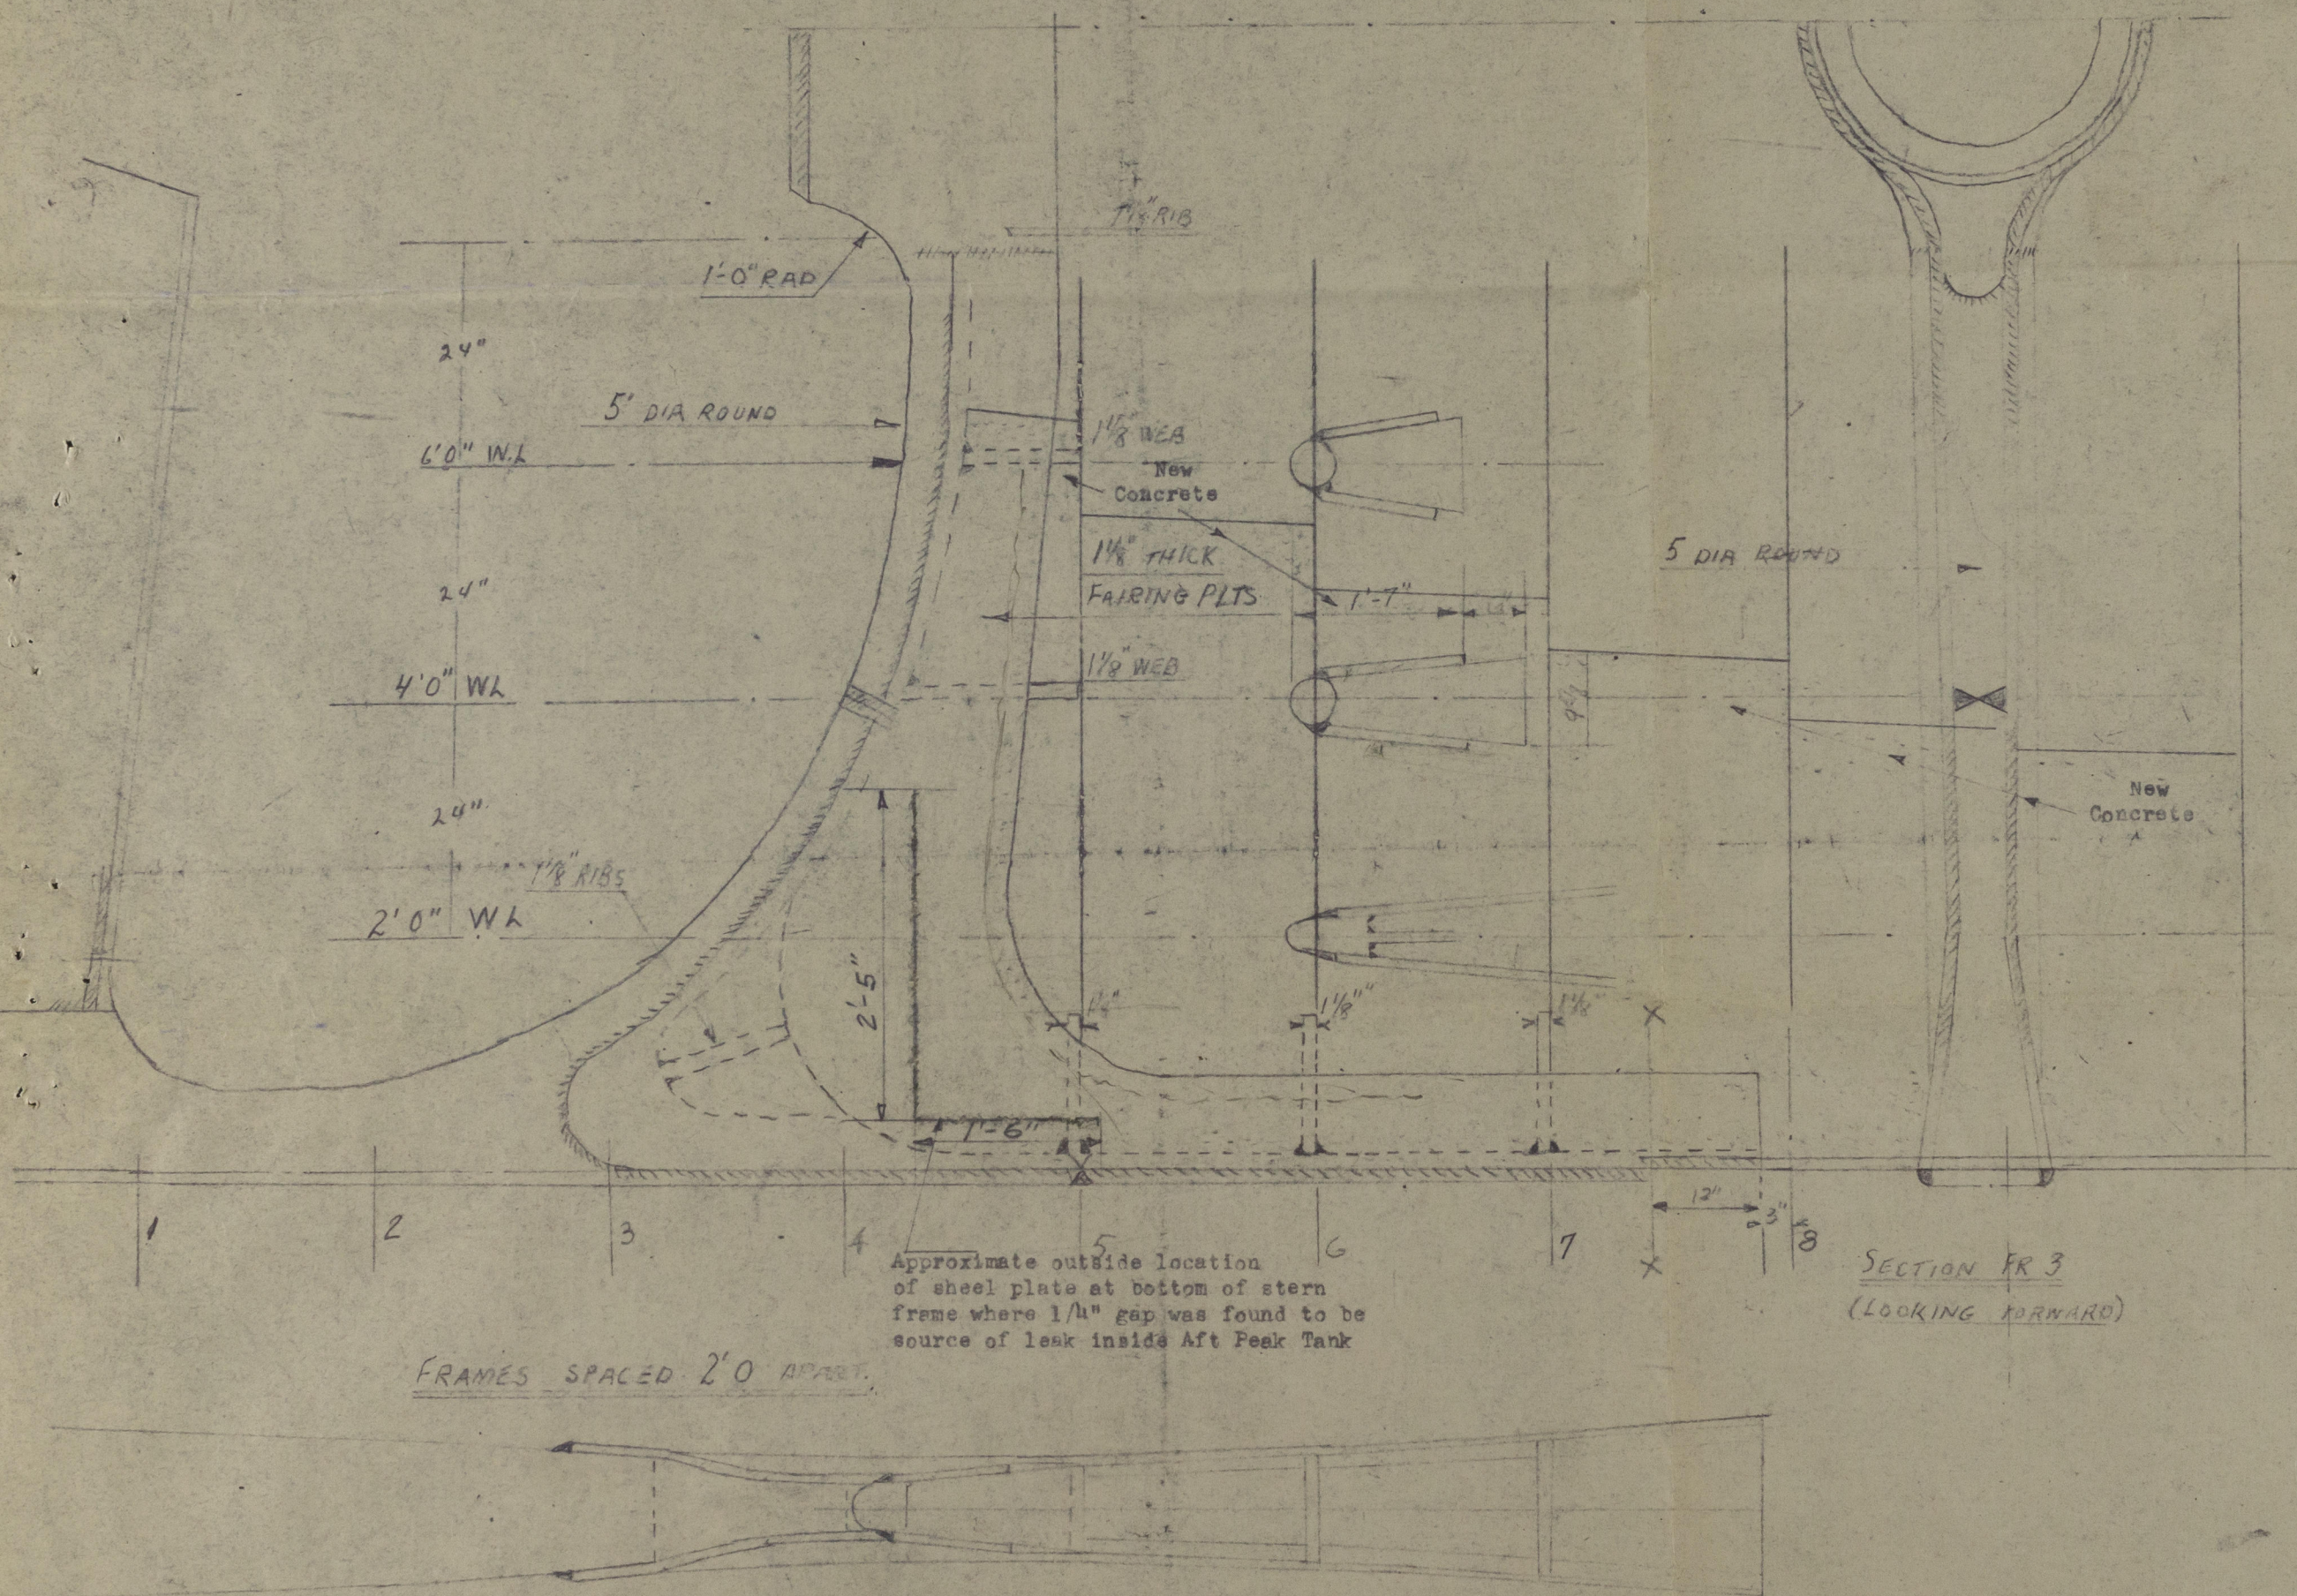

SECTION FR 3
(LOOKING FORWARD)



© 2020

Lloyd's Register
Foundation

003458-003465-0219

24 MAR 1952

Rpt. Man. No. 3725

003458-003465-0219

003458-003465-0219

TO ACCOMPANY Man REPORT NO. 3725
DATED Jan. 52



© 2020

Lloyd's Register
Foundation