


TONNAGE PROFILE

No 503
TONNAGE PROFILE
SCALE - 1" = ONE FOOT

5 JUL 1929
REGISTERED
CLARK
ENGINEERS
BELFAST

 

SPARRING: 6"x2" VERTICAL CARGO BATTENS SPACED NOT LESS THAN 4' APART IN ALL HOLDS AND TWEEN DECKS BELOW UPPER DECK. ALSO IN STRONG ROOMS FORE.


SPARRING: 6"x2" VERTICAL CARGO BATTENS SPACED NOT LESS THAN 4' APART IN ALL HOLDS & TWEEN DECKS BELOW UPPER DECK. ALSO IN STRONG ROOMS FORE.

Handwritten calculations:

40.00	8.00	48.00	✓
15.00	1.00	16.00	✓
32.00	1.00	33.00	✓
24.00	1.00	25.00	✓
20.00	1.00	21.00	✓
10.00	1.00	11.00	✓
AV	167.4	167.4	✓

Handwritten calculations:

44.00 x 1.00 = 44.00
2.00 x 1.00 = 2.00
42.00

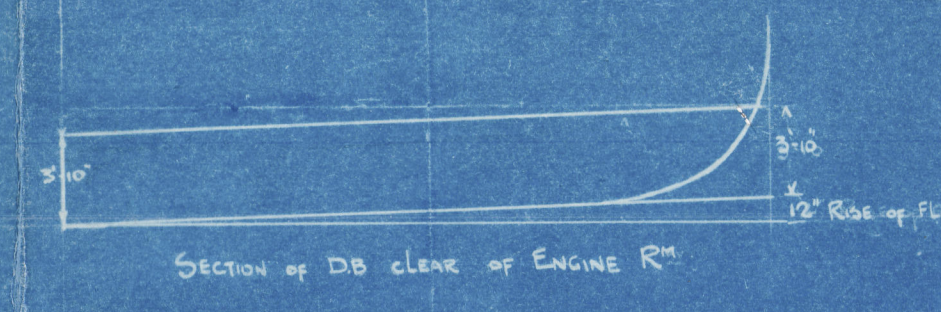


Handwritten calculation:

$$\frac{100}{27} \times 2 = 7.4$$



Handwritten calculation:

$$\frac{7.10}{2.10} = 3.38$$

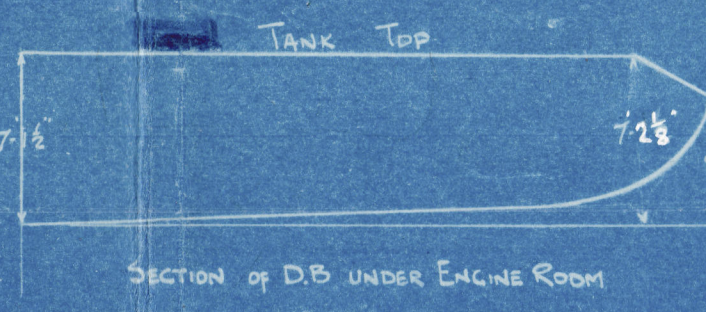

Handwritten calculation:

$$2.00 \times 2.00 \times 4 = 16.00$$

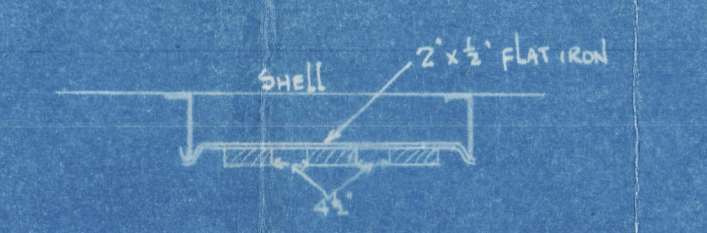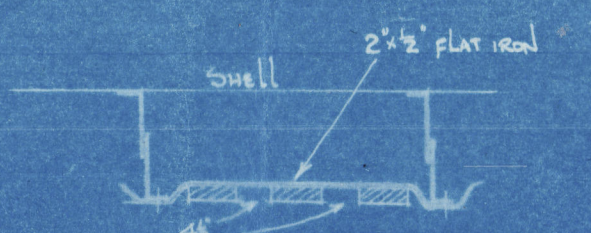

WILLIAM CLARK (INCORPORATED)
ENGINEERS
BELFAST
3 JUL 1929
Lloyd's Register
Foundation
003467-003473-0208

Tonnage Profile
for Fairboard.

W. & S. 503.

Bag

003467-003473-0208



© 2020

Lloyd's Register
Foundation

8

RECORDS DEPT.
LONDON

8

Freeboard Profile
Workman Clark, Ltd

Nº 503.

Reference.

"Agamemnon"



© 2020

Lloyd's Register
Foundation

003467-003473-0208