



LENGTH : FROM FORE PART OF STEM TO AFTER PART OF
STERNPOST ON RANGE OF 28' WATERLINE. 452'-0"
BREADTH MOULDED----- 59'-0"
DEPTH MOULDED TO UPPER DECK----- 35'-3"

15-8-28

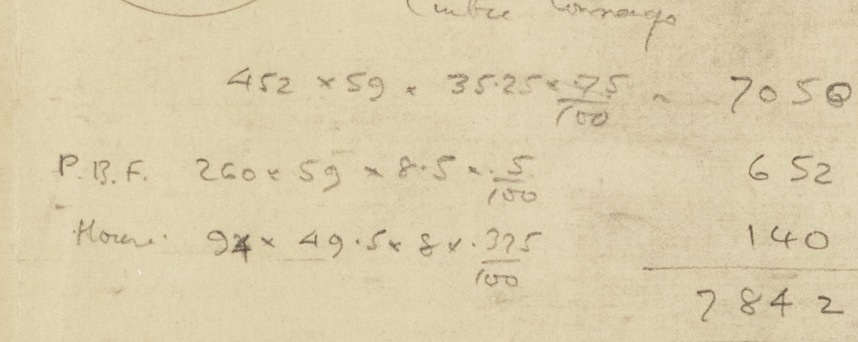

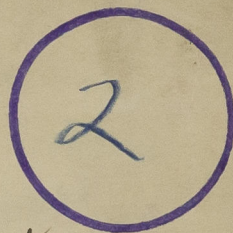

General Arrangement.

~~Prop.~~ Holt. Vessel. 45'2" x 59' x 35'3"

Appd. 15-5-28.


Caledon S & Co. N^o 326.

Workman Clark Ltd N^o 503.

326. "Menestheus"

503. "Agamemnon" ★

RETAIN

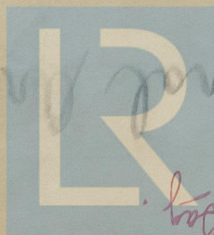

© 2020

Lloyd's Register
Foundation