


SS BARON STRANKAER
STIFFENING TO RUDDER.

STAR^d RUDDER PLATE RENEWED
FOR^d RUDDER FRAME SECTION 1⁵/₈ x 4' RENEWED AS IN RED.

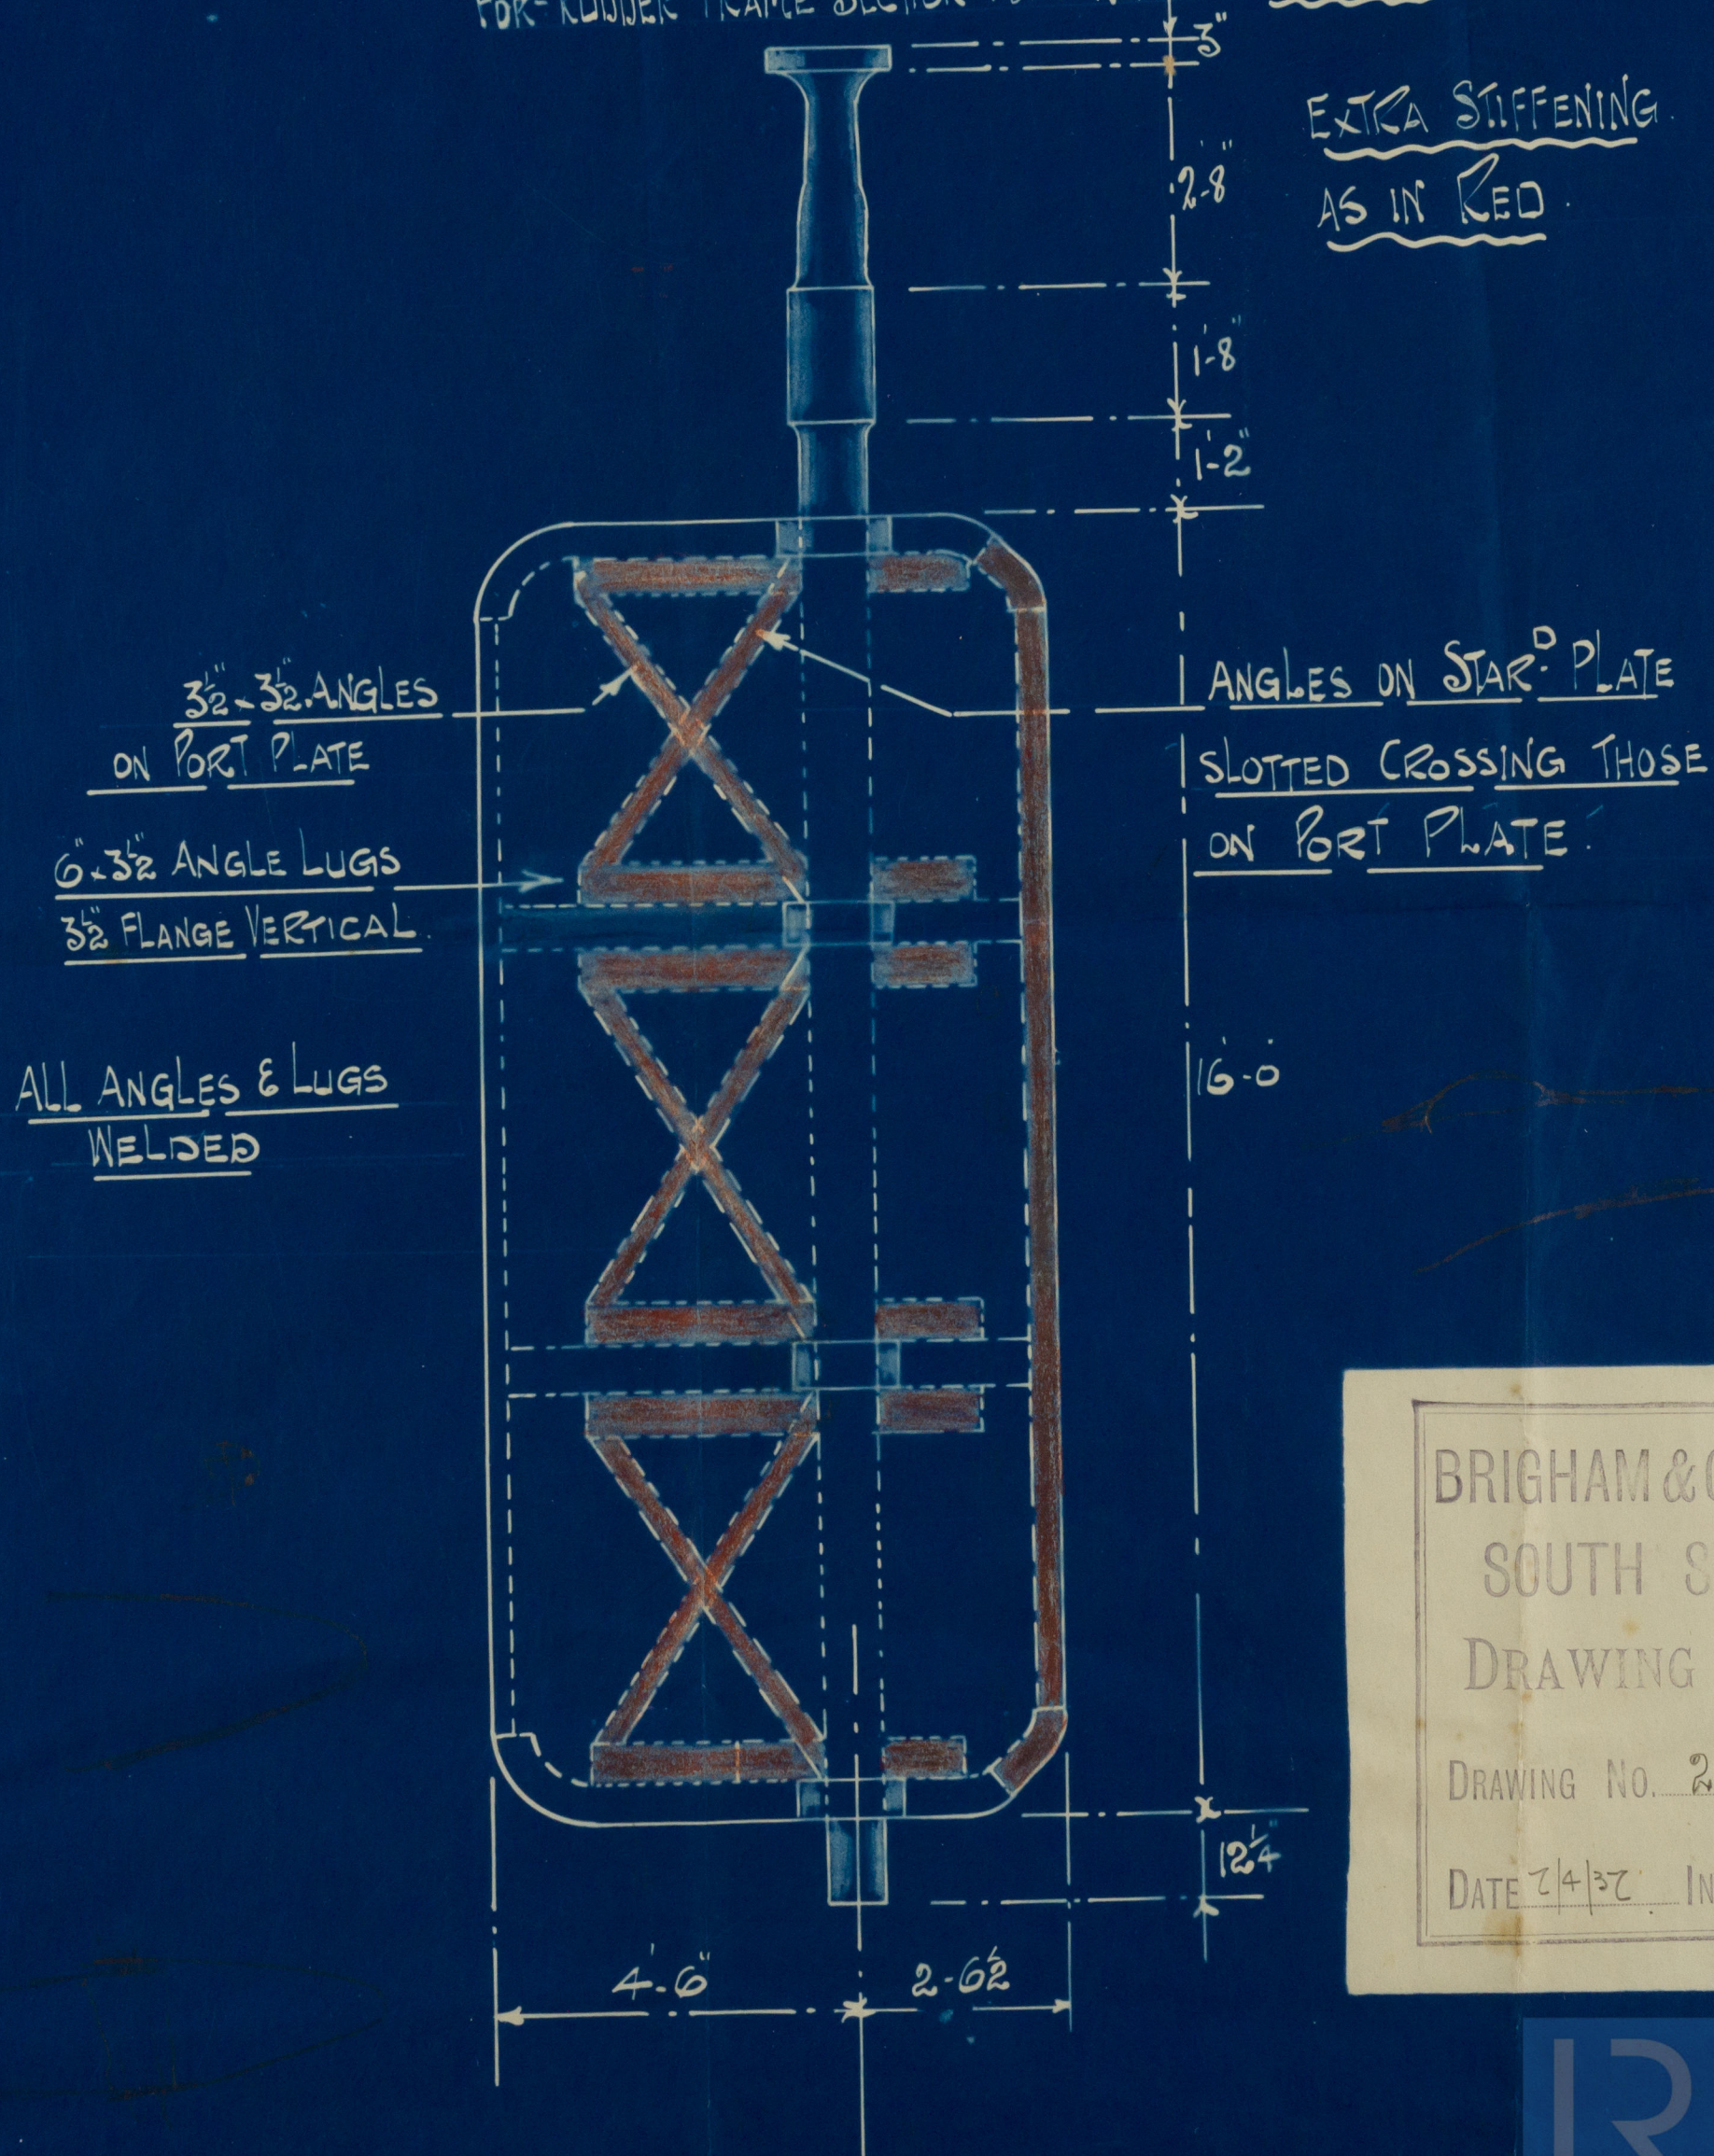

BRIGHAM & COWAN, L^{TD}
SOUTH SHIELDS.
DRAWING OFFICE.

DRAWING No. 209.

DATE 7/4/37 INITIAL

- 48 Baron Struace -

- Rudder Repair -

4/37



© 2020

Lloyd's Register

003474-003478-0071
Foundation