


ARRANGEMENT TO BE SUCH THAT
LOSS OF ALL NUTS IS PREVENTED

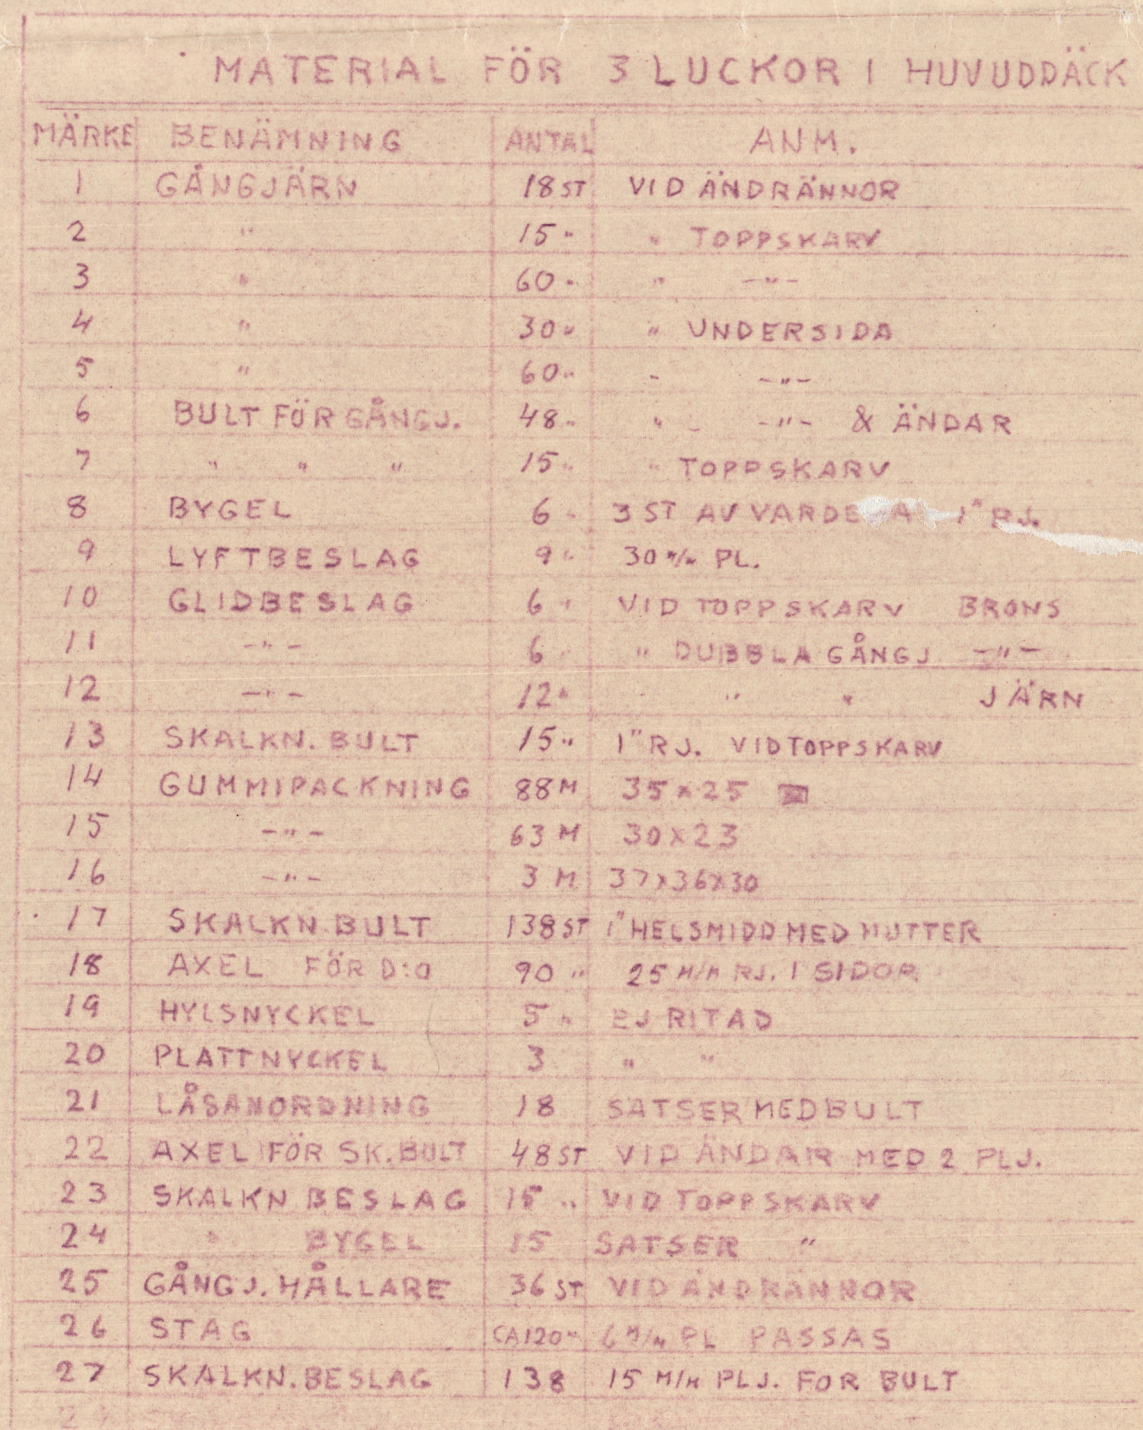

NYB. 49 SÖLVESBORGS VARVS & RED. A.B.

SKALA: 1:100, 1:

10.12.1956

10

1:10, 1:5, 1:2

003494-0278


Mahmöö.

Söbörborgs Varvs- & Rederi A.-B.

Steel hatch, Tollo Patent.

(Mahmöö Trade. Regt. No. 3724
of the 17/12-1957)

RECORDS DEPT.,
LONDON.

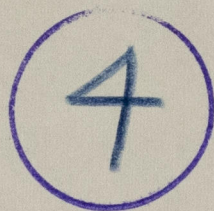

003487-003494-0278



© 2020

Lloyd's Register
Foundation