


RODDER HEAD TOP

$\phi 145$

BUSHING STAINLESS STEEL

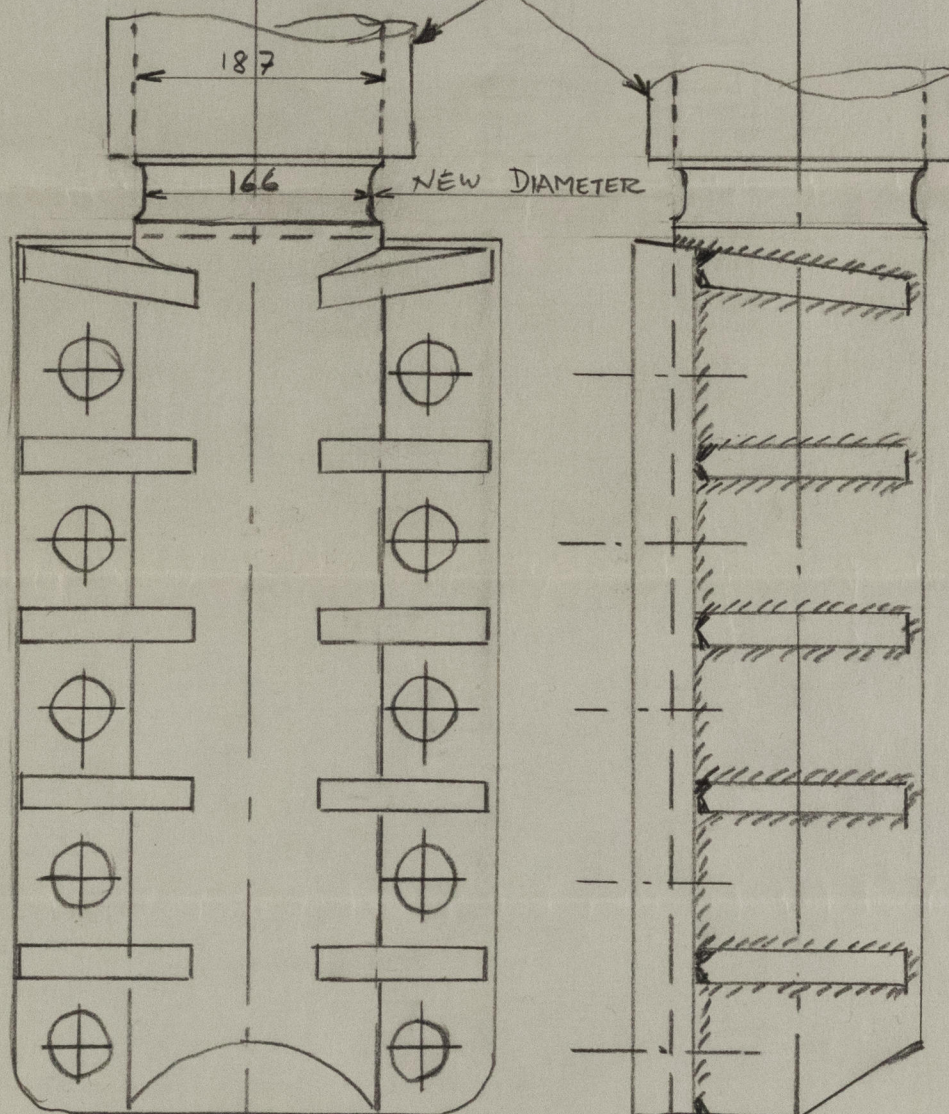

$\frac{1}{8}$ " OFELIA⁴

GOT REPORT 27201

REPAIRS TO RUDDER HEAD

003487-003494-0291

© 2020

Lloyd's Register
Foundation