

Nº 37

S.S. MAR TIRREÑO

PROFILE

To Class 100A.1 at Lloyd's Awdg. deck


316'-0" B.P. x 44'-2" x 22'-7" M.D.

U.D. Tonnage about 3,120 Tons.

Scale 1/8" = 1 Foot

COMPANIA EUSKALDUNA  
DE CONSTRUCCION Y REPARACION DE BUQUES  
BILBAO  
DIBUJO Nº 1  
FECHA 21-8-16.

3-9-15

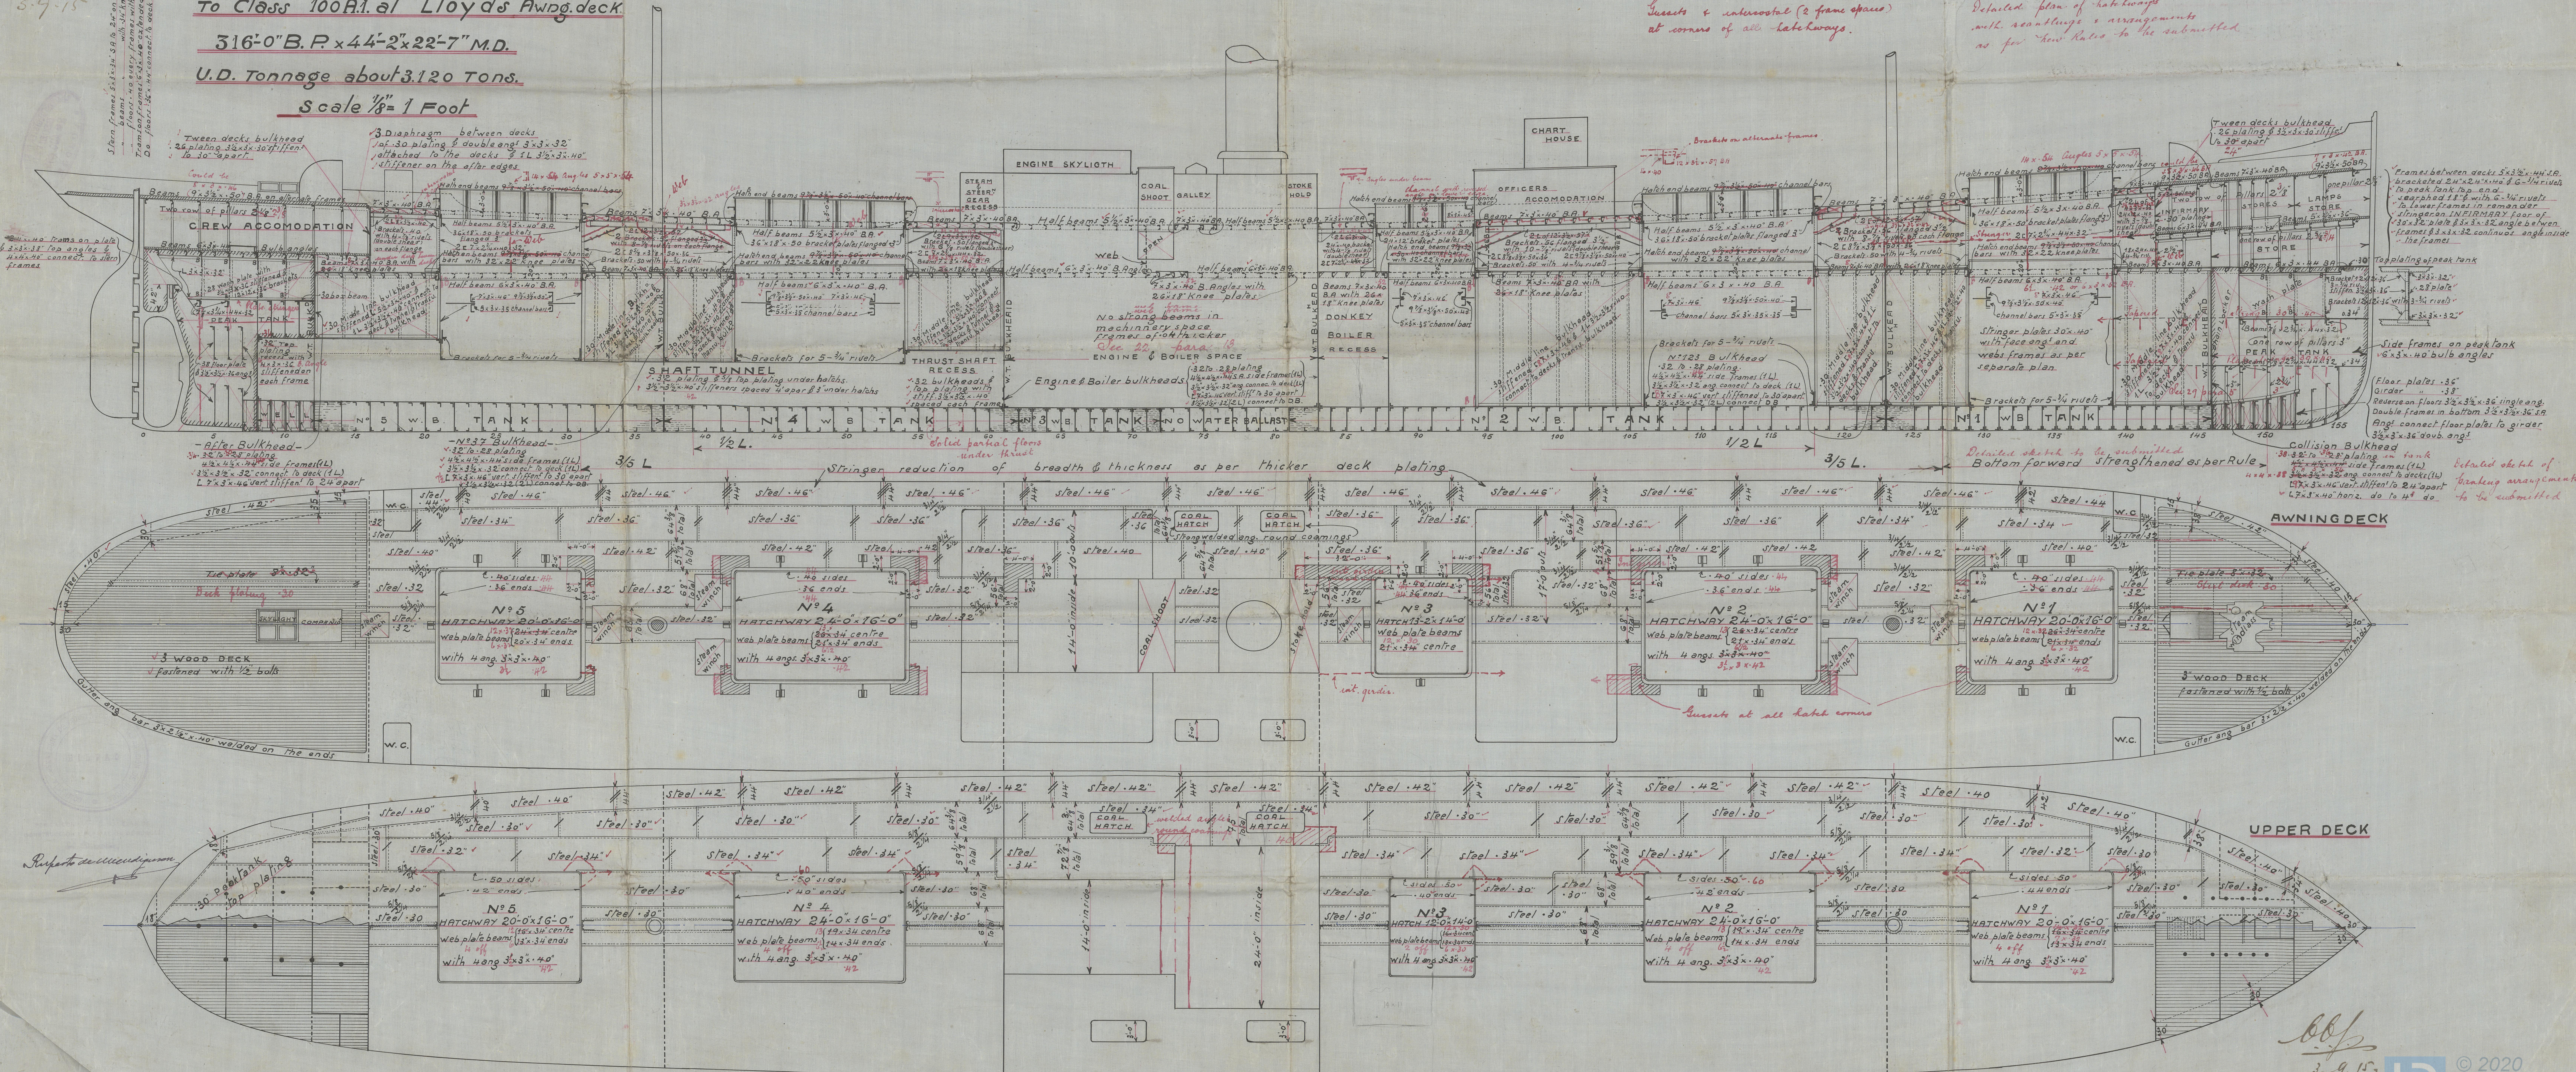

S/S "Max Lirreno"  
Rbo 4971

Labo Pro




© 2020

Lloyd's Register  
Foundation

003495-003502-0015