


OIL TIGHT BULK² 14'-0" FROM CENTRE
LOOKING FROM CENTRE

SECTION

DETAIL OF WASH PLATE

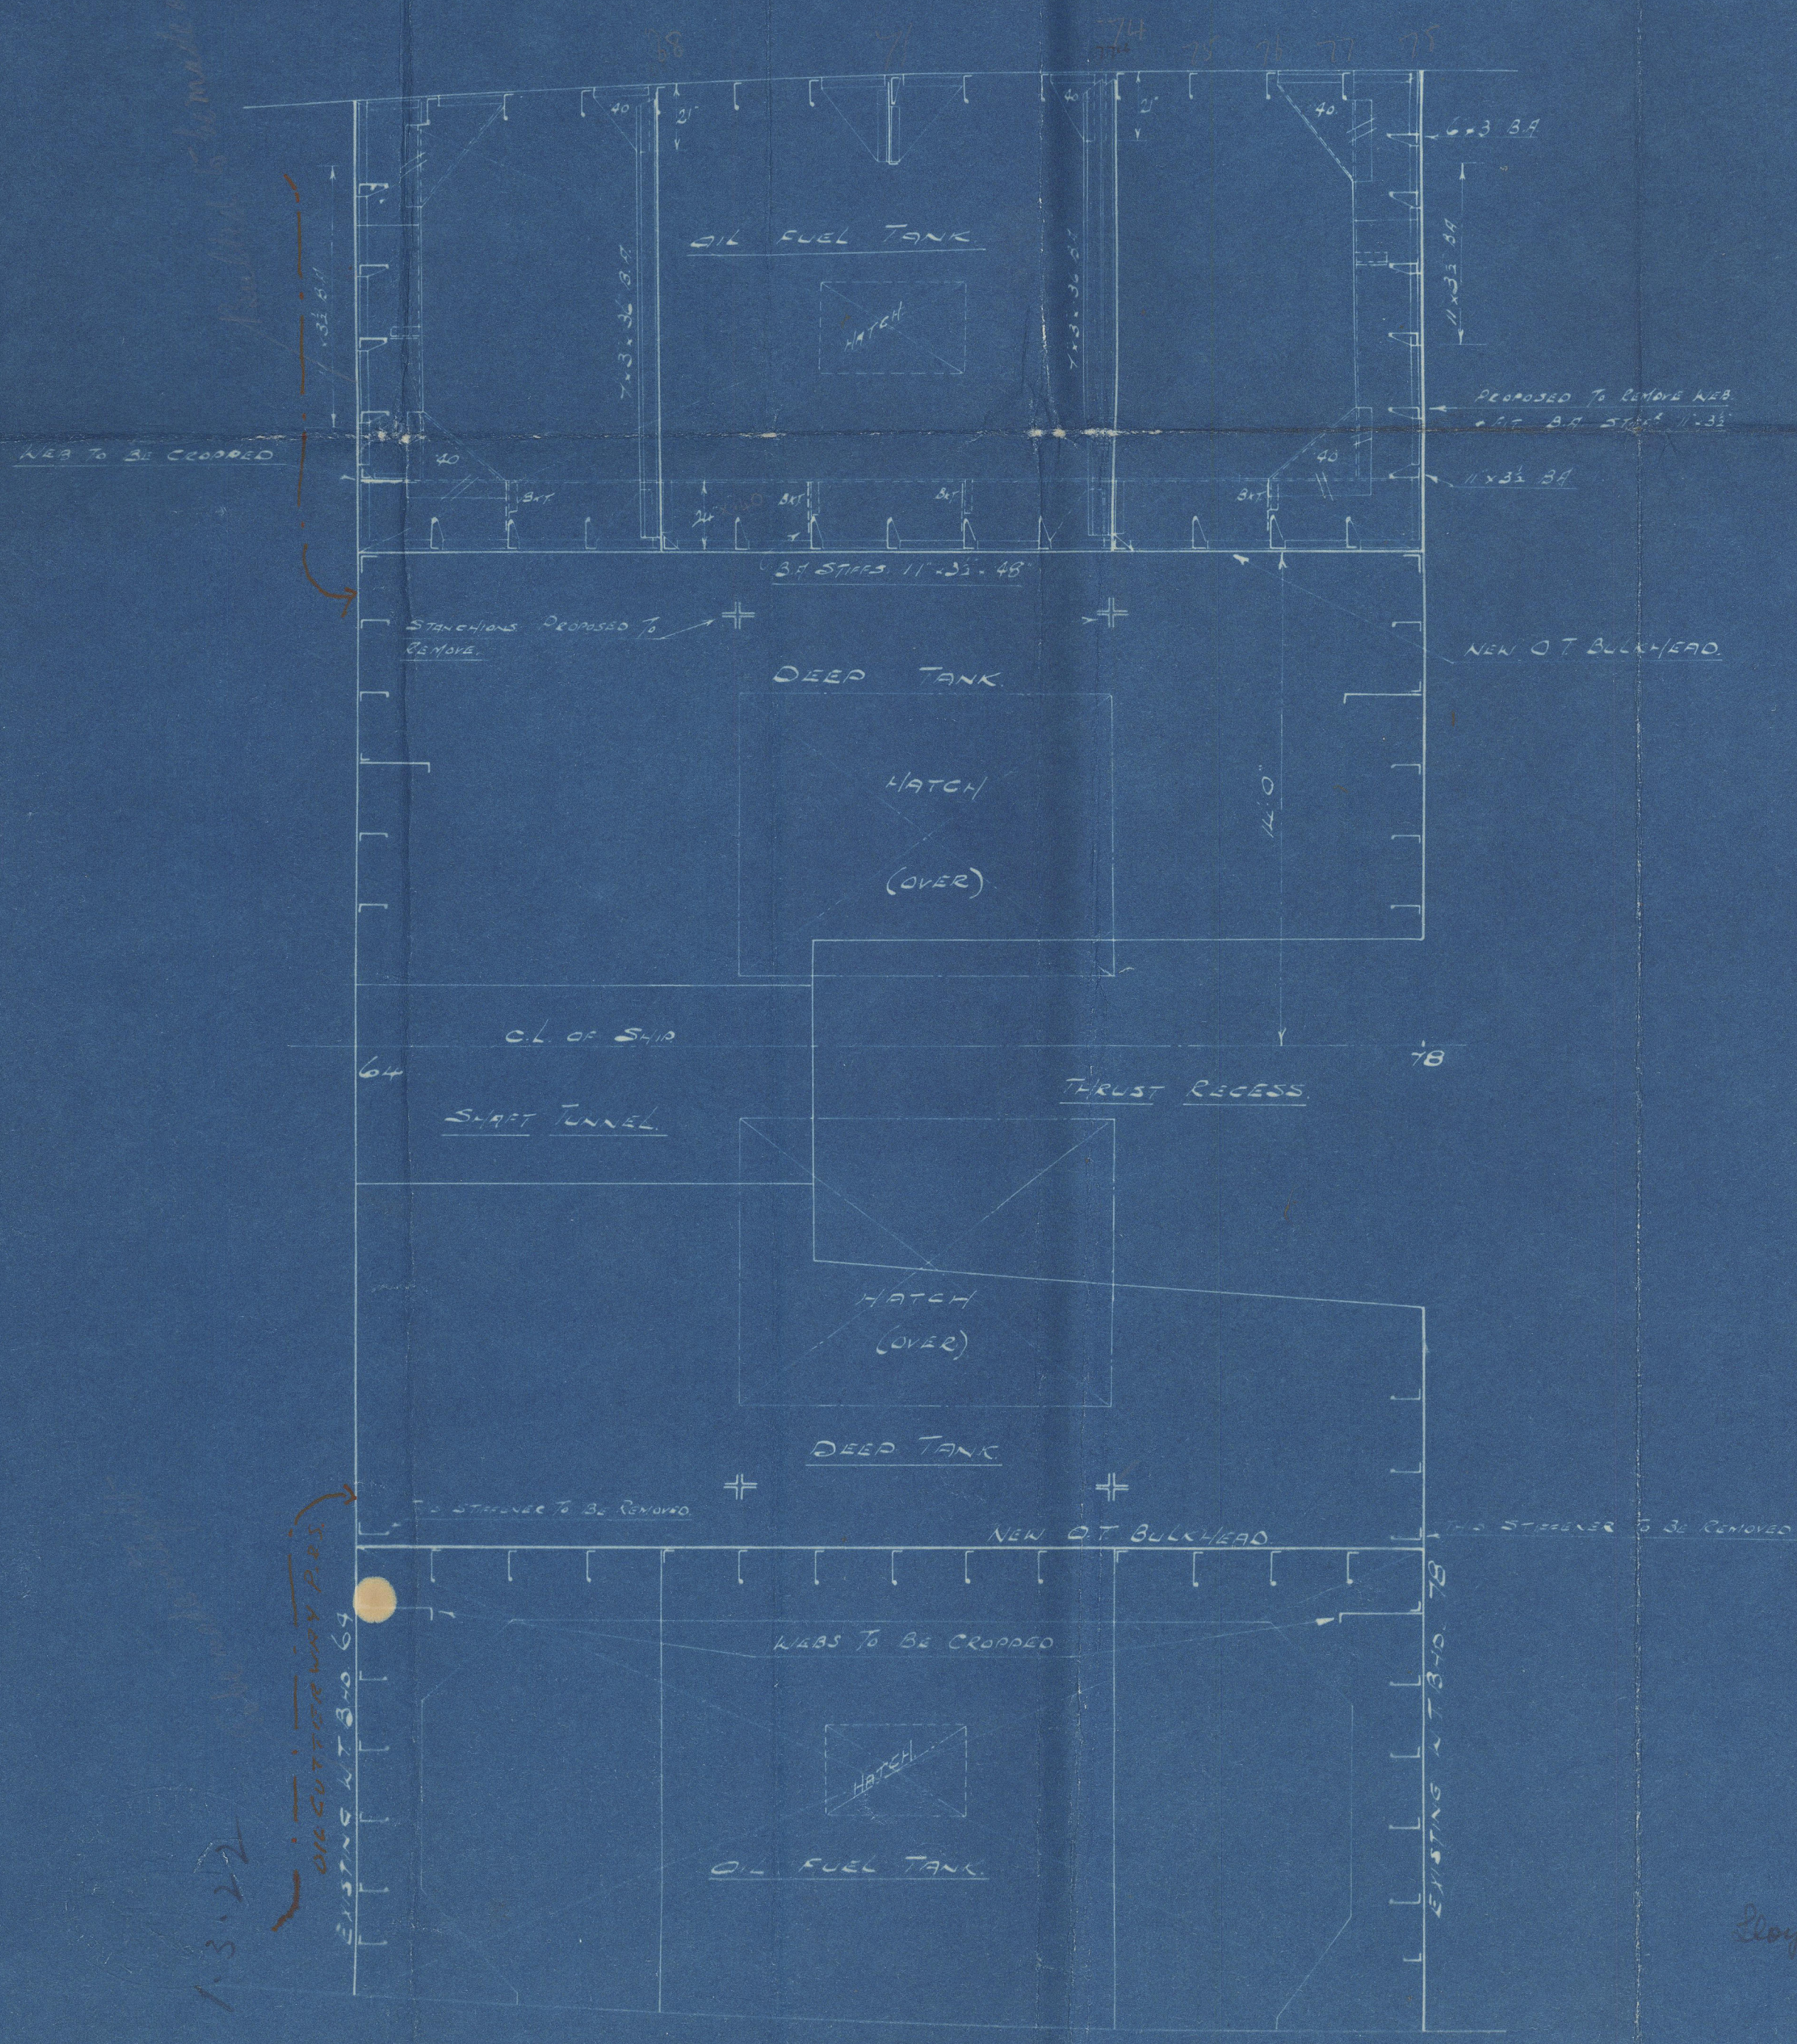

S.S. REXMORE

PROPOSED O.T. BULKHEADS IN AFT DEEP TANK


SCALE 1/4" ONE FOOT

RIVETING - STIFFENERS TO O.T. BHD. 3/4" RIVETS 1/2" PITCH
SEAMS & BUTTS 3/4" 25/8"
FOR DETAILS OF TRUNK & HATCH SEE PLAN NO. 363

OK
13.22

DN 362

Lloyd's Register of Shipping
Queenstown
25.2.22
H.M.D.

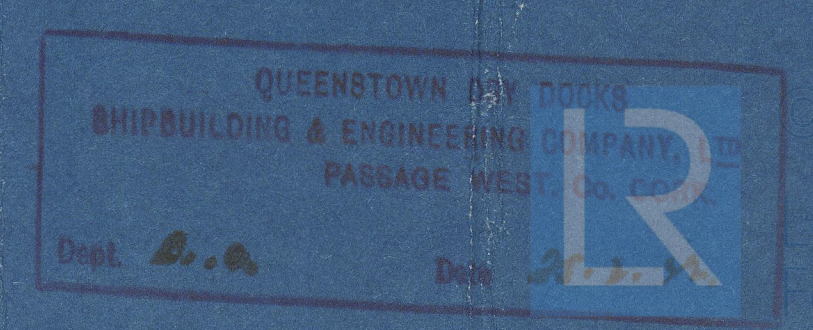

S.S. Rex more
Queenstown
Report 3709

Rex more

