

Stella Dorado.

64756

# REPORT OF PERIODICAL SURVEYS & REPAIRS OF MACHINERY


STELLA DORADO (Trawler)  
Owner: Stella Dorado, Ltd.  
Manager: Charleson-Smith, Ltd.  
Engine: Smith's Diesel Co. Ltd.  
Compound: Compound.

No. of Survey: 1  
W.P. 225 12.  
No. of Donkey Engines: 2  
W.P.




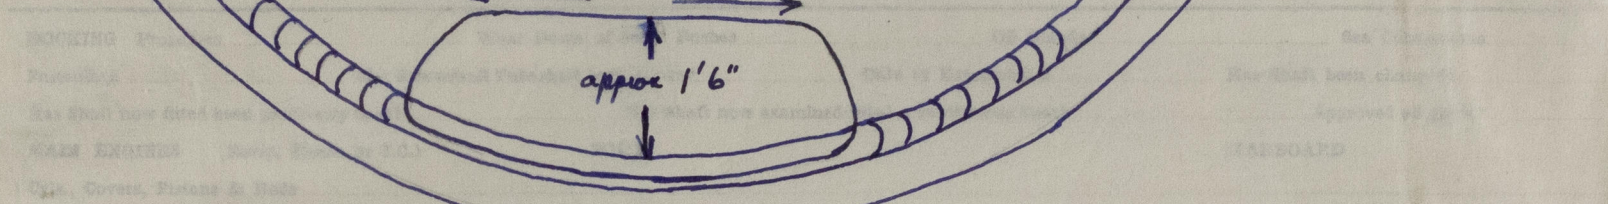






new plate 1/2" W built to back end plate.