

21/12/11



# PROFILE AND DECK PLANS

378'-0" x 53'-3" x 26'-11" D.M.

No. 180 SHIP

SCALE 1/8" = 1 FOOT.

WILLIAM DOBSON & CO.  
IRON SHIPBUILDERS  
15/12/11  
NEWCASTLE-ON-TYNE

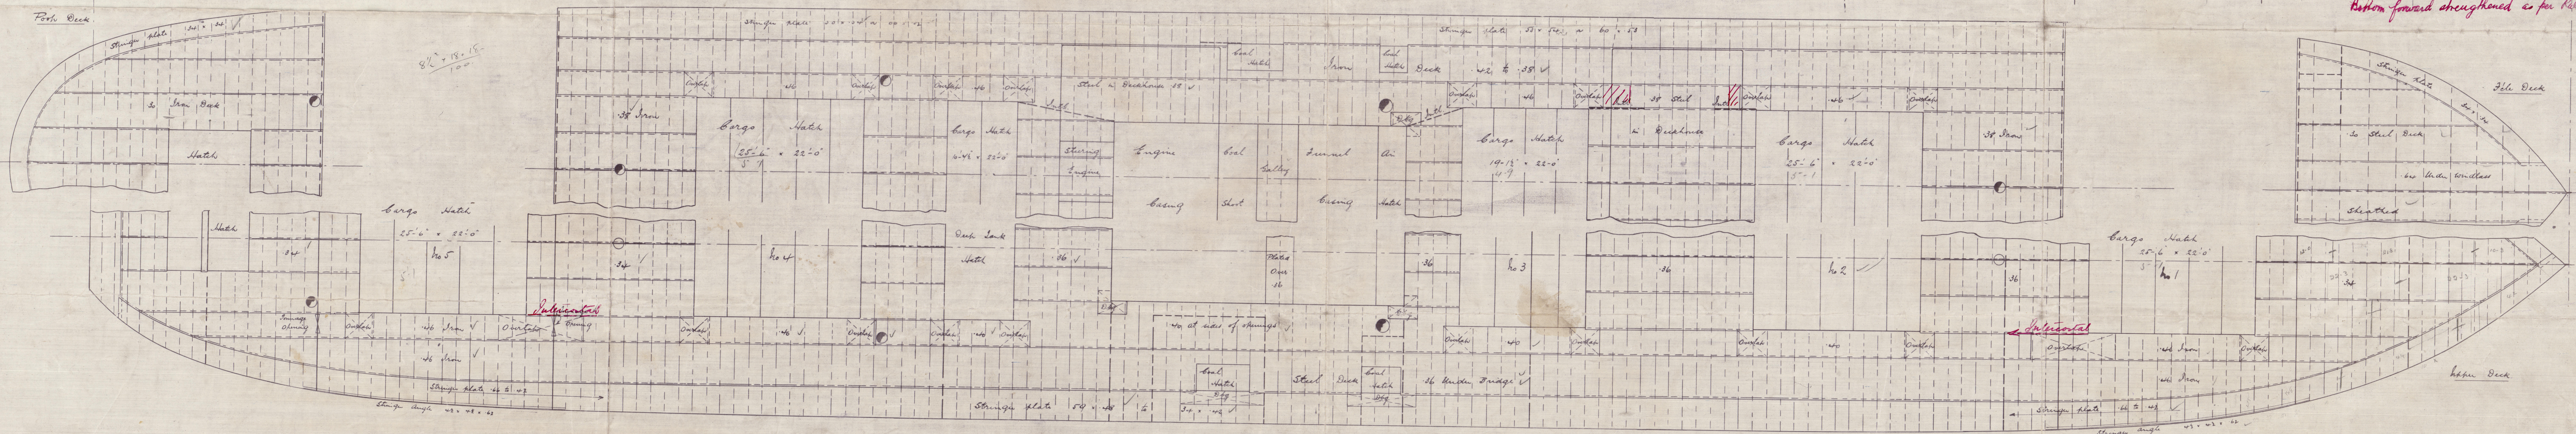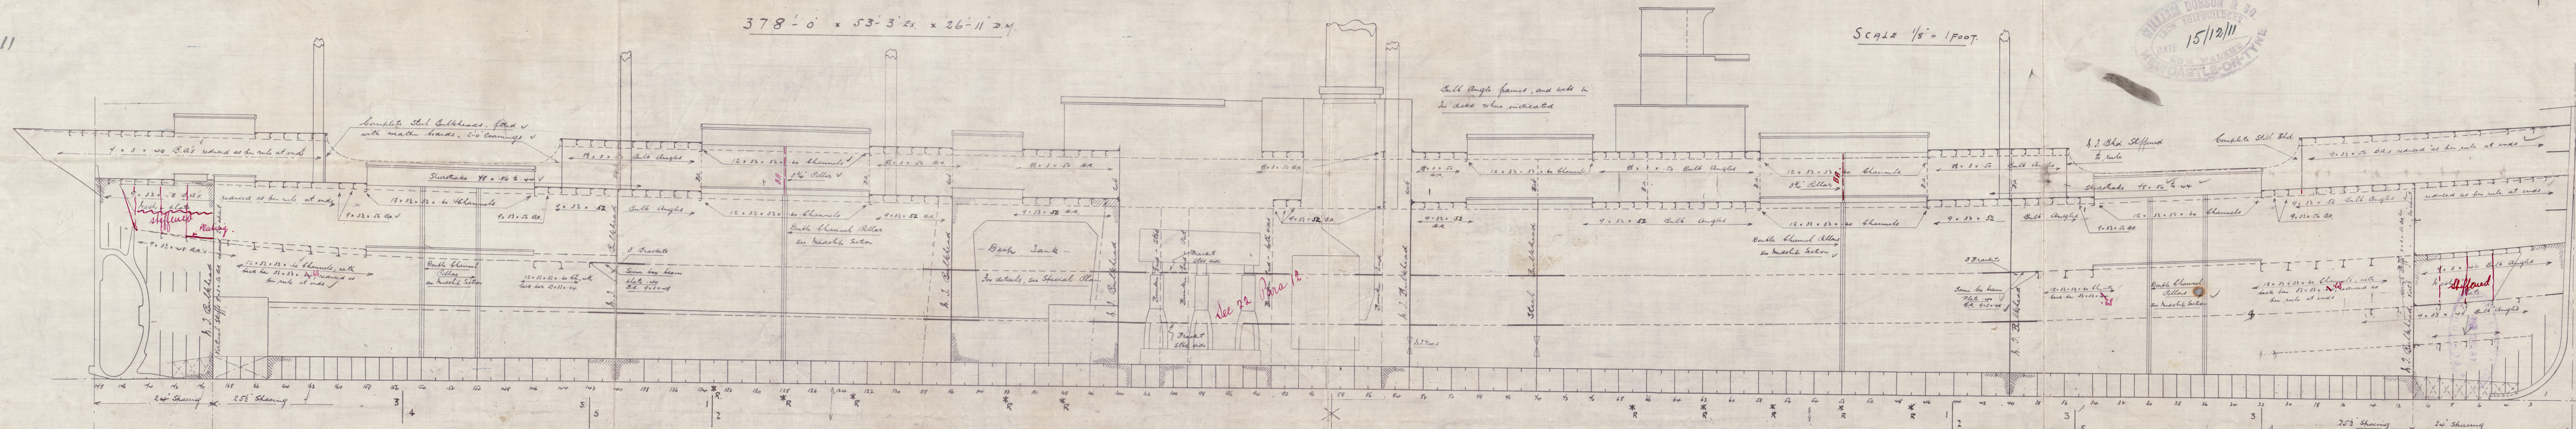

C.F.  
21/12/11





Dobru 180.

(<sup>12</sup> w/d. & Deck.

Ljubljana \*

Ex

s.s. "Dunav"  
ex

s/s "Karpat"

NEWCASTLE - ON - TYNE

Rpt No. 63138

081

003513-003514-0298

RETAIN



© 2020

Lloyd's Register  
Foundation