




144548

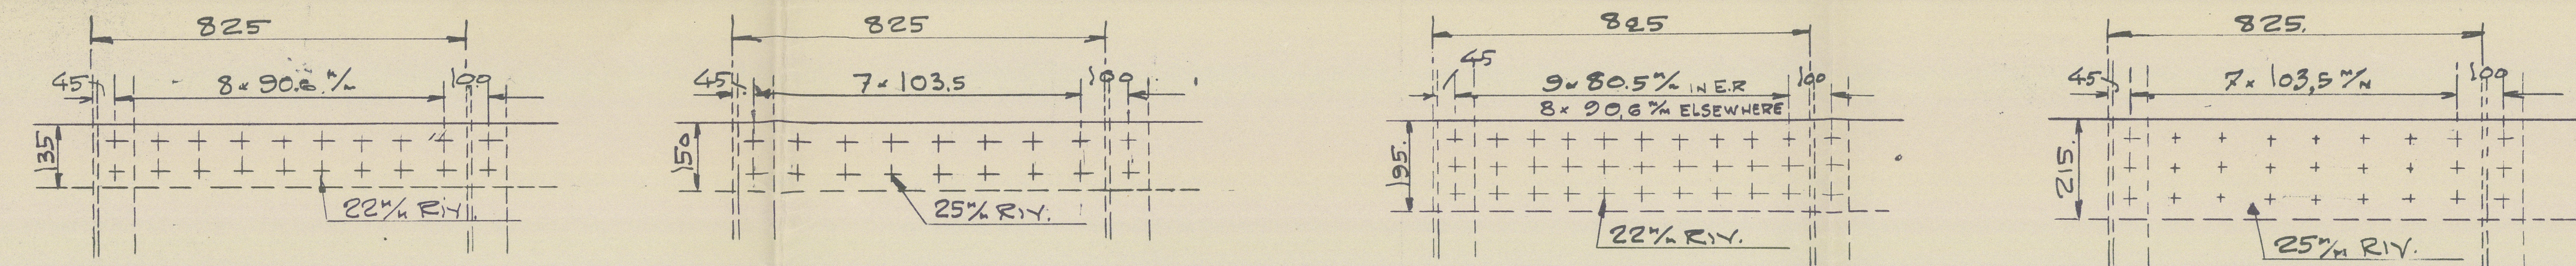

RIVETING IN SEAMS

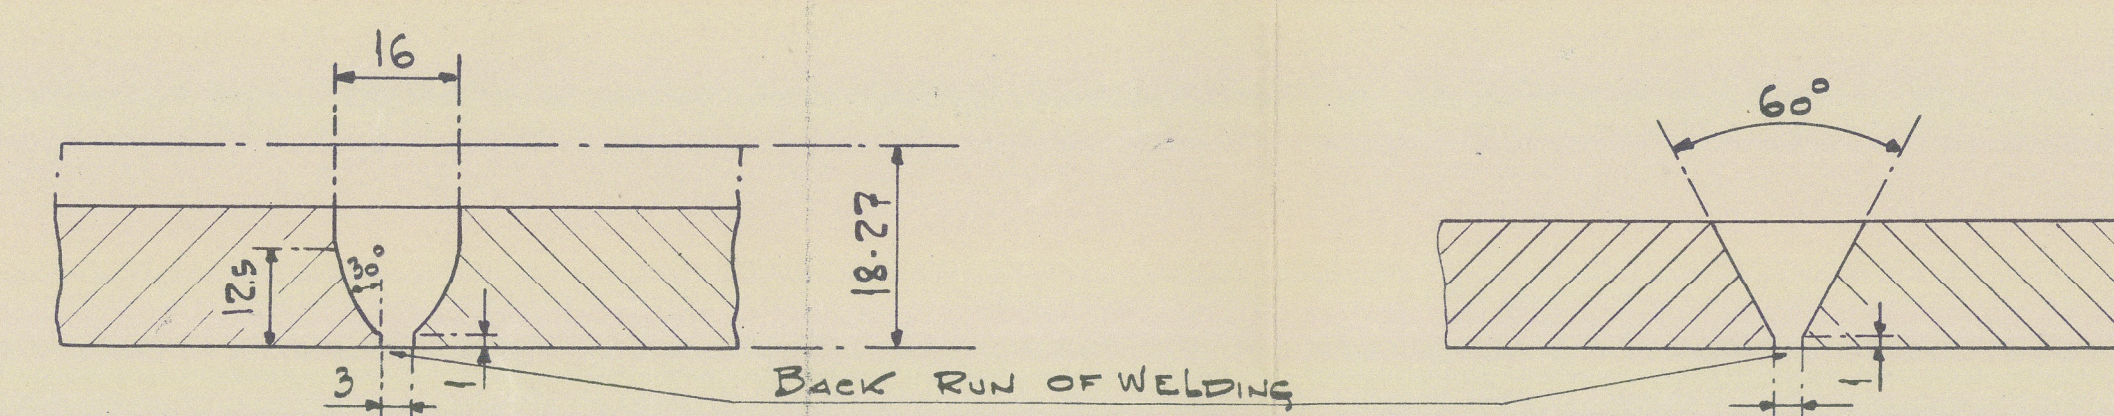


BUTTS OF PLATES 18-27 1/4

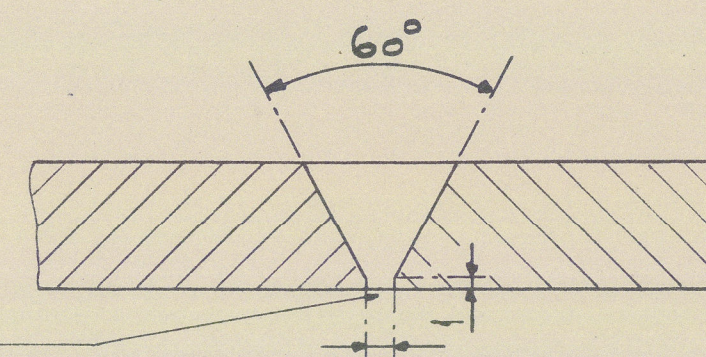

BUTTS OF PLATES 17.75%

†	SINGLE	RYETED	SEAMS
‡	DOUBLE	---	---
§	TREBLE	---	---

BUTTS ELECTRICALLY WELDED.

 

DIMENSIONS

LENGTH P.P.	$51' 10" = 156.004 \text{ m}$
BREADTH MOULDED	$66' 0" = 20.116 \text{ ---}$
DEPTH.	$38' 9" = 11.81 \text{ ---}$

M/55402540
SHELL EXPANSION

FRAME SPAC. 610" ϕ
CORRECTED AS BUILT.
CORRECTED AS APPROVED BY LLOYDS REGISTER 24.98

194548

#14548

GOTHENBURG FIRST ENTRY REPORT No.

*Shell expansion
(as built)*

N^o 540 - "Bellona",

*Aktiebolaget Fr. Hovsten,
Gothenburg.*



© 2020

Lloyd's Register
Foundation

003525-003532-0290