
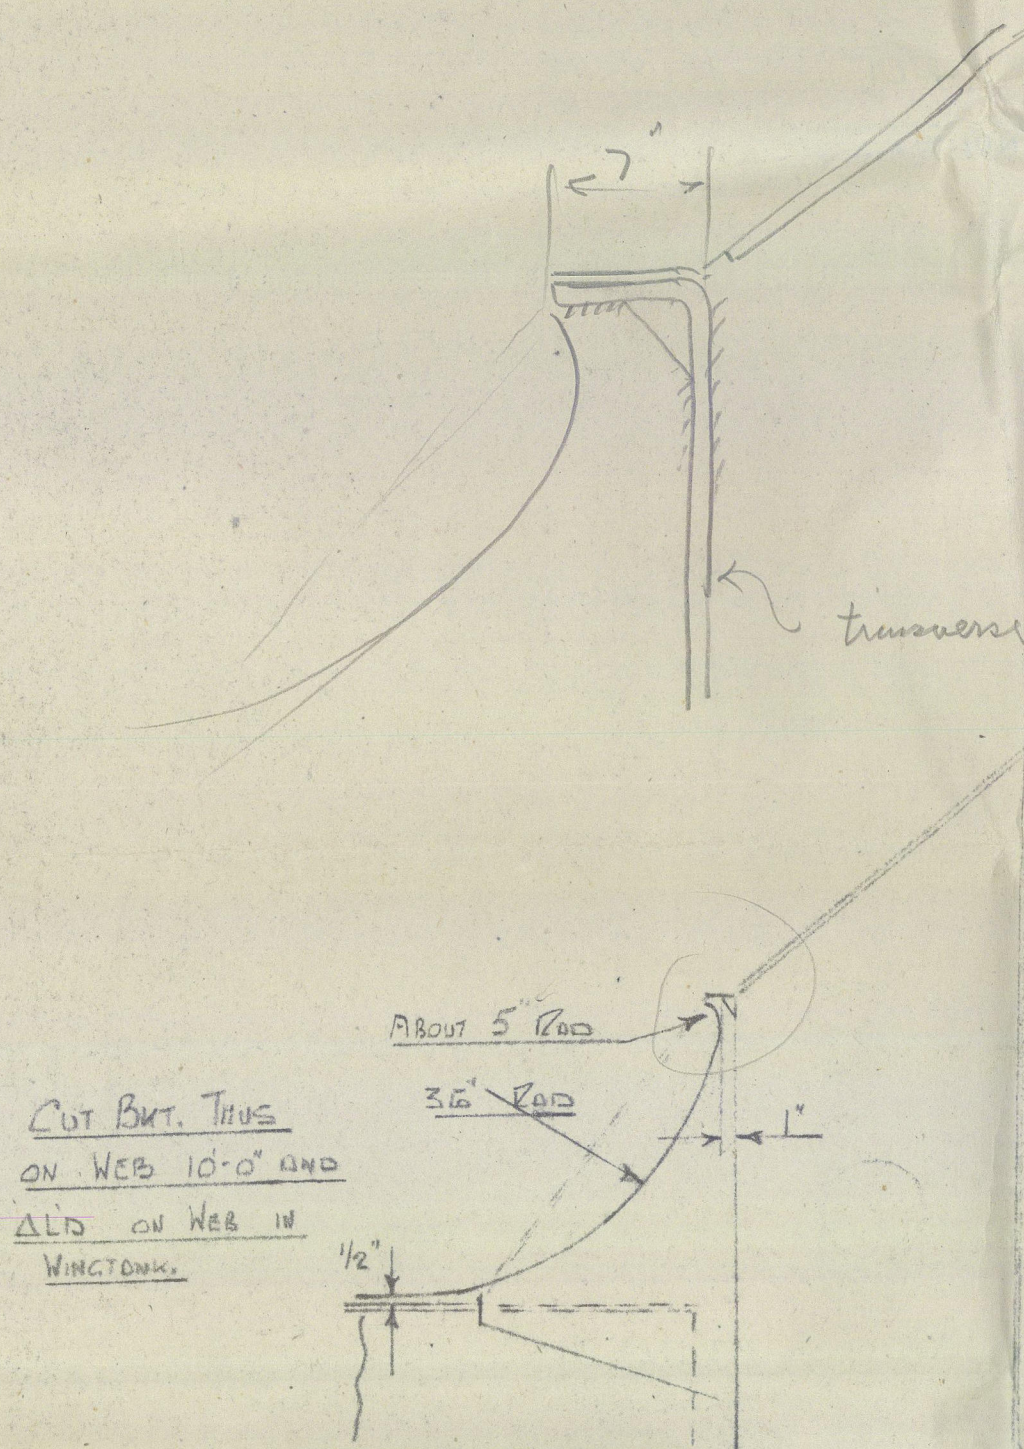


T2-SE-AI TANKERS.  
MODIFICATION TO TRIPPING BRACKET,  
AND METHOD OF WEB STIFFENING  
FOR CENTRE CARGO TANK BHD WEBS.




ESSO BIRMINGHAM

NEWCASTLE-ON-TYNE, No. 106819.

STIFFENING FITTED IN NOS 2, 3, 6 & 9  
CENTRE CARGO TANKS.

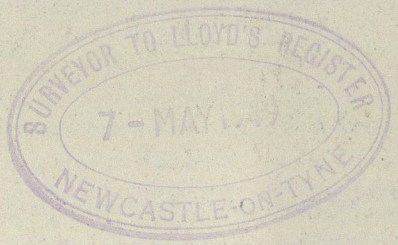

ELEVATION OF BHD WEB.  
10'-0" OFF E.P.S.

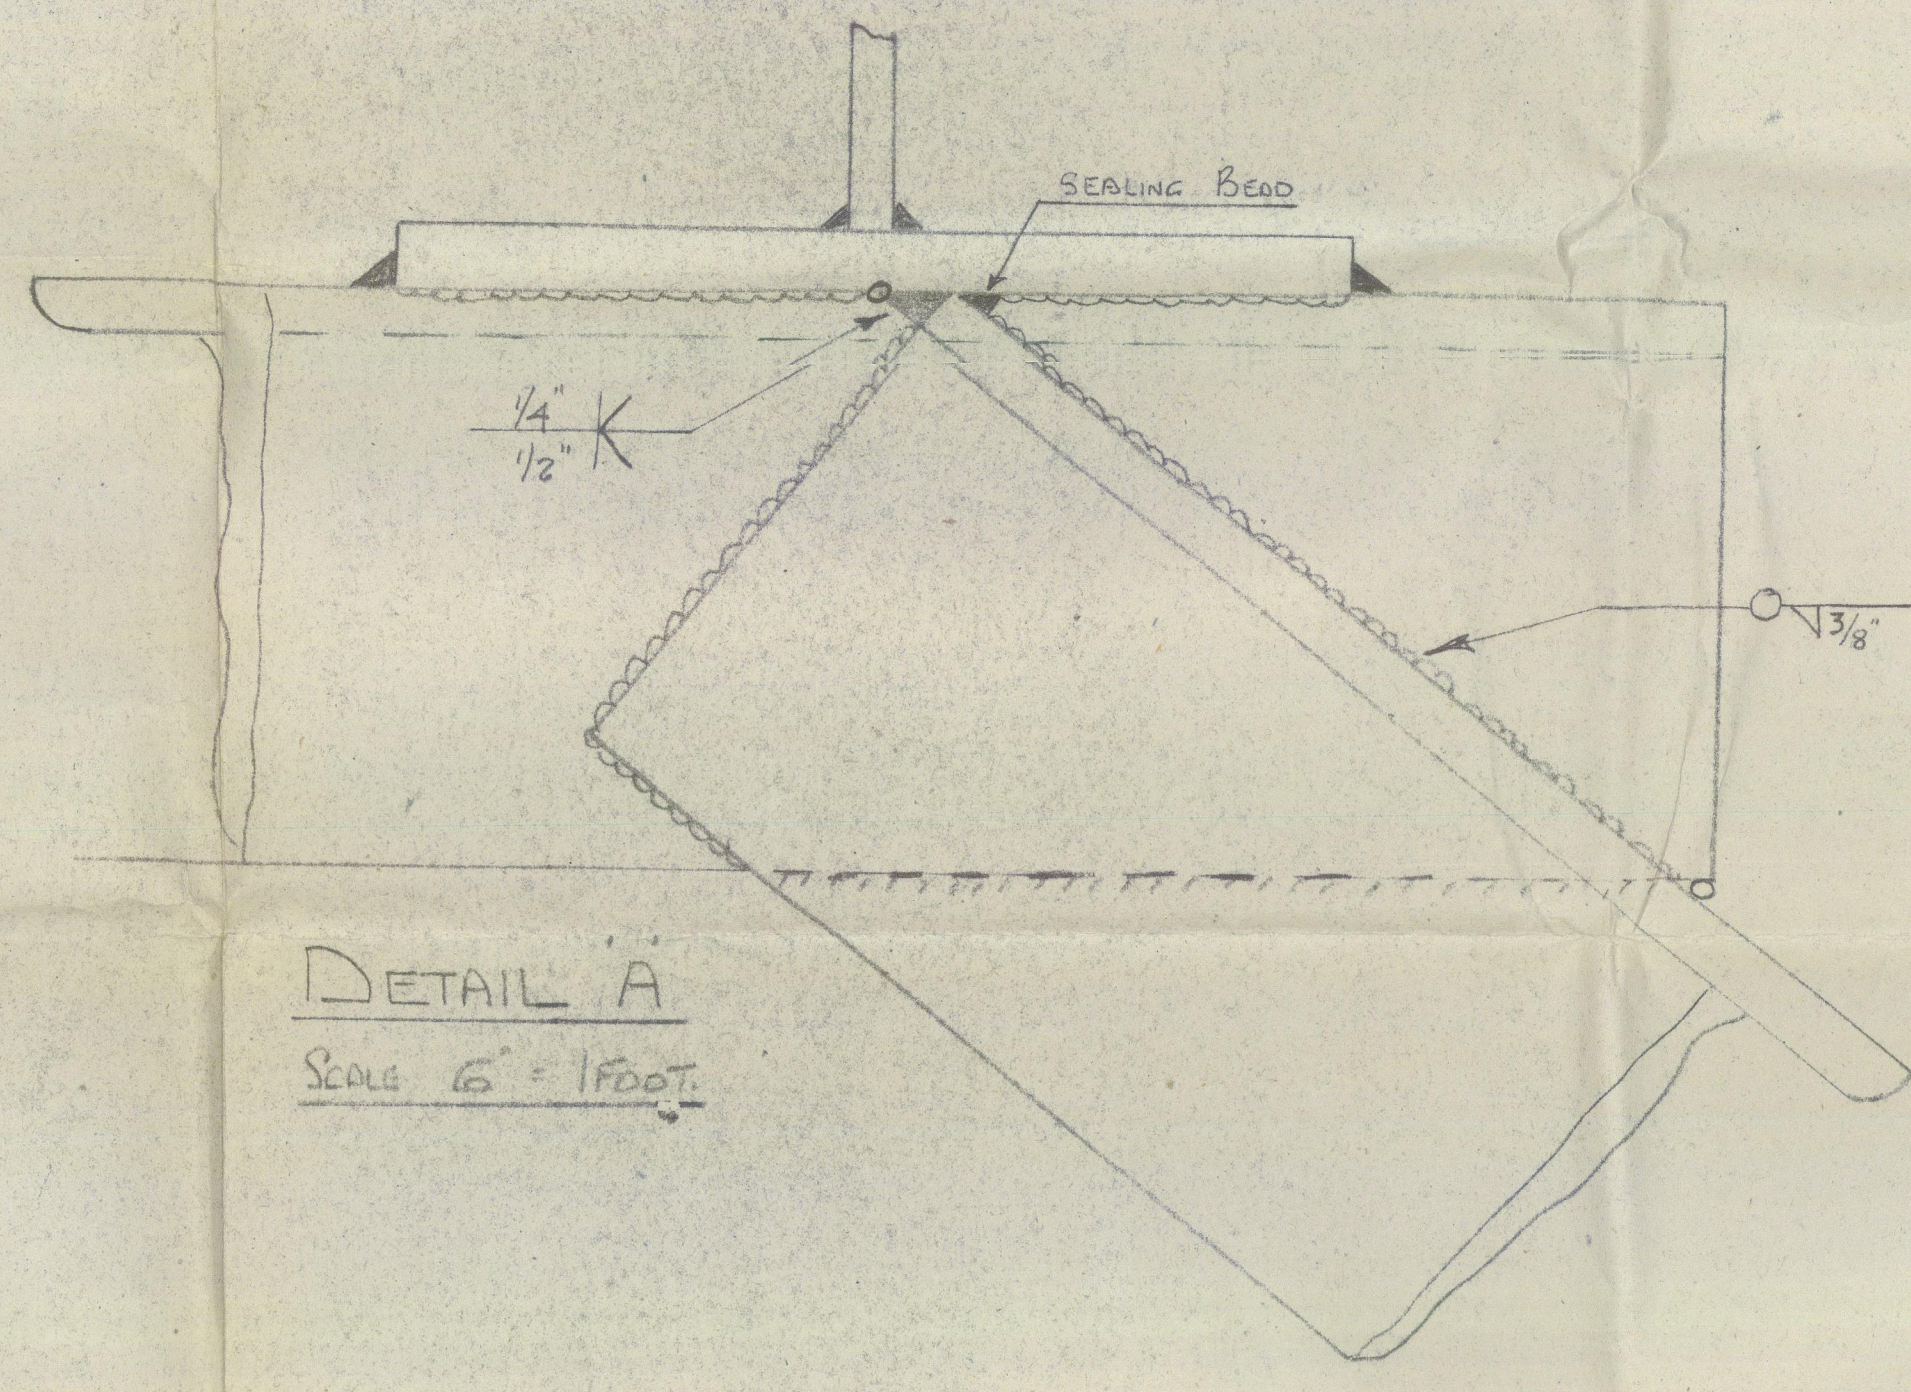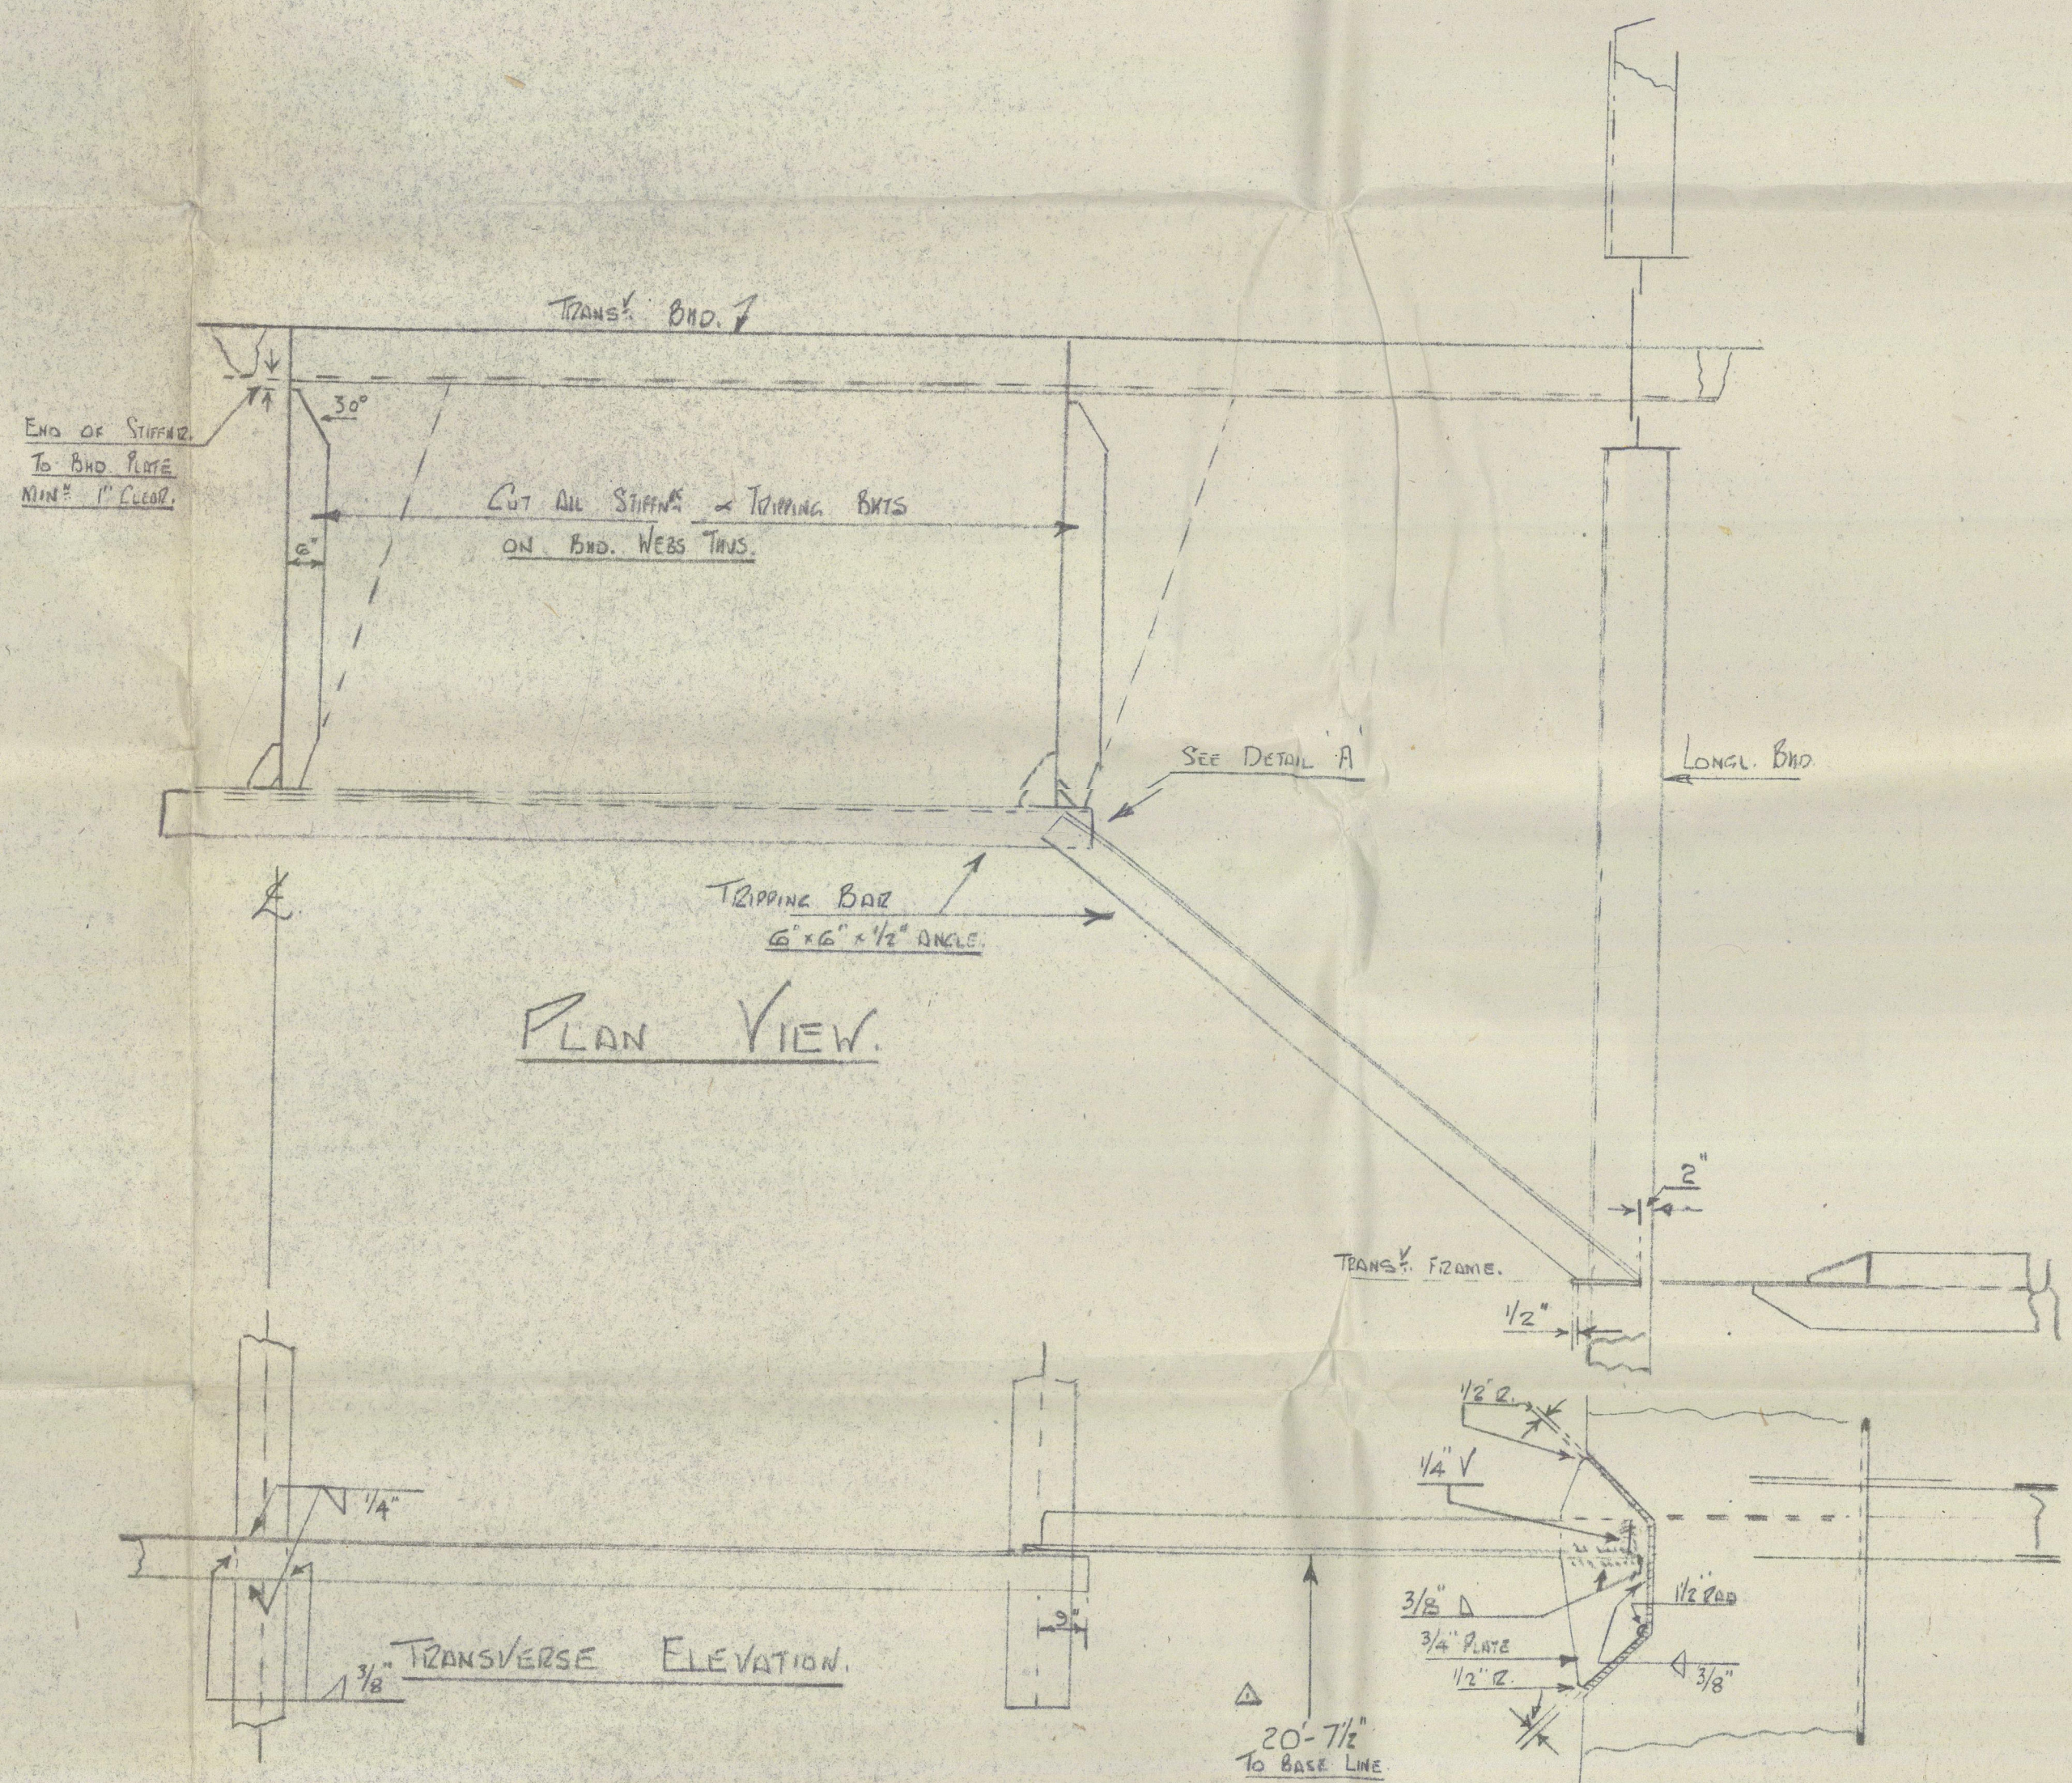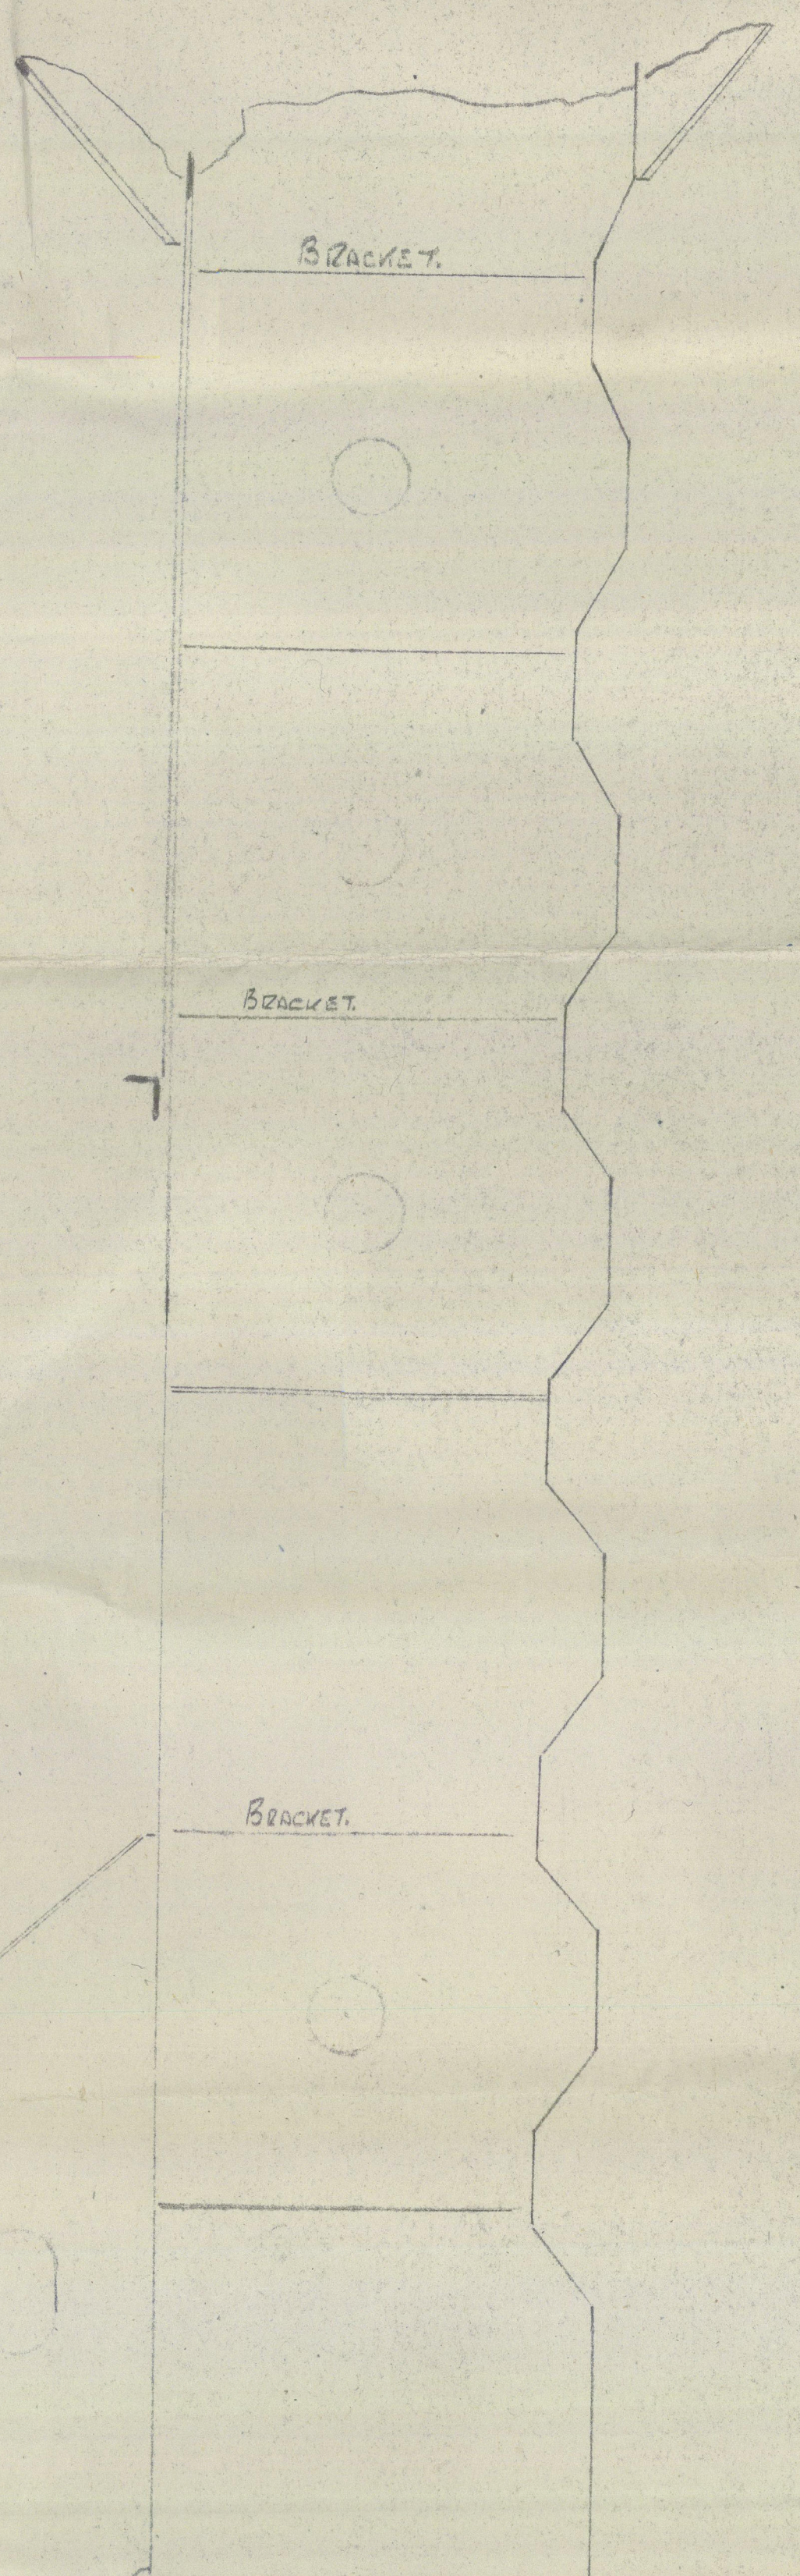

DETAIL A  
SCALE 6" = 1 FOOT.