

FORGED IRON RUDDER FRAME

SCALE $\frac{1}{2}" = 1 \text{ FOOT}$

TO PASS LLOYD'S SURVEY

STERN
FR

DETAIL OF BOTTOM GUDGEON

SCALE 3" = 1 FOOT

ABOVE BOSS

BELOW BOSS

LLOYD'S REGISTER OF
MILLS
30/9/14

DETAIL OF STOPPER ARRANGEMENT

SCALE 3" = 1 FOOT


035340-0219

Sir Raydon Dixon Esq.

S.S. No. 594.609

¹⁵ Forged rudder & stern frame
of "Rosa"

Middlesbrough Report 10082.

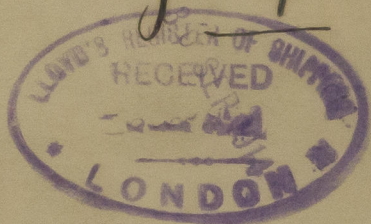

approved. for. S-S. 47609

See See Ellen



003534-003540-0219