

14/6/29
18/6/30 - No 1089

PLAN No. 2279
FOR ENCLOSURE TO
Messrs. Lloyd's Register of Shipping
FROM
COCHRANE & SONS, LTD.
SHIPBUILDERS SELBY
DATE 10-6-29

PROFILE & DECK PLAN.

Nos 1062 & 63.

STEEL SCREW TRAWLER.

DIMNS:- 140'0 B.P. x 23'10 1/2 MLD x 14'0 MLD.

SCALE 1/4" = 1 FOOT


TO CLASS 100 A.I. STEAM TRAWLER.

BULKHEADS STIFFENED TO SURVEYORS SATISFACTION

BEAMS 6' x 3' x 45' EXCEPT WHERE MARKED OTHERWISE

MAST SUPPORTED TO
SURVEYORS SATISFACTION

MULEBACK BEAMS 4' x 3' x 38'
SPACED ABOUT 30" APART

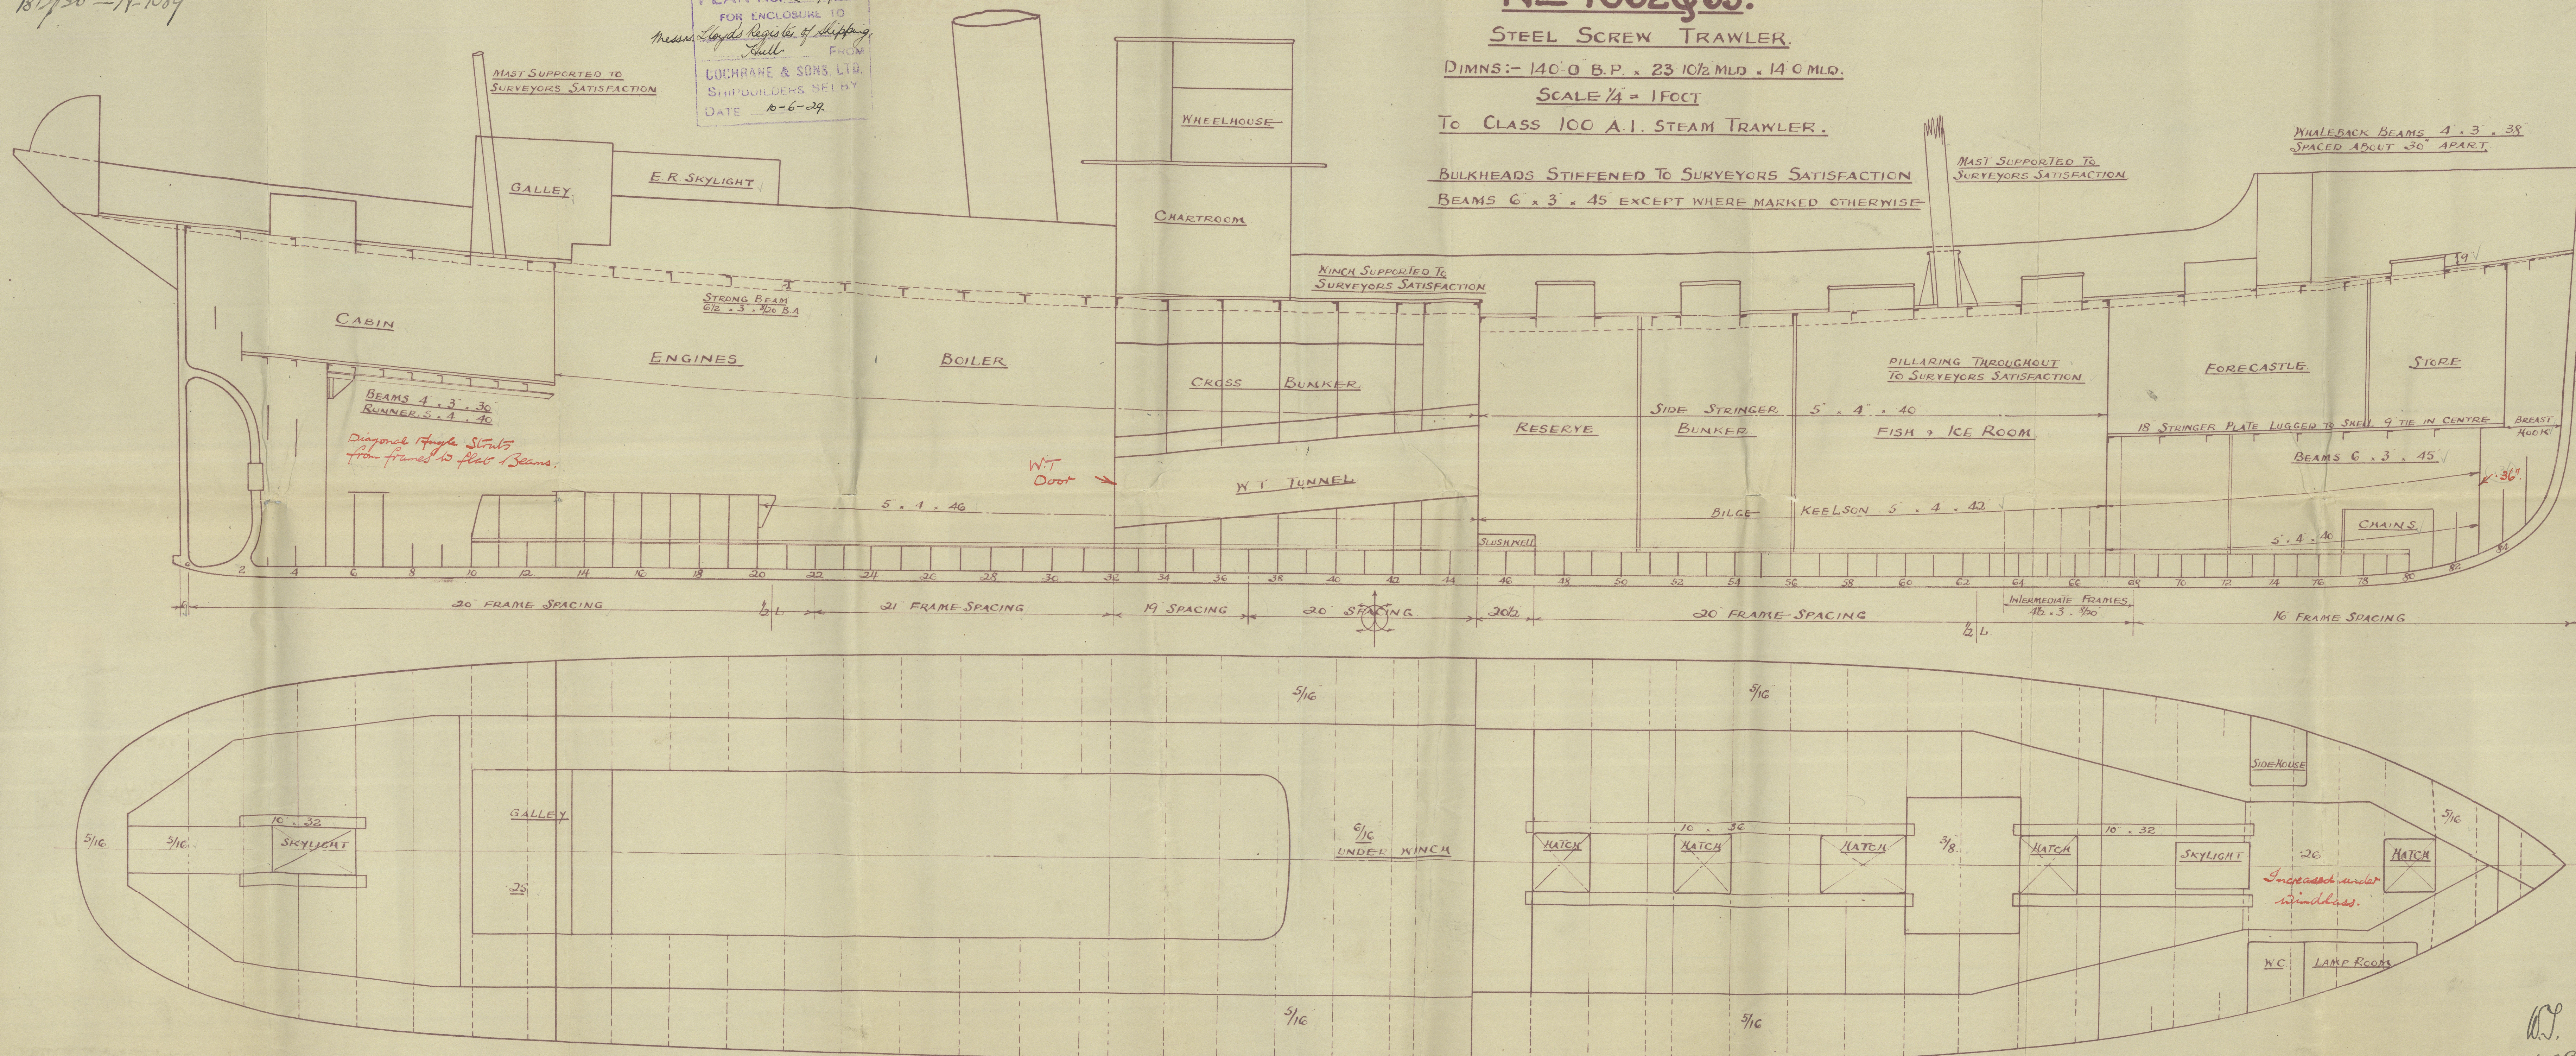

14-
14-6
14-1

14.6.29

Nos 1062/3 91089

Profile & Deck.

~~Cochmanes~~ ~~Sass~~ ~~to~~

Messrs. Lloyd's Register of Shipping,
Hull.

S.S.	"Lord Trent"	1062
HULL REPORT NO.		40373

S.S.	"Lord Dawson"	1063
HULL REPORT NO.		40421

1089.	"Pennine"	"
S.S.	Pennine	
HULL RE.	ENCLOSURE No 939	41098.



© 2020

Lloyd's Register
Foundation