

# MIDSHIP SECTION.


**1/4 LORD TRENT**

DIMNS - 140' 0" B.P. x 23' 10 1/2" MLD. x 14' 0" MLD.

SCALE 1/2" = 1 FOOT.

TO CLASS + 100 A.1. STEAM TRAWLER.

PLAN No. 3040.  
Messrs. Lloyd's Surveyors,  
Hull.  
Date 12-11-29.

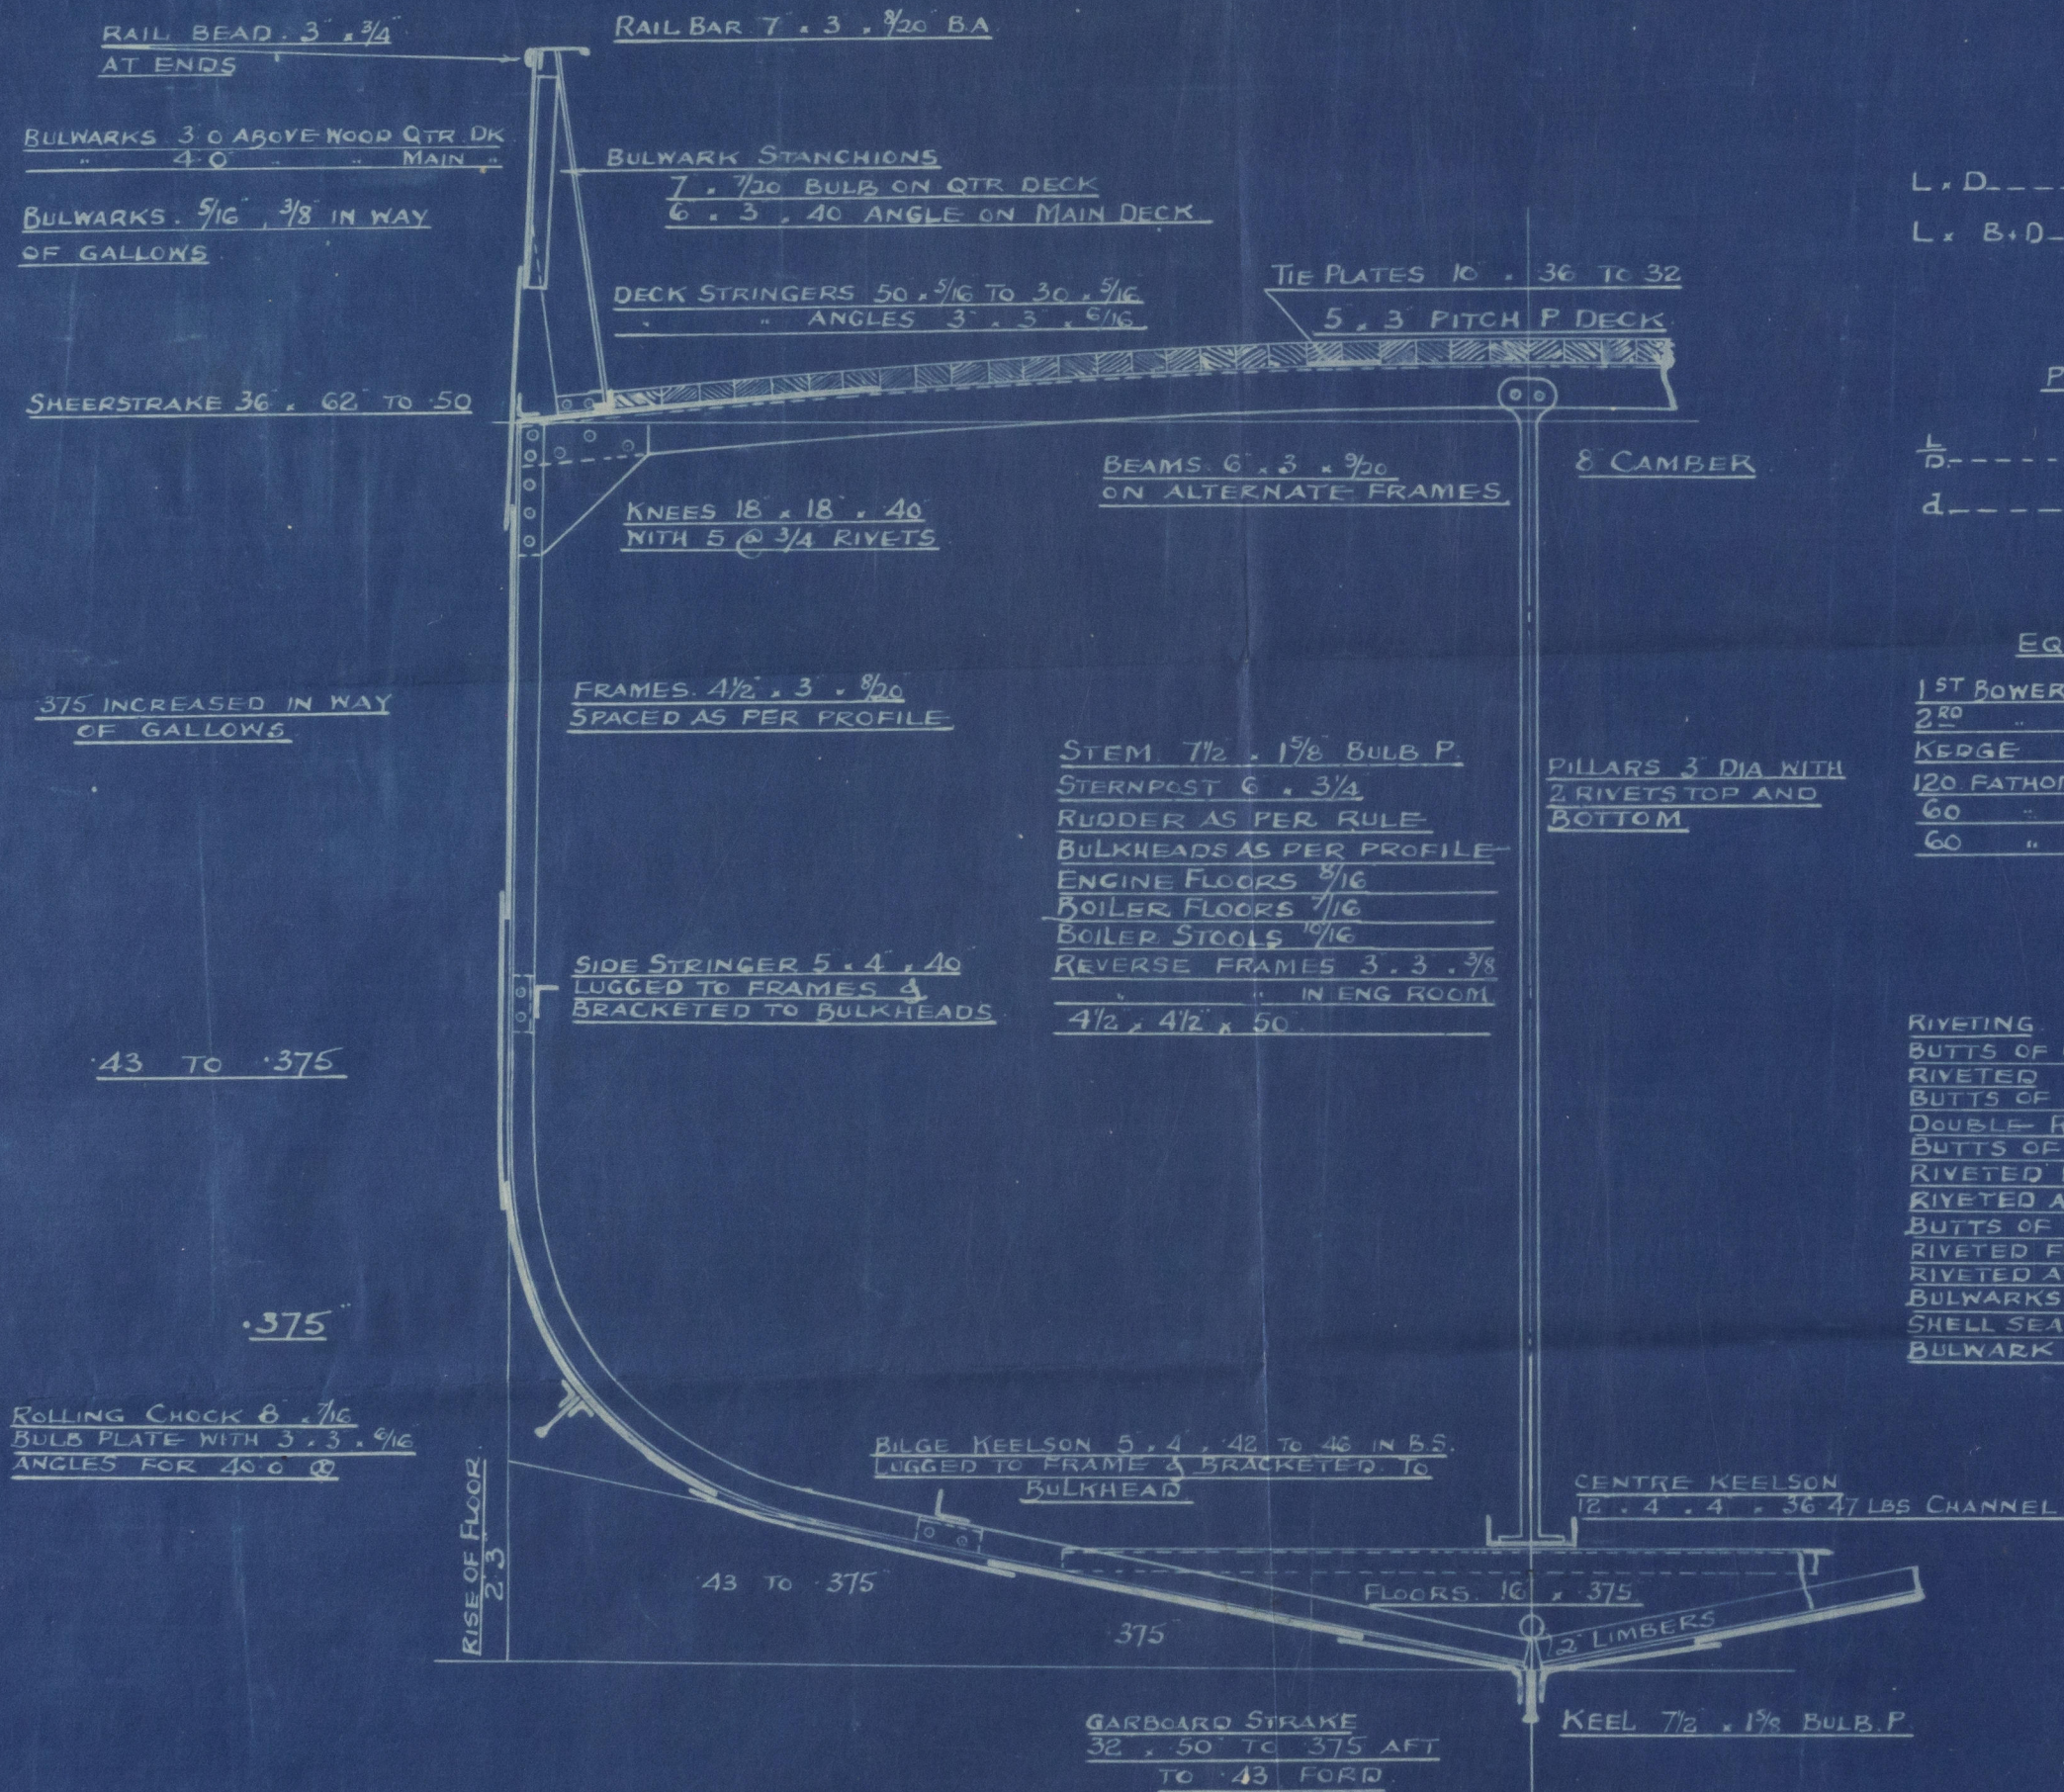

## NUMERALS

L. D. ----- 1960.00  
L. x B. D. ----- 5301.80

## PROPORTIONS

L/D ----- 10.00  
d ----- 12.67

## EQUIPMENT

1<sup>ST</sup> POWER ANCHOR 8 1/4 CWTs. STOCKLESS  
2<sup>ND</sup> " " 7 1/2 " " " "  
KEDGE " 3 1/4 " " EX STOCK  
120 FATHOMS 1 2/16" STUD LINK CABLE  
60 " 6" HAWSER  
60 " 5" WARP

**RIVETING.**  
BUTTS OF GARBOARD STRAKE STRAPPED & DOUBLE RIVETED  
BUTTS OF B, C & D STRAKES OVERLAPPED & DOUBLE RIVETED  
BUTTS OF E & F STRAKES OVERLAPPED & TREBLE RIVETED FOR ABOUT HALF LENGTH, DOUBLE RIVETED AT ENDS  
BUTTS OF G STRAKE STRAPPED & TREBLE RIVETED FOR ABOUT HALF LENGTH, DOUBLE RIVETED AT ENDS  
BULWARKS STRAPPED & SINGLE RIVETED  
SHELL SEAMS DOUBLE RIVETED  
BULWARK SEAM SINGLE RIVETED



Lloyd's Register  
Foundation



No 1062

Midship Section (as built)

Cochranes Sons Ltd -

S.S. "Lord Trent"

HULL REPORT NO 40373

Lloyd's



© 2020

Lloyd's Register  
Foundation

003541-003548-0064