

PLAN No. 2280

FOR ENCLOSURE TO

Messrs. Lloyd's Register of Shipping,  
Hull.FROM  
COCHRANE & SONS, LTD.

SHIPBUILDERS SELEY

DATE 10-6-29


## MIDSHIP SECTION.

N<sup>o</sup> 1062-63.

DIMNS - 140' 0" B.P., 23' 10 1/2" MLD., 14' 0" MLD.

SCALE 1/2" = 1 FOOT.

TO CLASS + 100 A.I. STEAM TRAWLER.

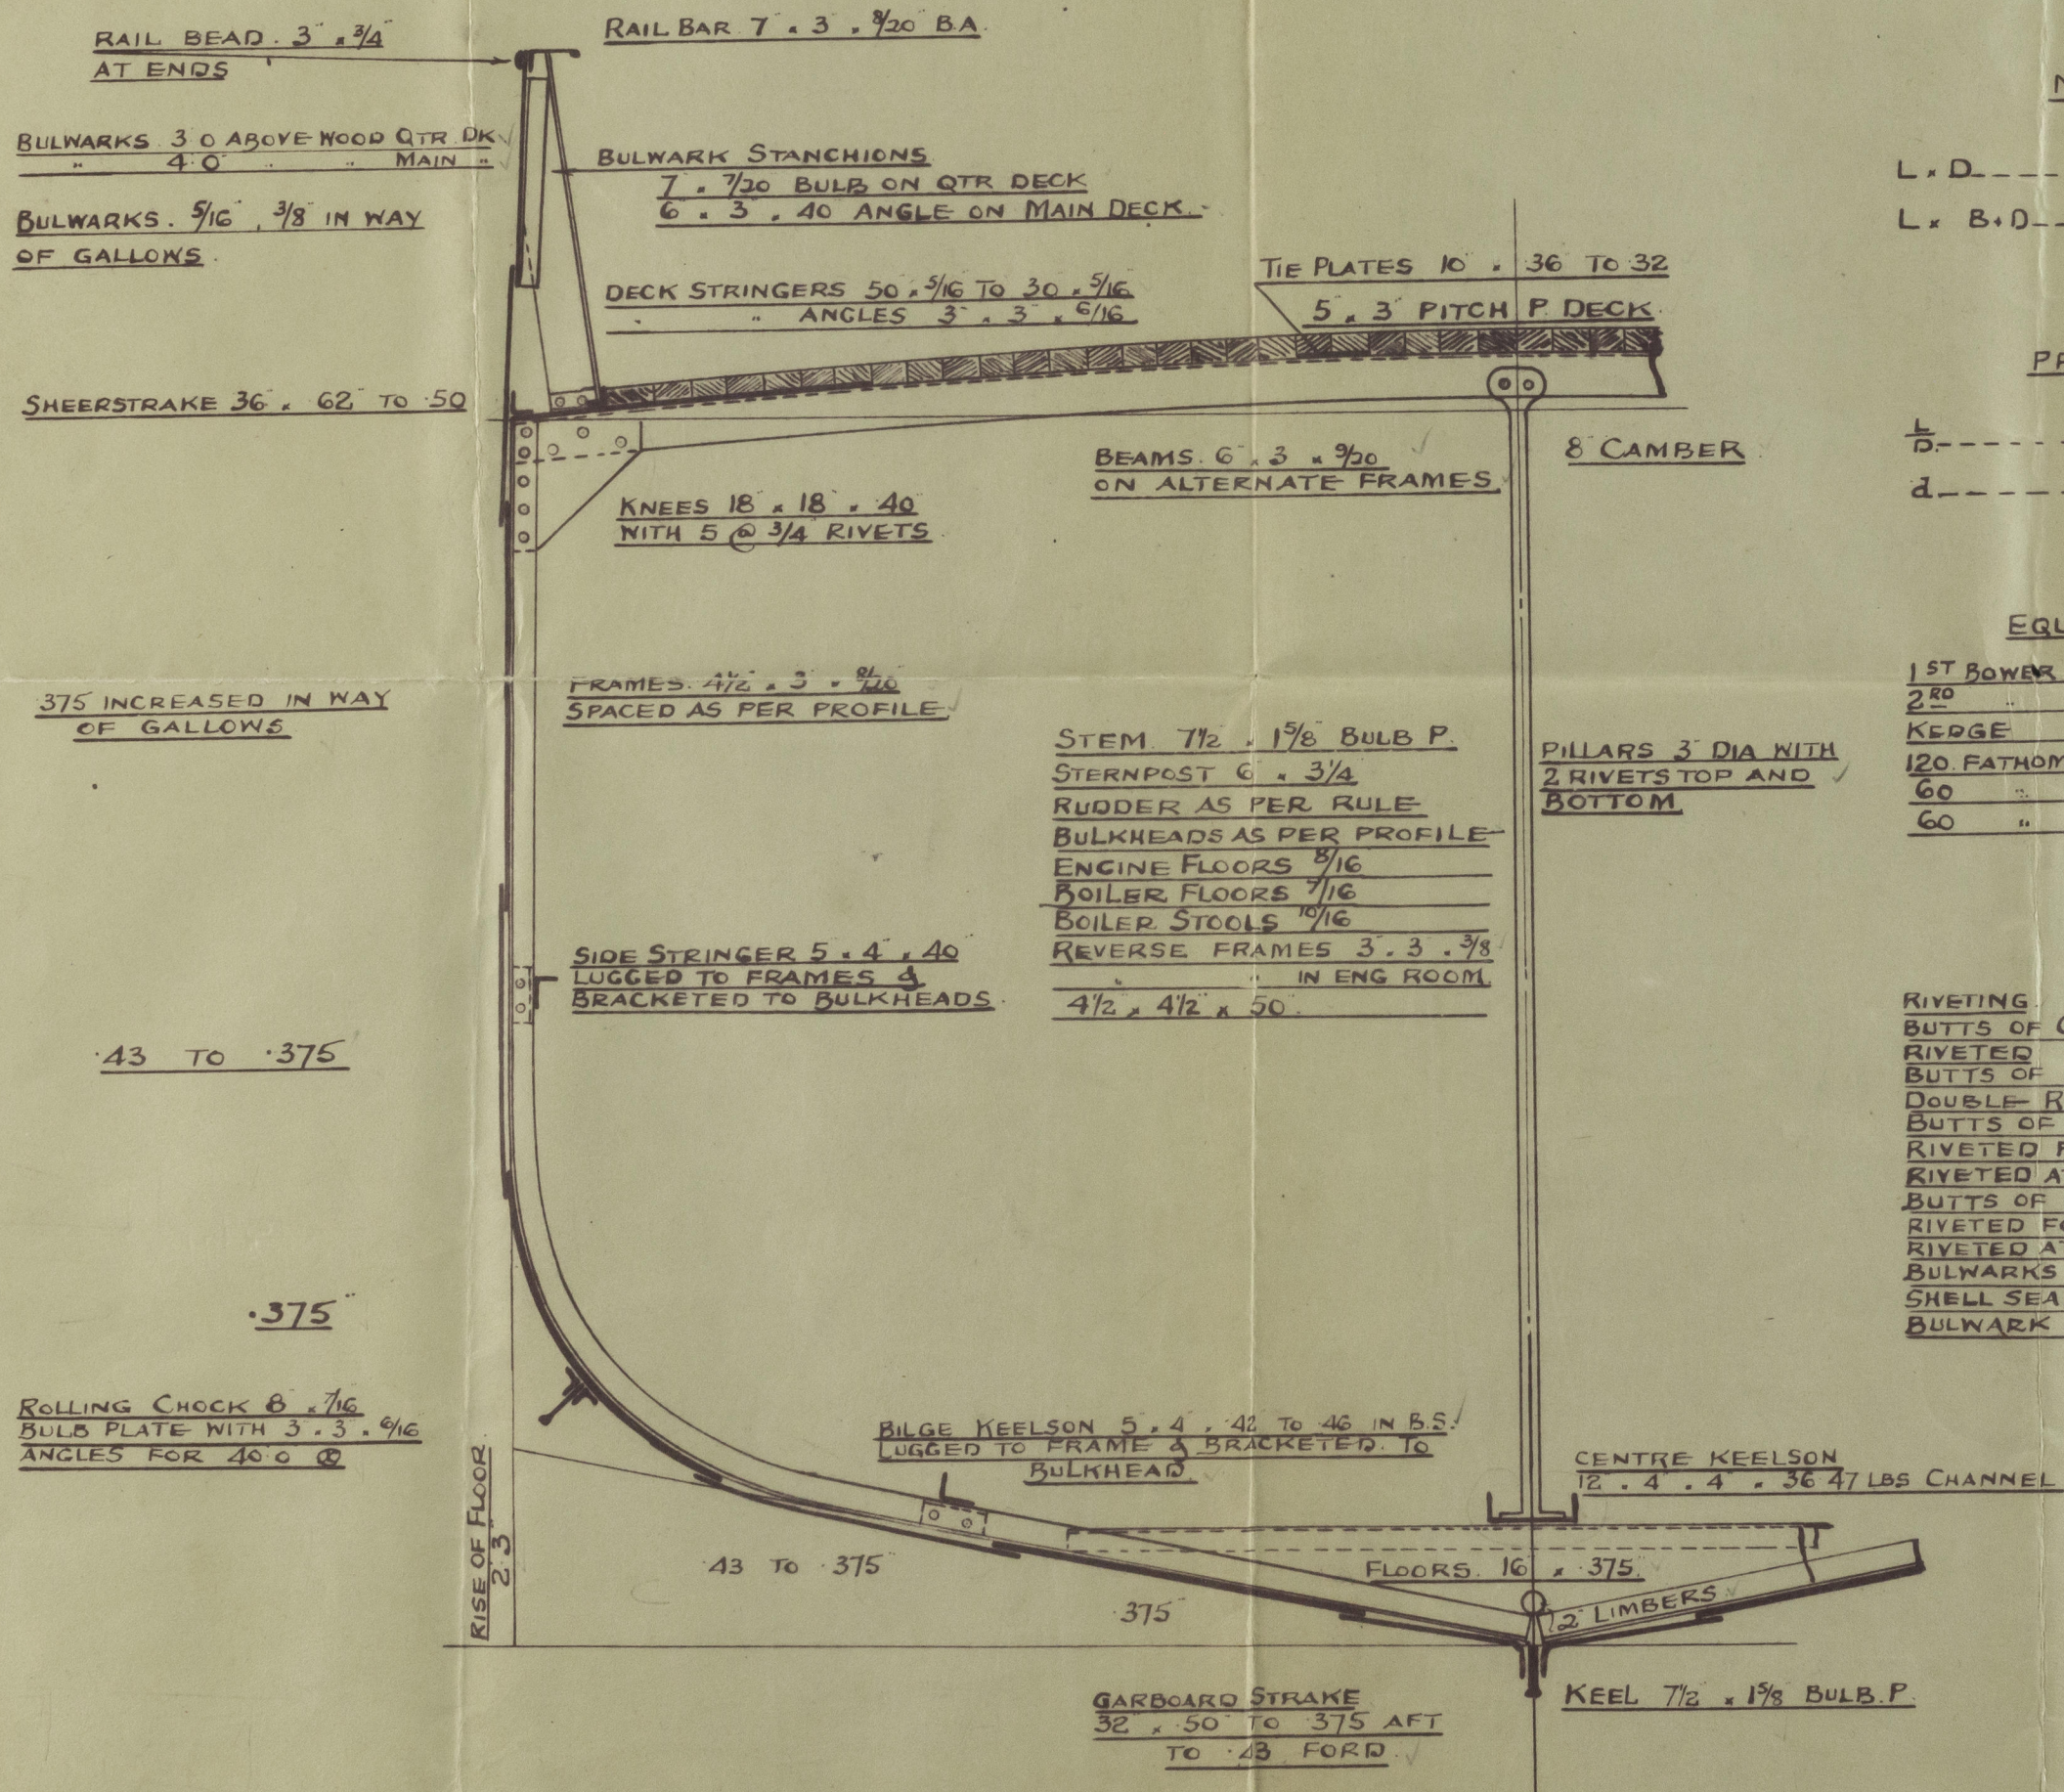

## NUMERALS.

L x D ----- 1960' 00"

L x B.D. ----- 5301' 80"

## PROPORTIONS.

L ----- 10' 00"

d ----- 12' 67"

## EQUIPMENT.

1<sup>ST</sup> BOWER ANCHOR 8 1/4 CWTs. STOCKLESS

2<sup>ND</sup> " 7 1/2 " "

KEEDGE " 3 1/4 " EX STOCK

120 FATHOMS 1 1/2" STUD LINK CABLE

60 " 6 HAWSER

60 " 5 WARP

RIVETING

BUTTS OF GARBOARD STRAKE STRAPPED & DOUBLE RIVETED

BUTTS OF B.C & D STRAKES OVERLAPPED & DOUBLE RIVETED

BUTTS OF E & F STRAKES OVERLAPPED & TREBLE RIVETED FOR ABOUT HALF LENGTH, DOUBLE RIVETED AT ENDS

BUTTS OF G STRAKE STRAPPED & TREBLE RIVETED FOR ABOUT HALF LENGTH, DOUBLE RIVETED AT ENDS

BULWARKS STRAPPED & SINGLE RIVETED

SHELL SEAMS DOUBLE RIVETED

BULWARK SEAM SINGLE RIVETED

14.6.29

© 2020

003541-003548-0065

Lloyd's Register  
Foundation



nos 1062/3 & 1089  
Midship Section

~~Cochranes Lane L.~~

Messrs. Lloyd's Register of Shipping,  
Hull.

S.S. "Lord Trent"

1062



HULL REPORT No. 40373

S.S. "Lord Dawson"

1063


HULL REPORT No. 40401

1089

"

Pennine

"

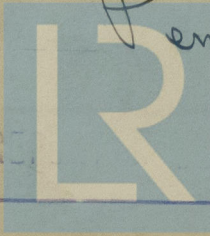

41098

HULL REPORT

Lloyd's Register  
Foundation

MIDSHIP SECTION