

For the information of Surveyors and the Committee only.

Received at \_\_\_\_\_ Office 31 AUG 1929

# Lloyd's Register of Shipping.

(Report on Vessel No. 40373, Port Hull)

## No. \_\_\_\_\_ SHIP FORGINGS OR CASTINGS.

I have to report that the undermentioned Iron or Steel Forgings or Castings, manufactured by Mr J. S. Forster & Son Ltd of Sunderland for the Vessel No. 1062, being built by Cochrane & Son Ltd of Selly have been inspected by me as set forth below and found to be, so far as can be seen, Sound.

on Forgings or Castings.

Lloyd's

No. 5338

30-8-29



D. D. Williamson

Sunderland, 30-8-29



	STERN FRAME.	RUDDER FRAME.	STEM.
Material	/	Scrap Iron	/
Made		Forged	
Heat-treated			
Dimensions		5' 2" dia 5 x 4 1/2 x 3 1/2 x 3"	
Pressure on Inspection		Forged & Finished	
When Inspected		19-8-29 to 30-8-29	
CASTINGS.			
Tests on Standard Test Pieces.			
Weld Test—			
Strengths per square inch			
Elongation per cent. ...			
Bending Test—			
Angle before fracture			
Test—			
Height from ground ...			
Measuring Test—			
Made according to Rules and found satisfactory ...			

SKETCHES OF FRAMES SHOWING POSITION AND DESCRIPTION OF WELDS OF FORGINGS.

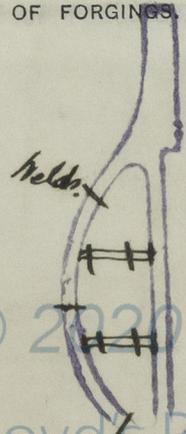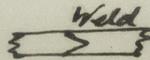

Fee (if any chargeable) £ : :

To be paid at \_\_\_\_\_

If of Iron, state whether scrap or puddled Iron. If of Steel, state whether made on the Open Hearth process.



© 2020

Lloyd's Register Foundation

003541-003548-0079