


544

"C" TYPE STEAMERS

THICKNESS OF TANK BP PLATING AS ALREADY APPROVED AND SPACING OF RIVETS
IN REVERSE FRAMES ARE SUITABLE FOR CARRIAGE OF OIL FUEL
PUMPING ARRANGEMENTS TO BE IN ACCORDANCE WITH RULES.

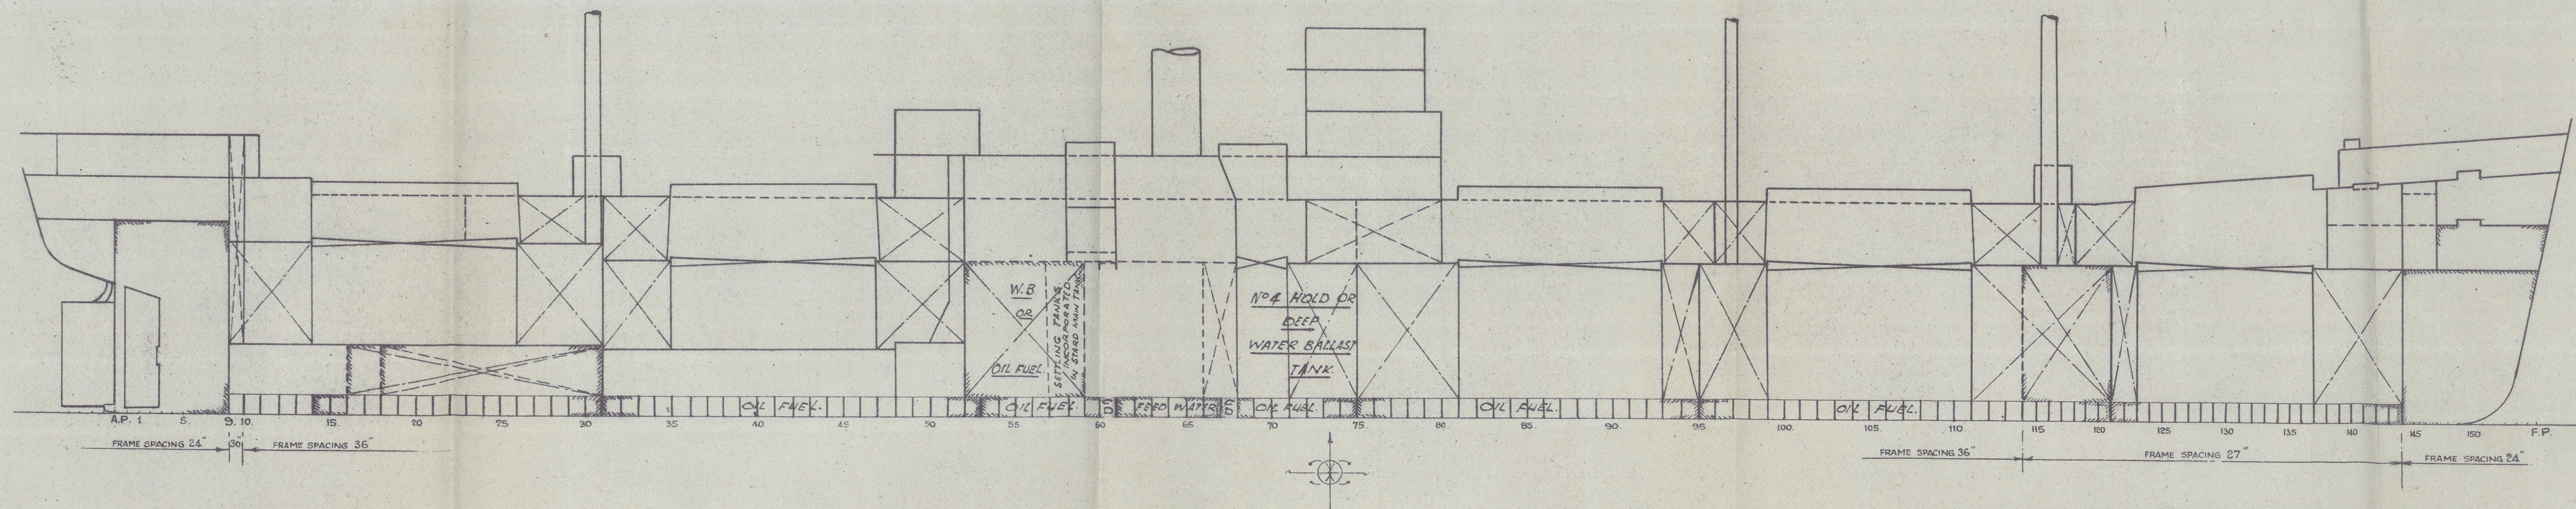


OIL FUEL IN D. BOTTOM. 990 TONS APPROX.
" " " " F.R. TANK 325 TONS (INCLUDES SETTLING TKS)
DEEP TANK. (W.B. ONLY) IN CROSS BUNKER HOLD. 770 TONS.

W.S.
18.11.44

133/544

8-11-44

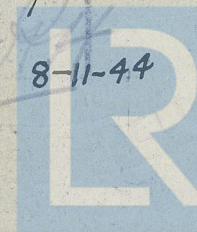

© 2020

Lloyd's Register
Foundation

003541-003548-0200

2

J. READHEAD & SONS LTD.

YARD NO. 544.

PROFILE

003541-003548-0200

© 2020



Lloyd's Register
Foundation