

Lloyd's Register of British & Foreign Shipping.

(Report on Vessel No. _____ Port Newcastle.)

No. _____ SHIP FORGINGS ~~OR CASTINGS~~.

The words FORGINGS or CASTINGS, IRON or STEEL, should be struck out as may be required.

I have to report that the undermentioned Iron ~~or Steel~~ Forgings ~~or Castings~~, manufactured by J. S. Forster & Sons Ltd. of Ponduland by C. Rimmoldson & Co of Shields for the Vessel No. 166, being built have been inspected by me as set forth below and found to be, so far as can be seen, sound

Mark on Forgings ~~or Castings~~.


Lloyd's
No 6133
MR

M. Robertson

Ponduland, 4.5.14

	STERN FRAME.	RUDDER FRAME.	STEM.
Material* ...	<u>Scrap Iron</u>	<u>Scrap Iron</u>	
How made ...	<u>Forged</u>	<u>Forged</u>	
Dimensions ...	<u>5 1/2' x 5 1/2' x 3"</u>	<u>4" dia to 3"</u>	
Progress on Inspection ...	<u>Forged & Smithed</u>	<u>Forged & Finished</u>	
Date when Inspected	<u>16.2.14 to 24.3.14</u>	<u>16.4.14 to 23.4.14</u>	
CASTINGS.			
Tests on Standard Test Pieces.			
Tensile Test—			
Tons per square inch ...			
Extension per cent. ...			
Cold Bending Test—			
Angle before fracture ...			
Drop Test—			
Height from ground ...			
Hammering Test—			
If made according to Rules / and found satisfactory ...			

SKETCHES OF FRAMES SHOWING POSITION AND DESCRIPTION OF WELDS OF FORGINGS.

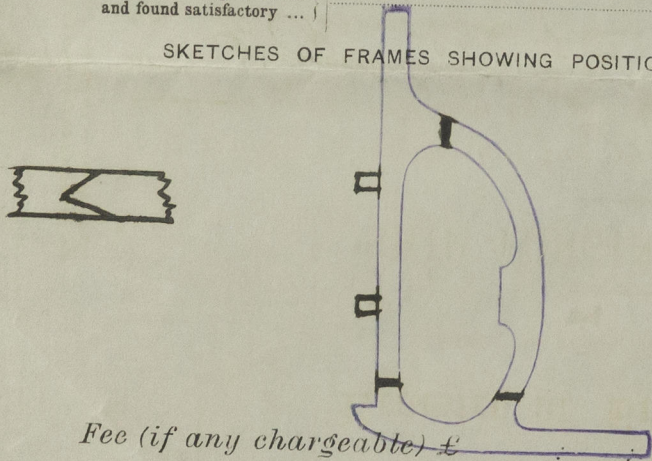

Fee (if any chargeable) £

To be paid at

* If of Iron, state whether scrap or puddled Iron. If of steel, state whether made on the Open Hearth process.



© 2020

Lloyd's Register
Foundation

SS. ELWY
NEWCASTLE-ON-TYNE

REPORT No 66671

14720-845500-175500



© 2020

Lloyd's Register
Foundation