


CAST STEEL STERNPOST

S.S. No. 826 v 839

SCALE 1" = 1'-0"


SCANTLING TO SUIT 9" DIA RIGGER STOCK

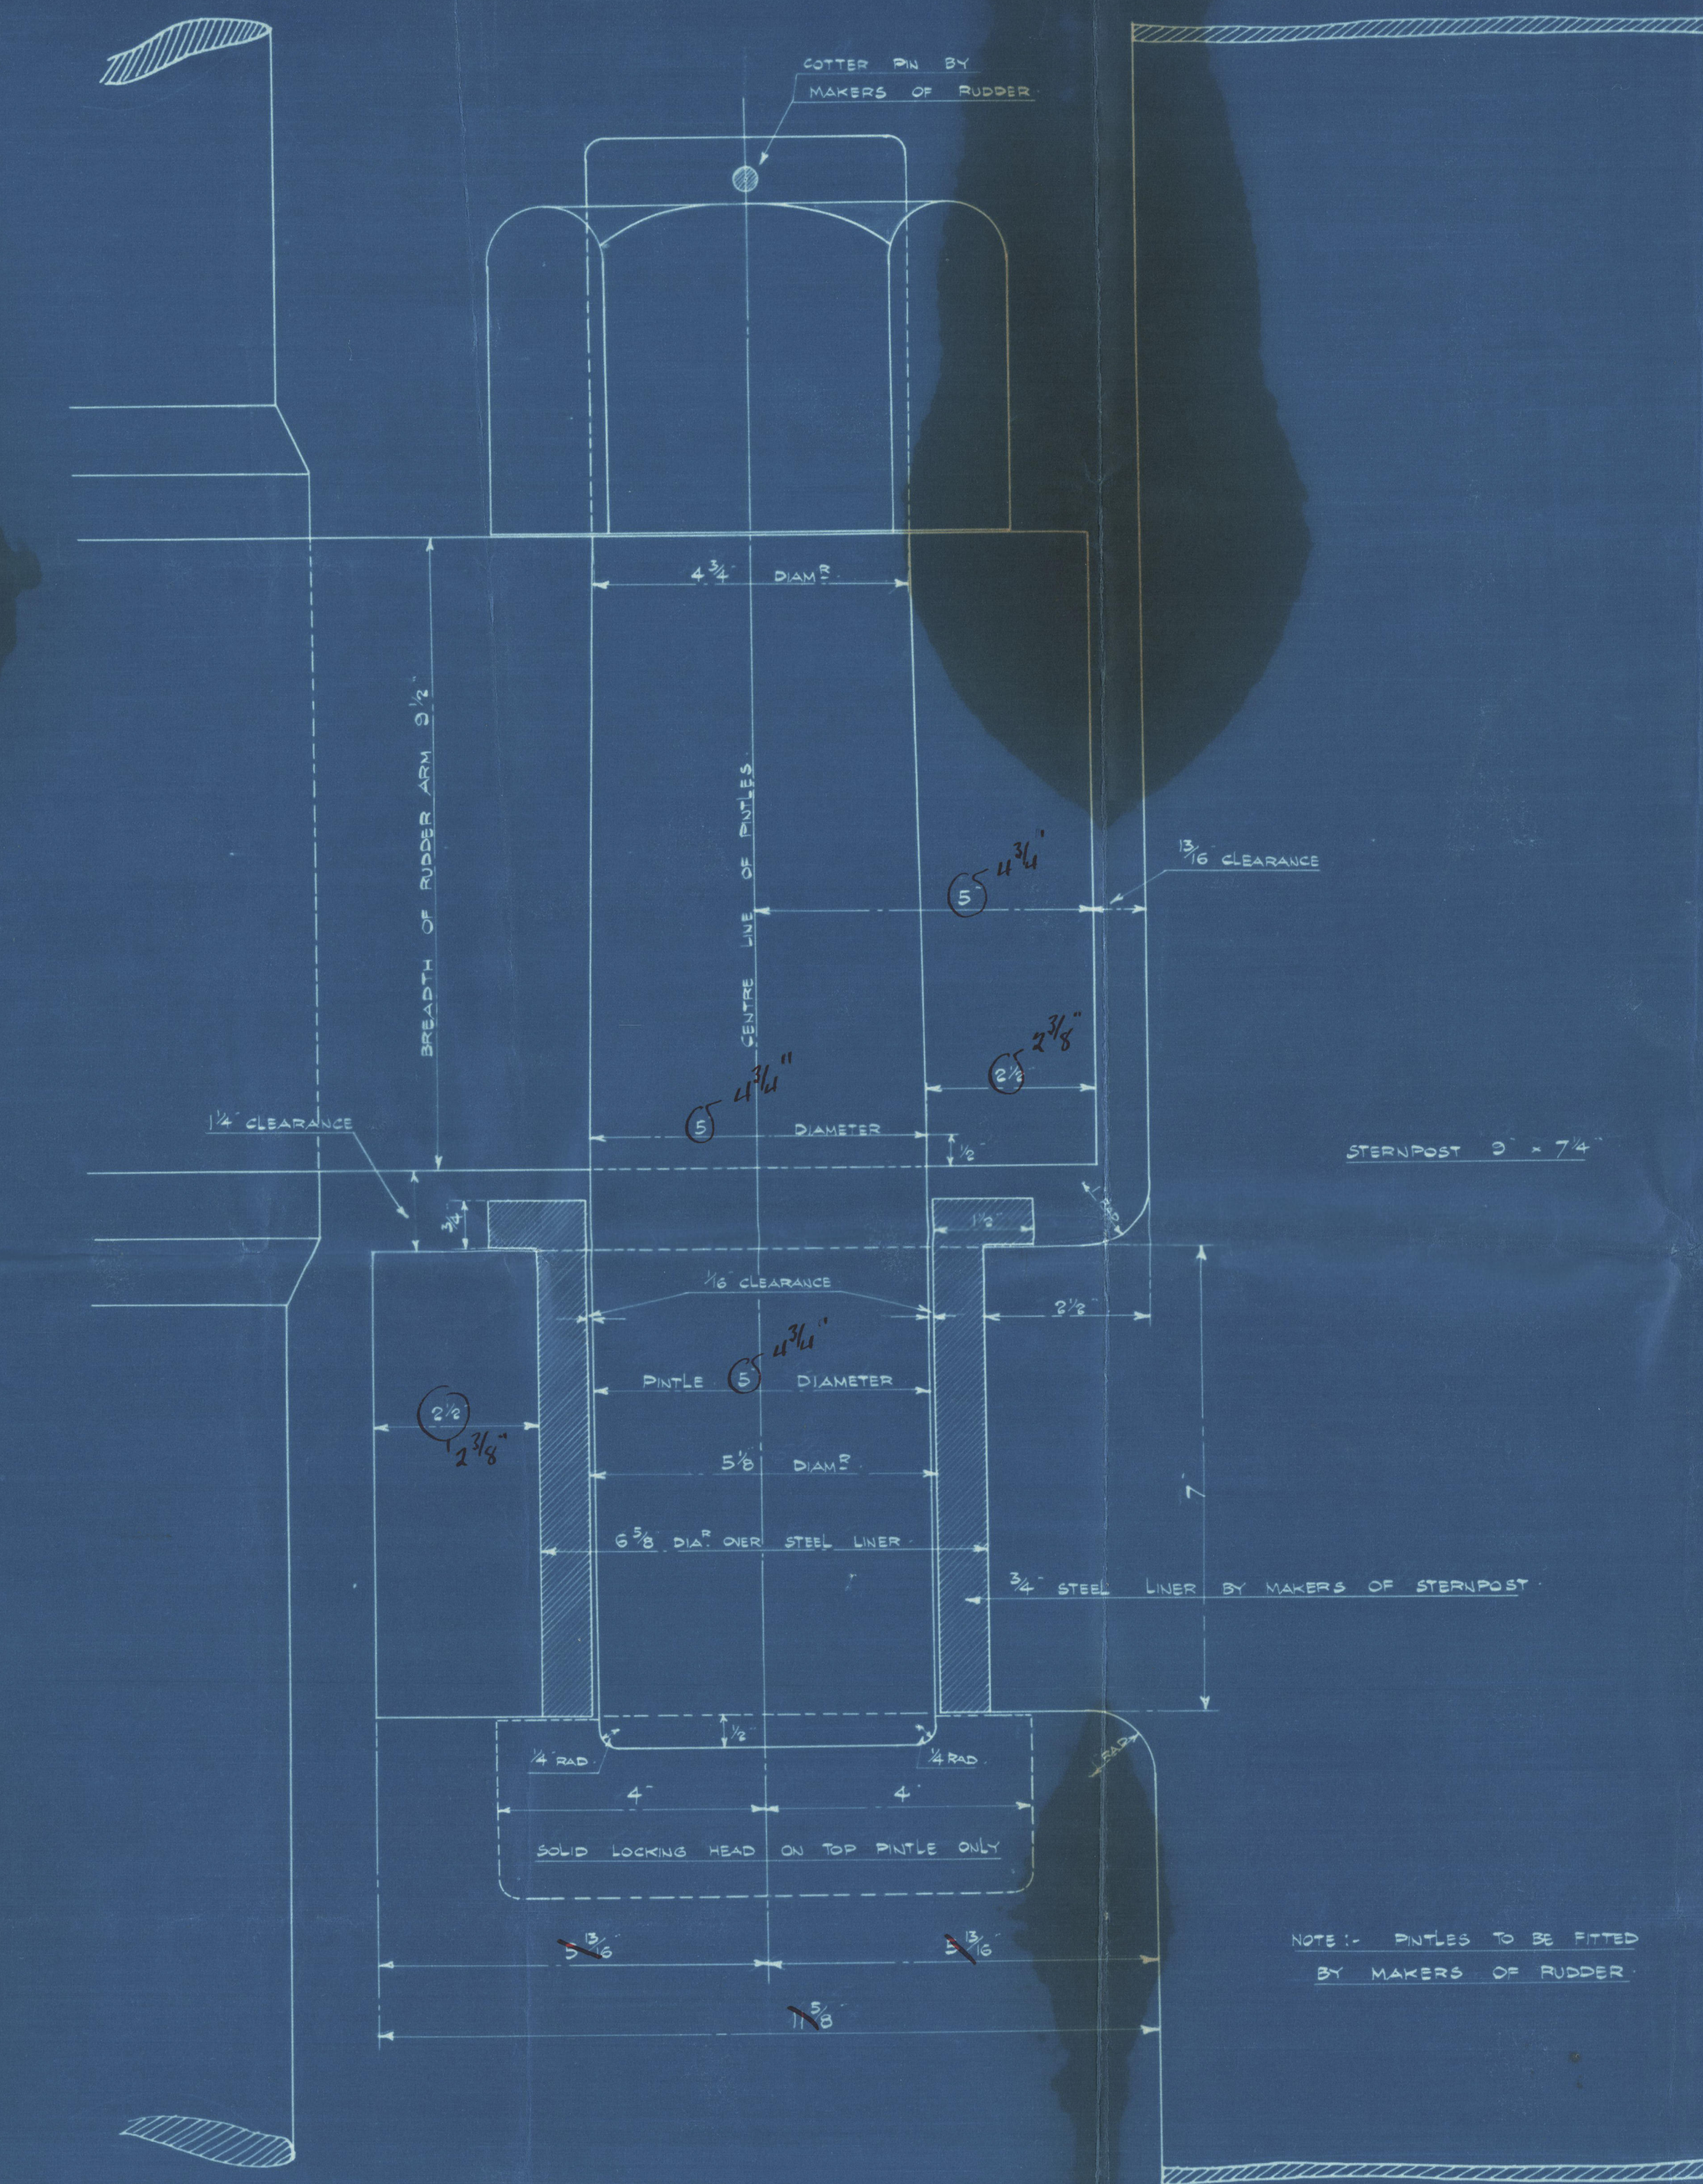

DETAIL SKETCH OF GUDGEON & PINTLE

SCALE HALF-SIZE

FOR BOTTOM GUDGEON SEE SEPARATE SKETCH

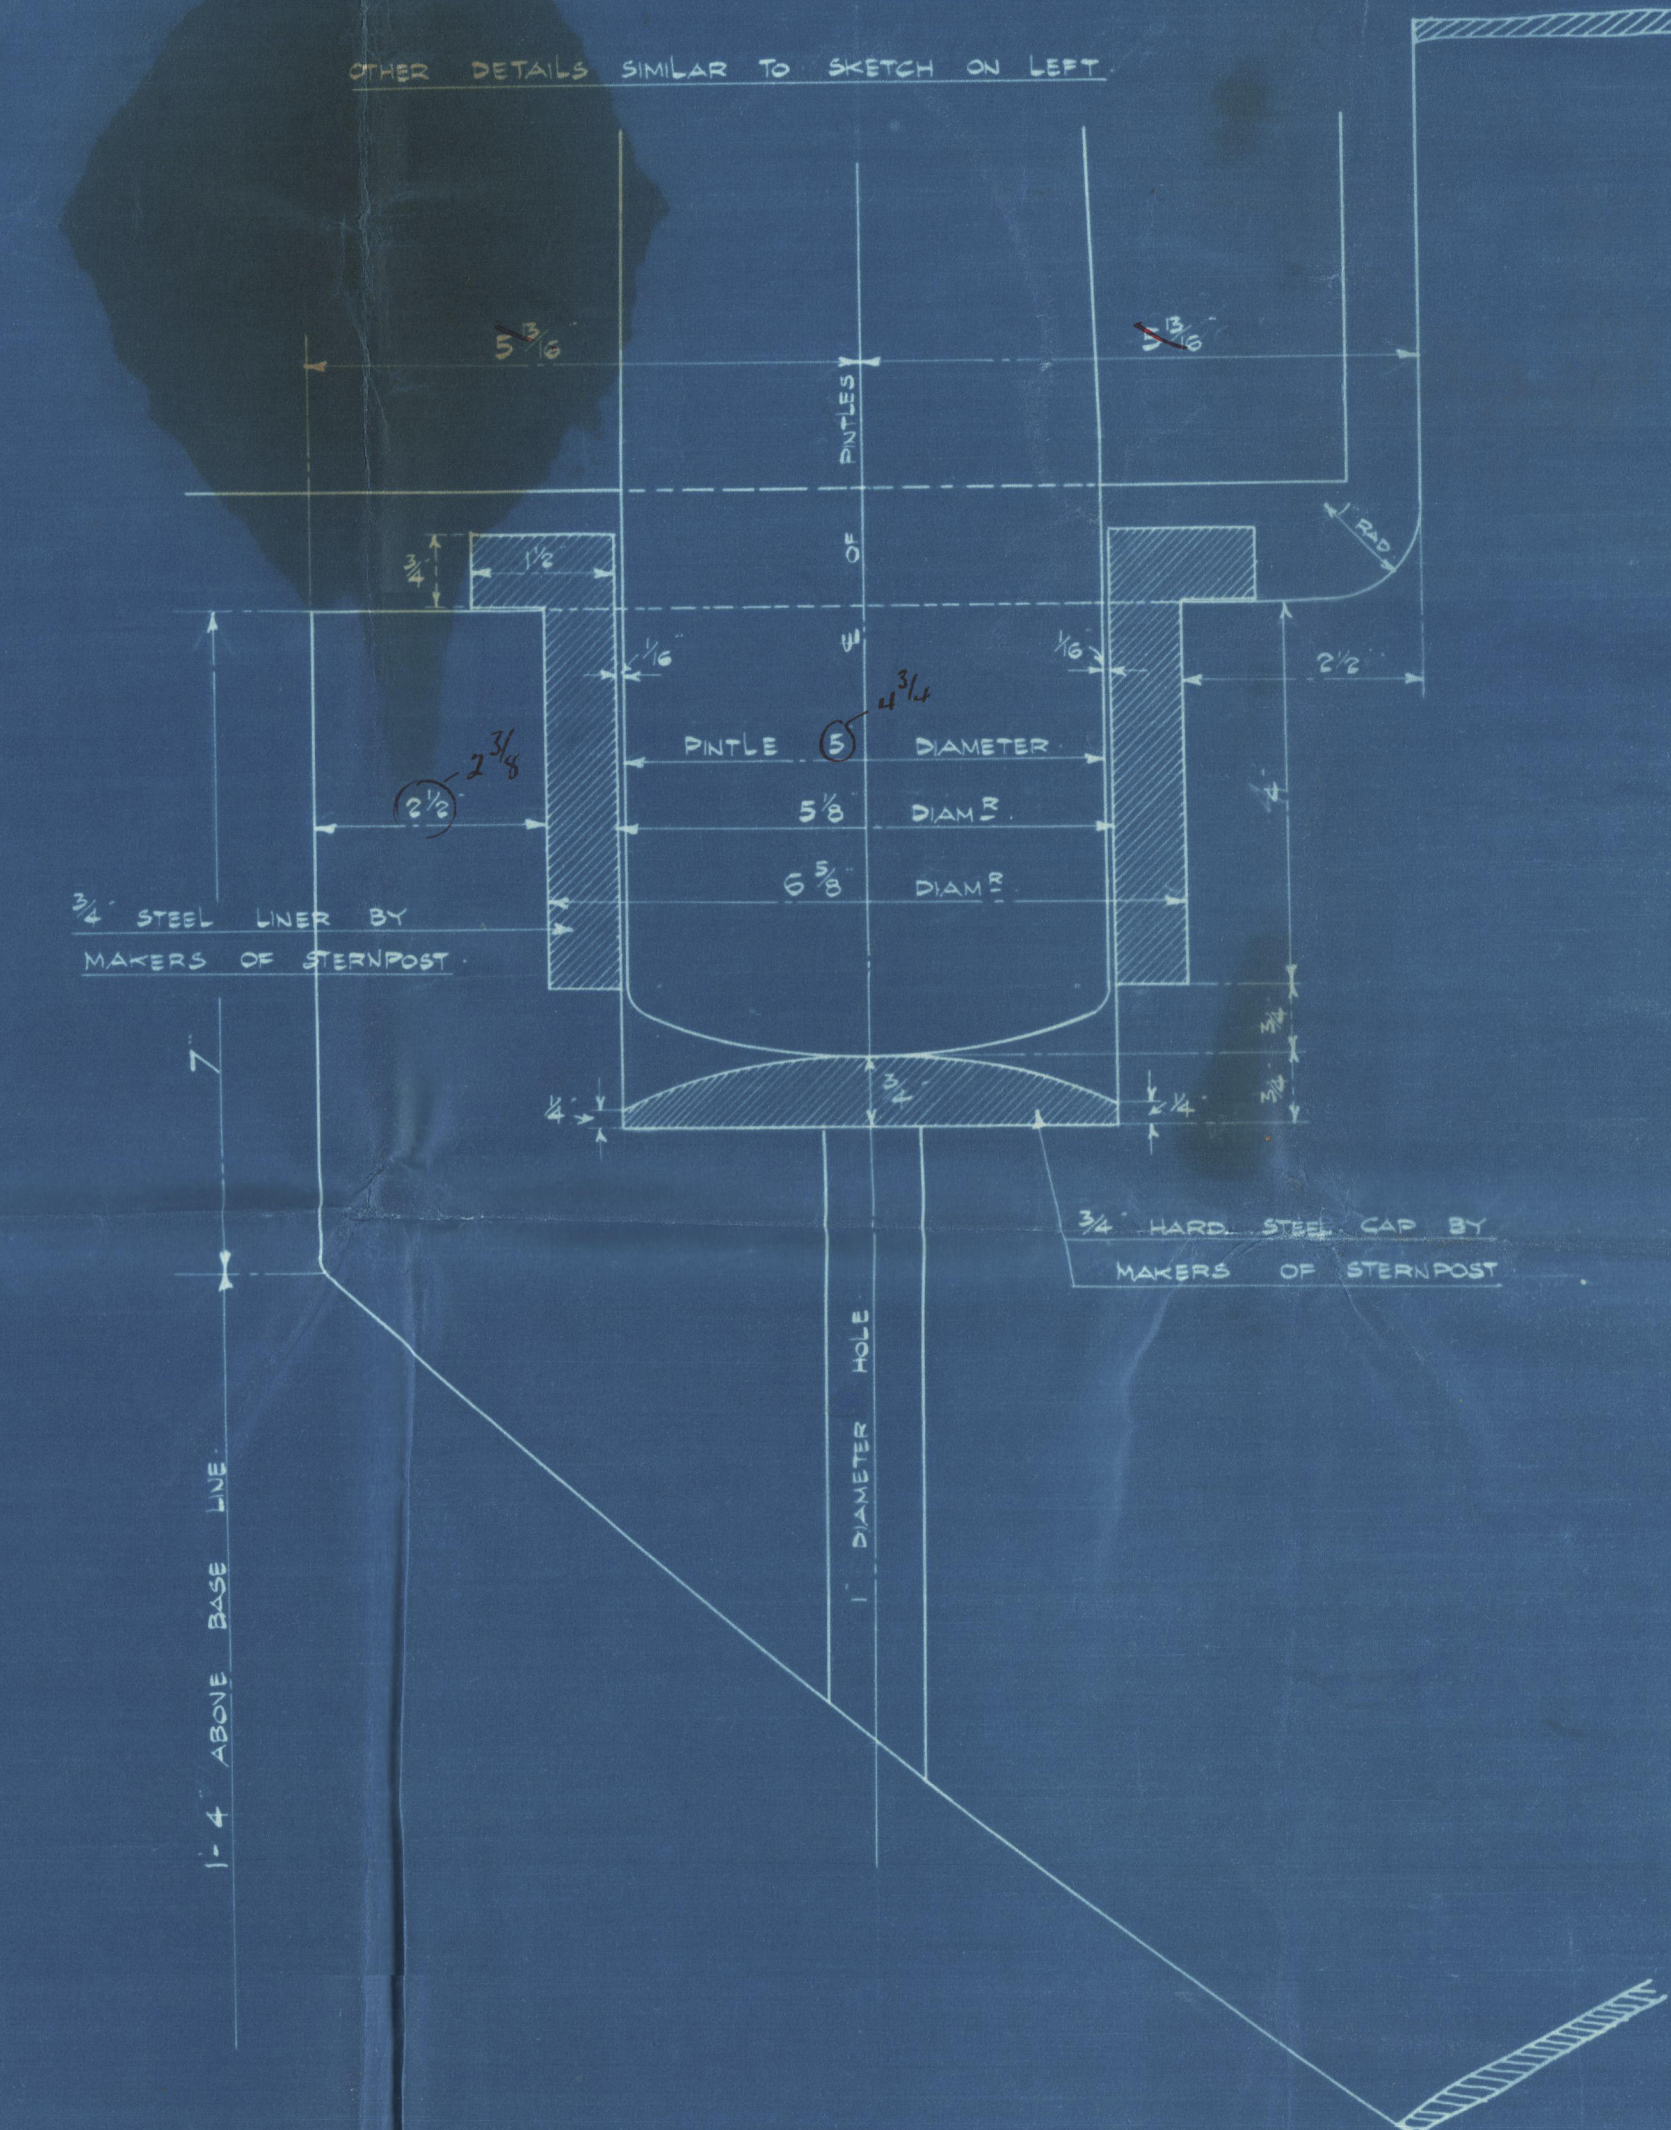

DETAIL SKETCH OF BOTTOM GUDGEON & PINTLE

SCALE HALF-SIZE

APPROVED FOR 826
LLOYD'S REGISTER OF SHIPPING
DATE 27.1.18

APPROVED FOR 839
LLOYD'S REGISTER OF SHIPPING
DATE 27.1.18

003549-003553-0001 Lloyd's Register Foundation

LITHGOWS LTD


N^o 826. v 859

STERN FRAME.

'FUKUTO' ^X
MARU'

826.


-

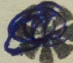S.S. "Greyvale" 

Greenock Report N^o 19090.

S.S. "Darnoch"

Genl. Trust Entry Report N^o 20174.

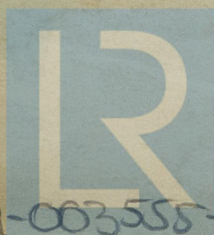

© 2020

Lloyd's Register
Foundation

003549-003555-0197