

SECTION AT FN#48
(LOOKING AFT)
OTHERS SIMILAR EXCEPT AS SHOWN.

6' above base line


- hand plotting

NOTE:
BOTH SIDES SYMMETRY.

REFERENCE
SKETCHED AND DRAWN
AT S.S.I.C. SASEBO.
JAPAN
FEB. 1952


LONG. BHD

F59 BHD STIFF.

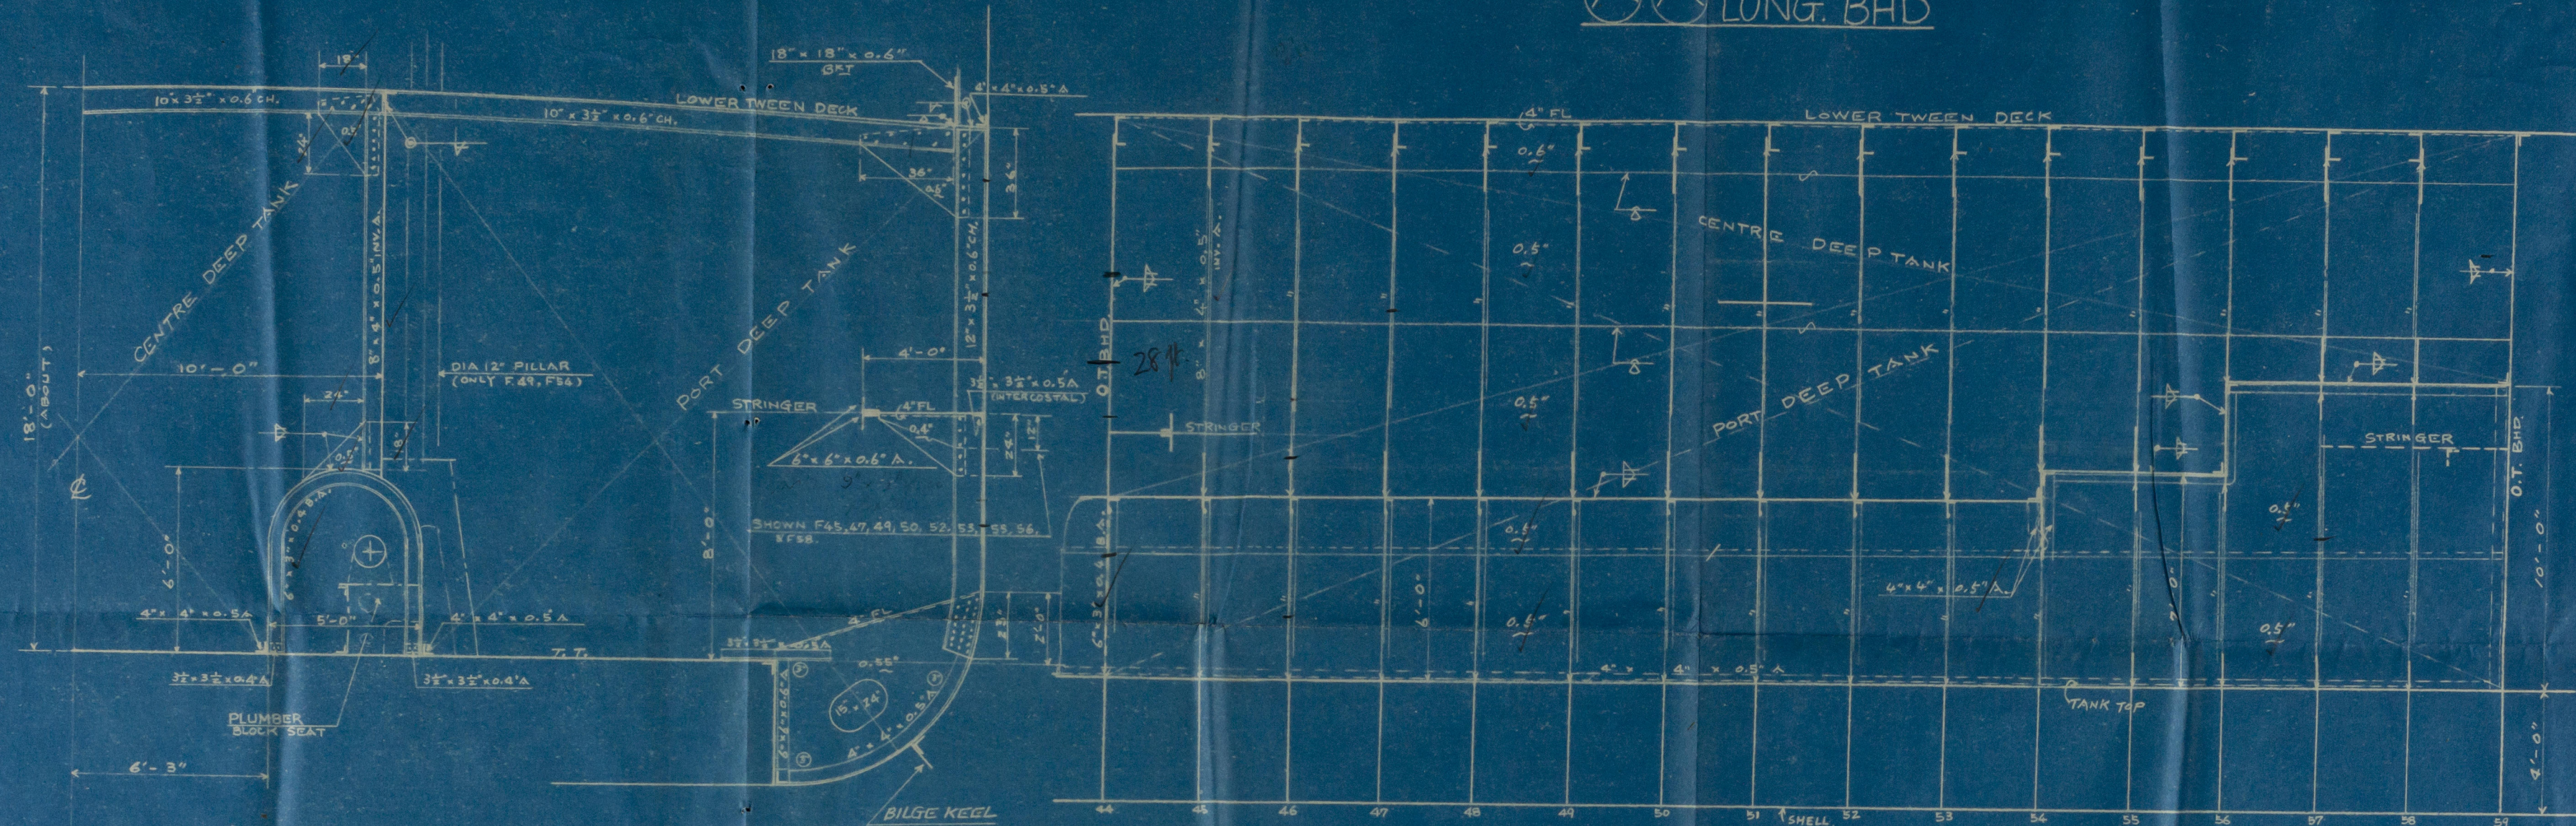

SECTION AT FN#51
(LOOKING AFT)

STRINGER PLAN

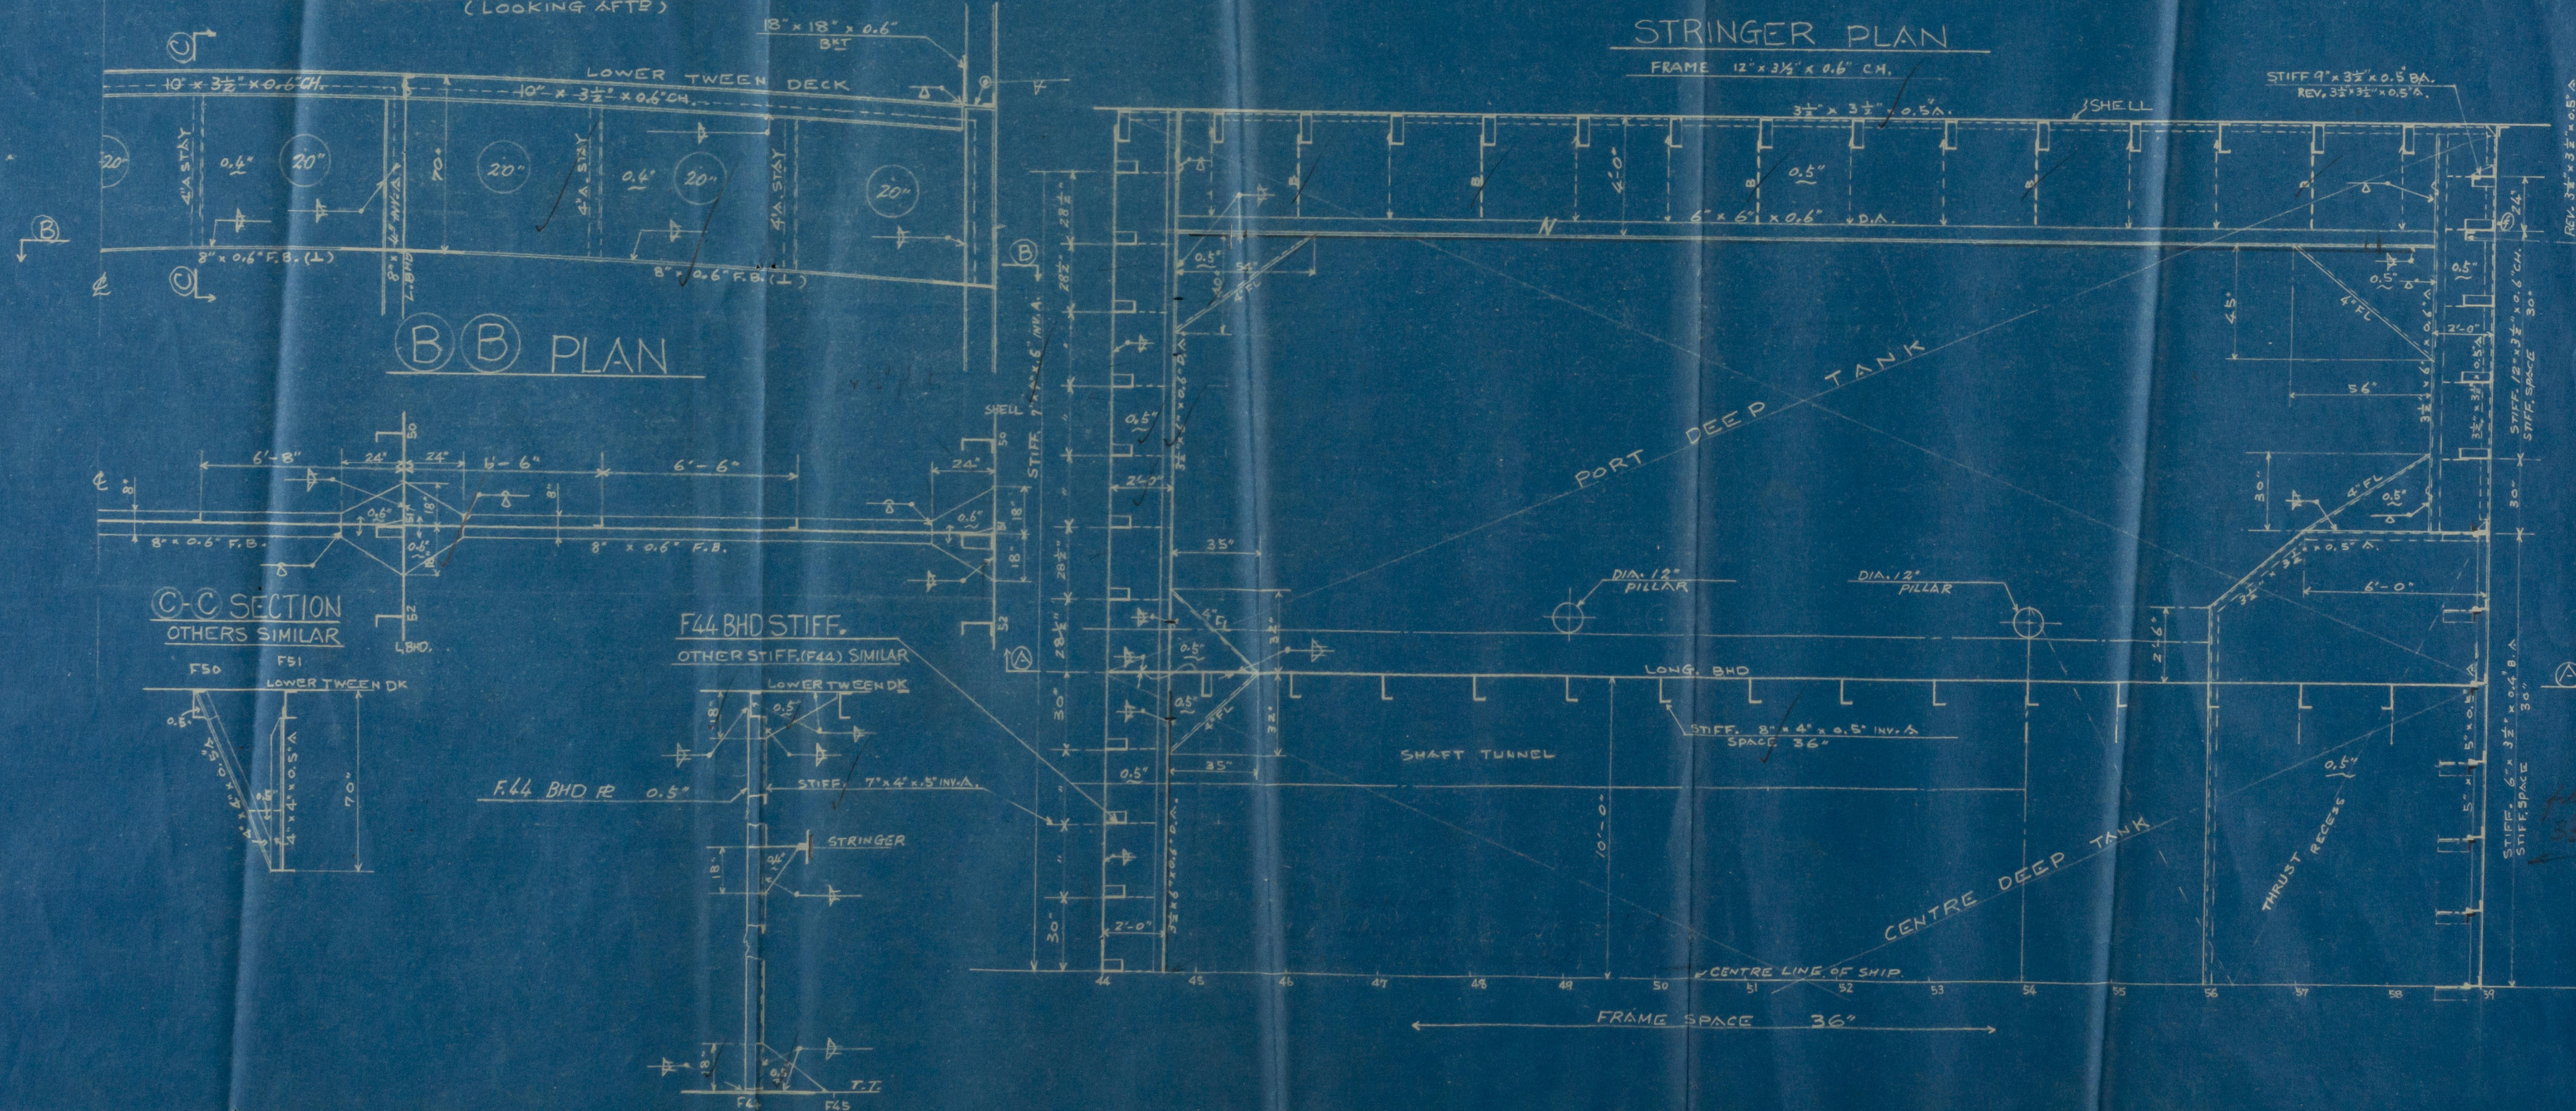

NAME OF SHIP SULA
DEEP TANK
CONSTRUCTION
UNDER NO. 4 HOLD
(SKETCHED PLAN)

SCALE 1/4" = 1'-0"

APPROVED
IN CHARGE
CHECKED BY
DRAWN BY
ISSUED
WORK
CLASS
PLAN NO.

FEB. 7. 1952
250 732
SH 26-86

TO LLOYD



003556-003566-0049



© 2020

Lloyd's Register
Foundation