


BELONGS TO AMSTERDAM REPORT
No. 24142

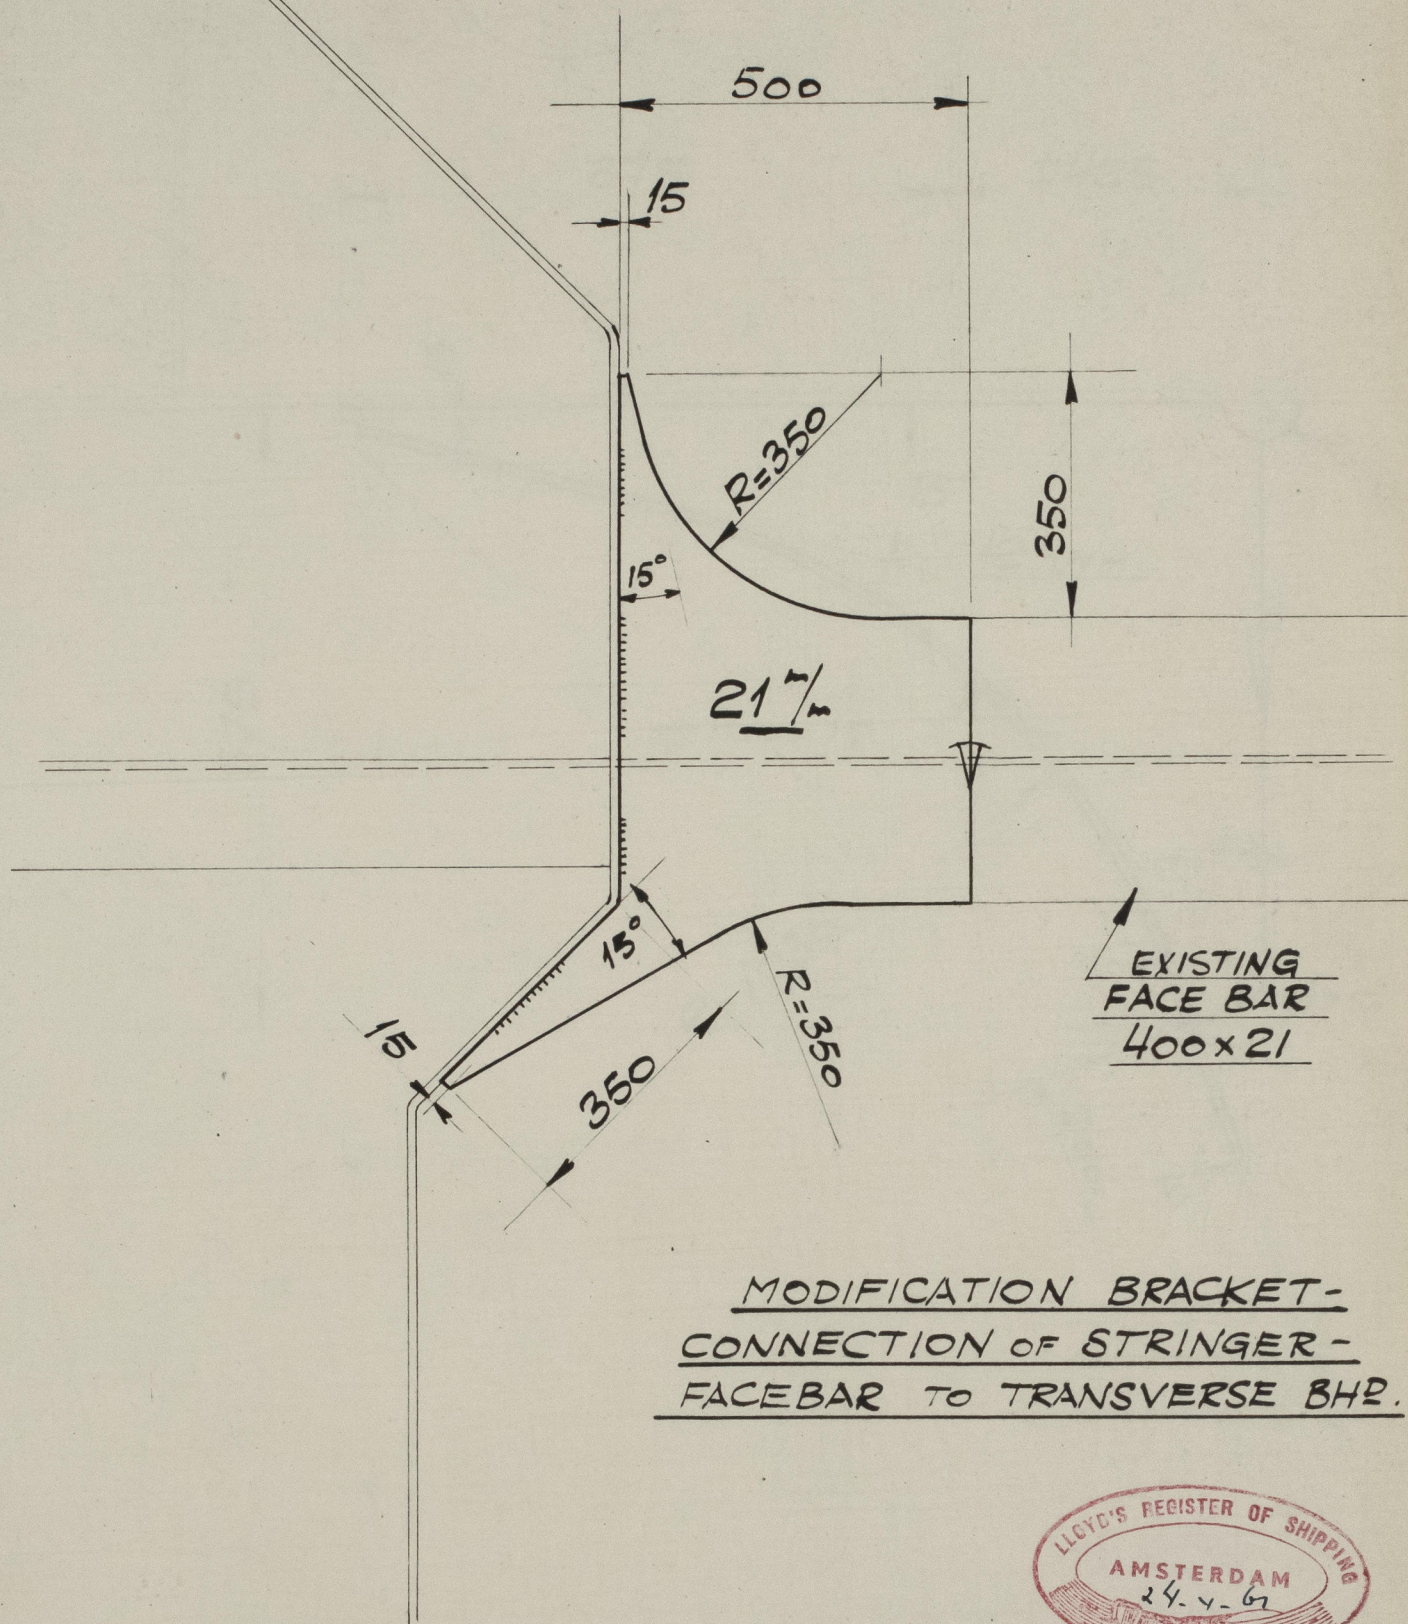

MODIFICATION BRACKET-
CONNECTION OF STRINGER-
FACEBAR TO TRANSVERSE BHD.



Handwritten signature

SCALE 1:10



N.D.S.M.

M.T. ATLANTIC QUEEN

©BLAD No. 3126

AANTAL BLADEN



Lloyd's Register
Foundation

003567-003571-0200