


BELONGS TO AMSTERDAM REPORT  
No. 24142

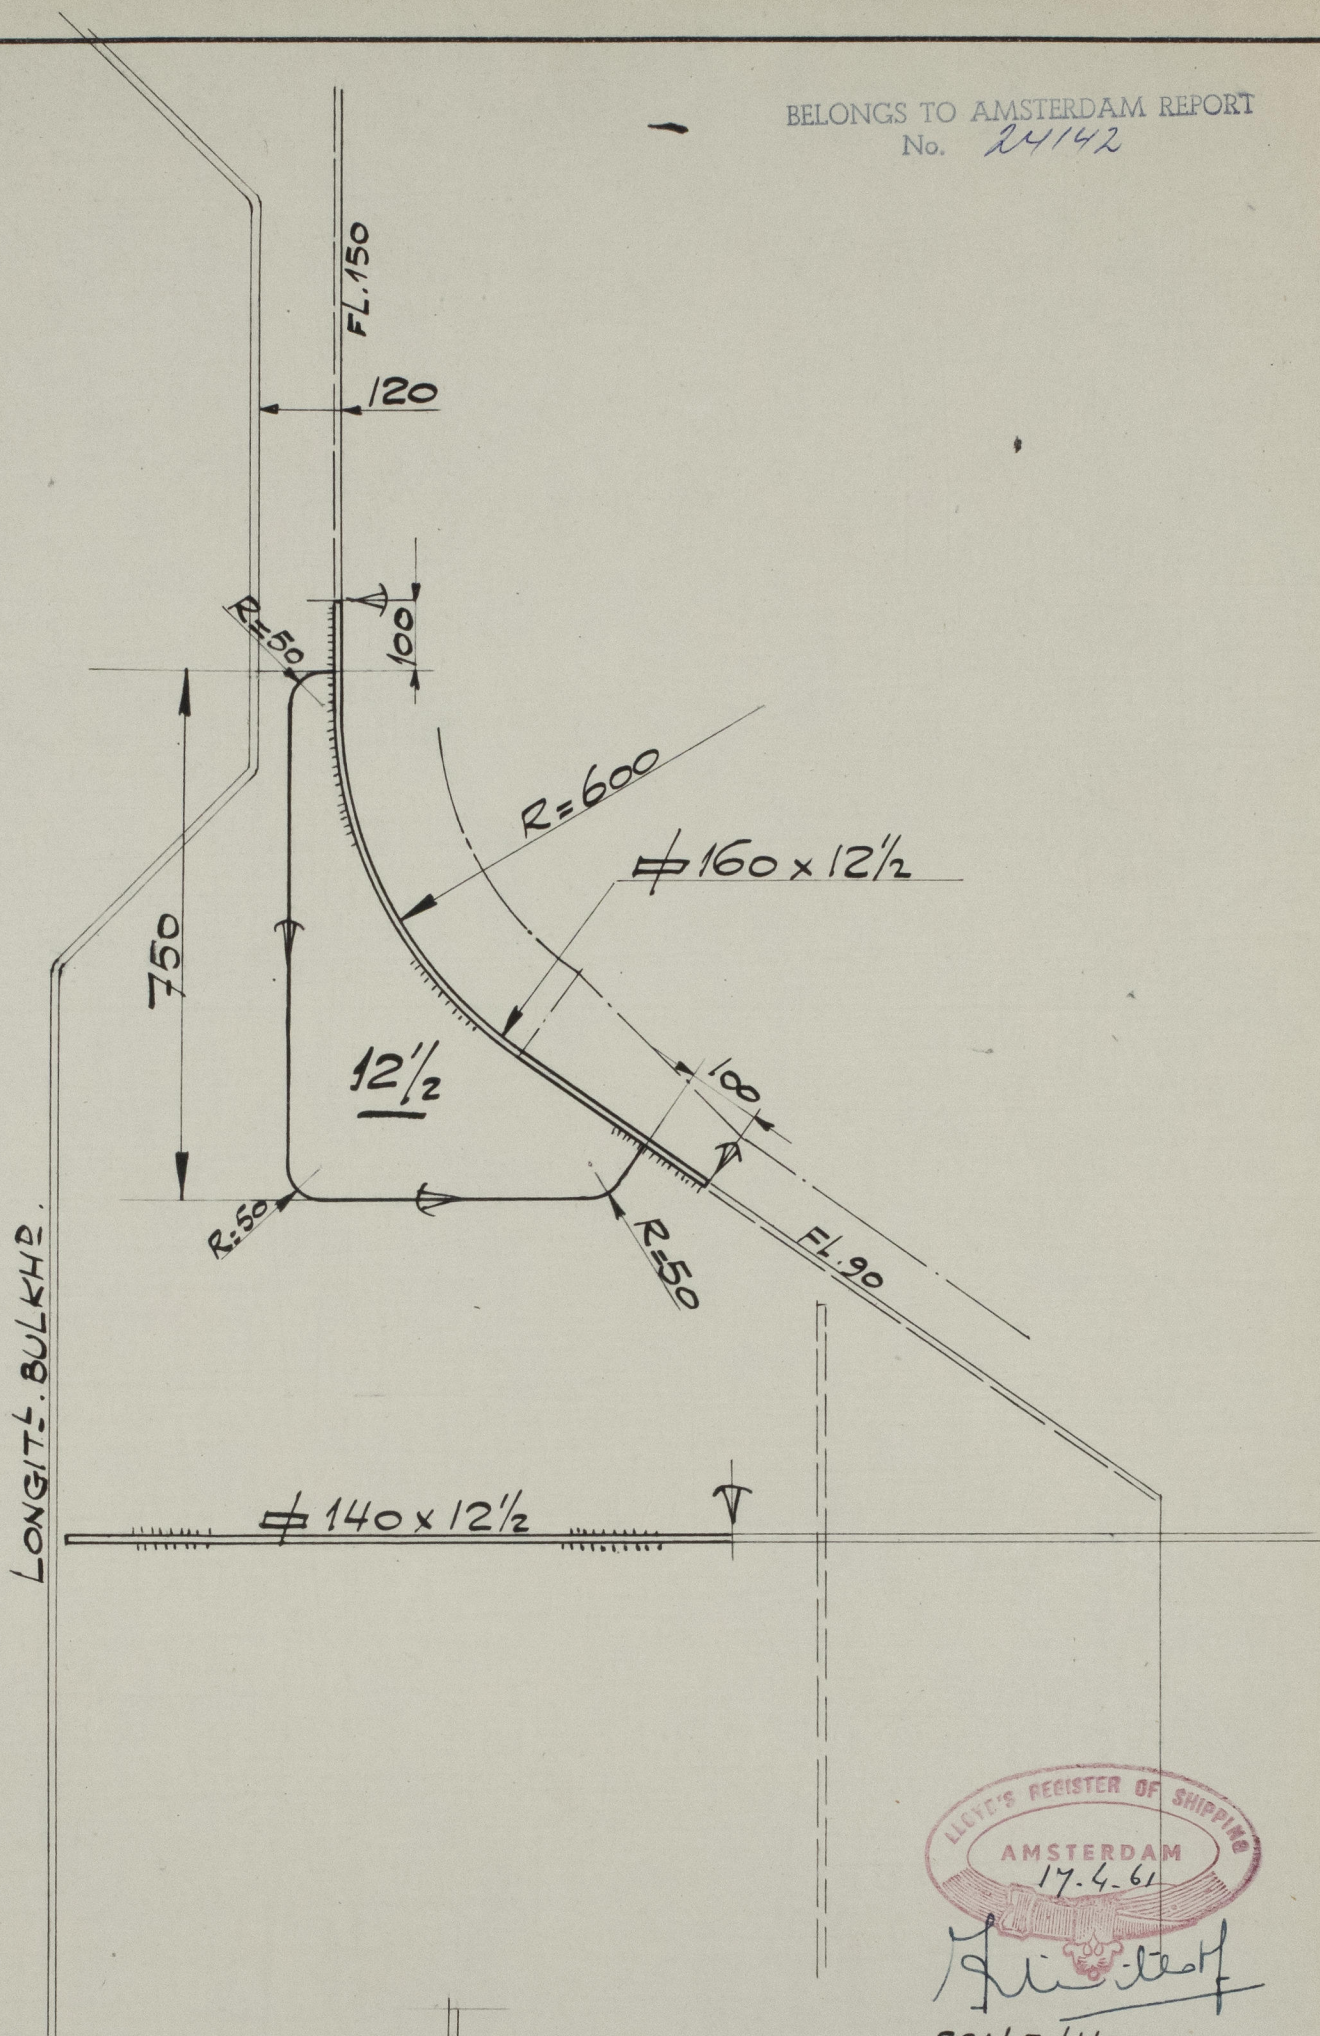

SCALE 1:10



**N.D.S.M.**

M.S. ATLANTIC QUEEN  
MODIFICATION TO BRACKETS AT  
TRANSV. WEBFRAMES IN CR. TANKS

BLAD No. 3125

AANTAL BLADEN

003567-003571-0204