

27 APR 1953

# Lloyd's Register of Shipping.


Ship's Name S. S. STRAIDE

Official No. 136360

Memorandum of alterations reported since ship was surveyed for assignment of Load Lines in \_\_\_\_\_

*a small hatchway on the starboard side of the foreboard deck abaft the forecastle to store at fwd. end of hold has been fitted at some previous occasion and the coaming has now been raised to 24" above the deck. Efficient covers, tarpaulins, cleats and battening arrangements are provided*

*J. Dickerson  
Belfast  
23-4-'53*

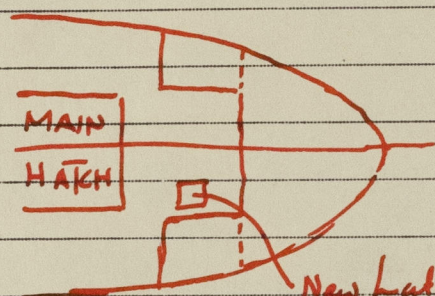

*New Hatch  
referred to above.*

*LIC*

29 APR 1953



© 2021

Lloyd's Register  
Foundation

003572-003580-0078