


No 796 G.K.

SCALE $\frac{1}{4}" = \text{ONE FOOT.}$

PLAN NO 21. DATE. 12/1/27.


APPROVED
LLOYDS REGISTER OF SHIPPING
Mantegomark per 4 Patti
RATE 20-1-27

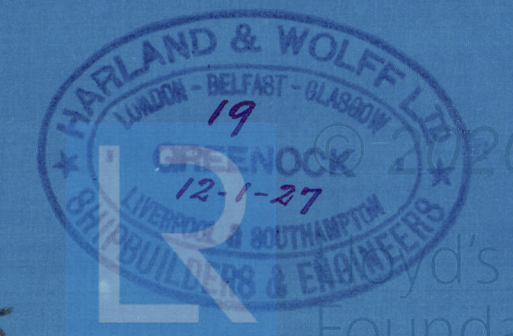

003581-003590-0265

MAIN. DECK. PLAN.

HARLAND AND. WOLFF'S. No 796

T. S. T. "LAHEJ."

GRK. RPT. NO. 18462.

RETAIN



© 2020

Lloyd's Register
Foundation

003581-003590-0265