

M.T. PARNASOS ex. BUCCINUM


Proposed alteration into dry cargo carrier

Length betw. pp. 150.87m
Breadth moulded 20.42
Depth moulded 10.41

For Class 100A1 the scantling being suitable for the estimated above draught of 25.89' measured above top of keel

10 210
3 480
6 730
280
6 450

80

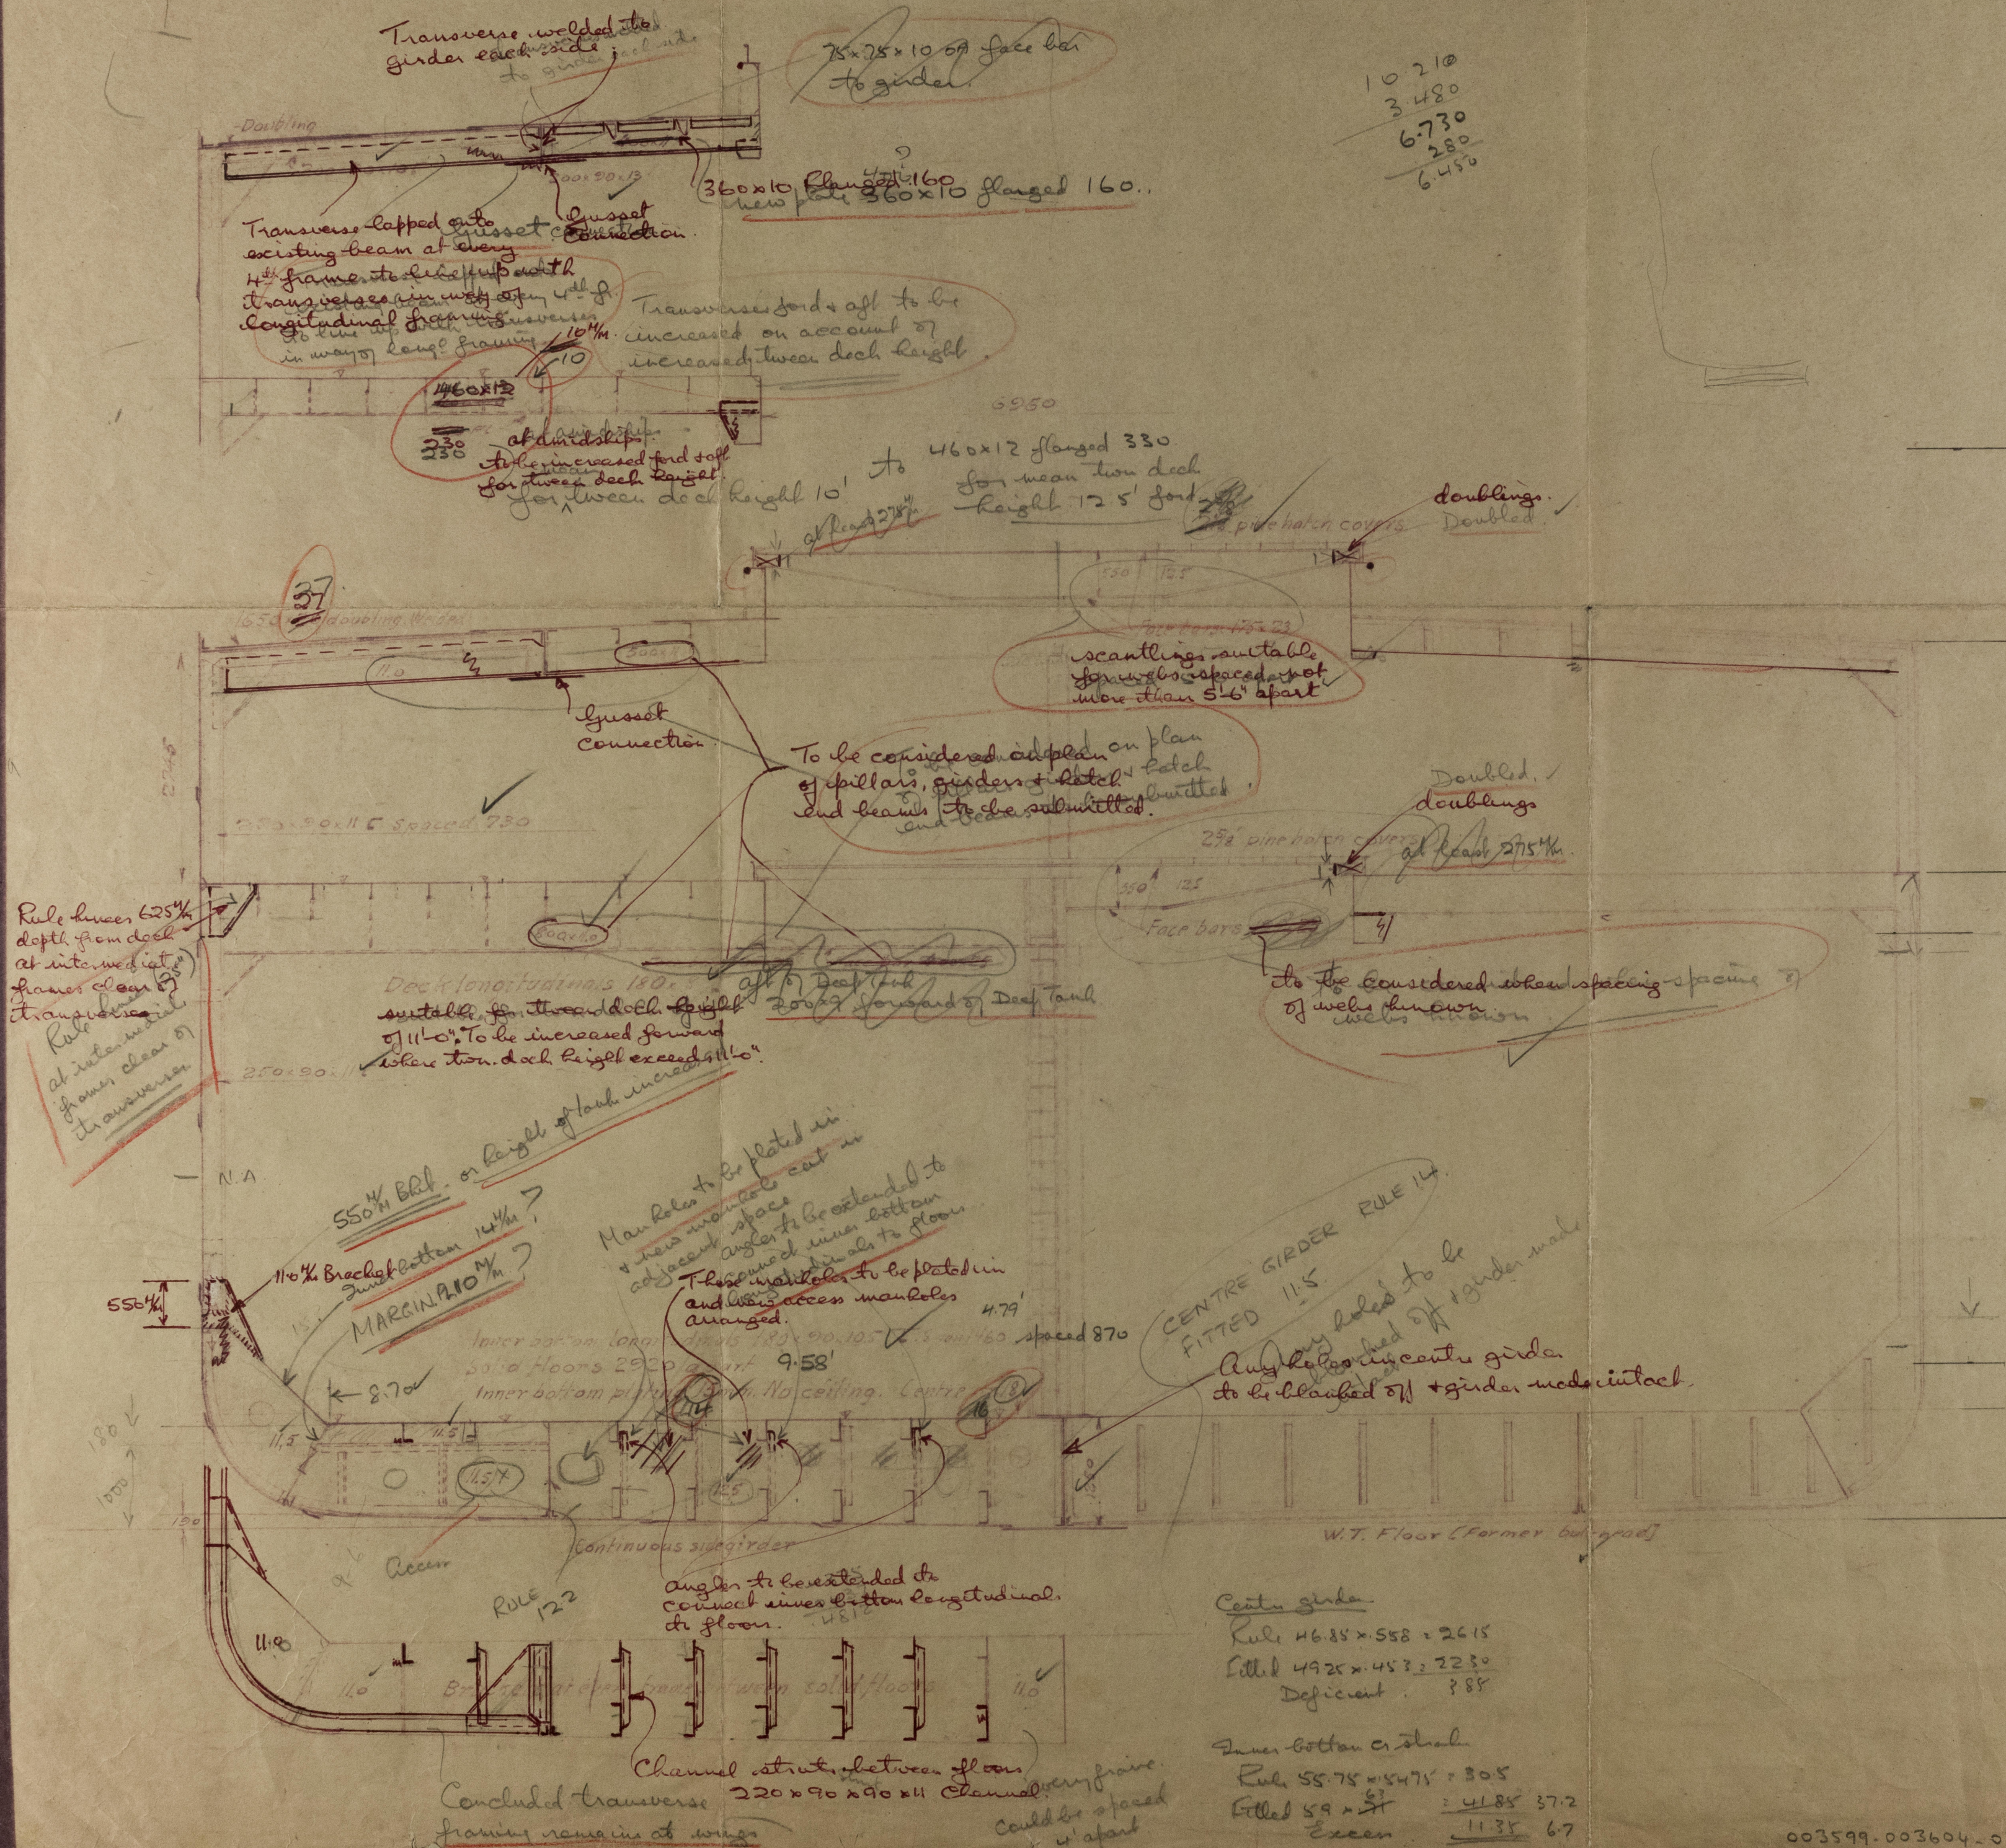

Office

Amey, Robertson & Co. Ltd.

M.T. PARNASOS ex. BUCCINUM

Proposed alterations for conversion into dry cargo carrier

Lloyd's Register Foundation