

BULKHEAD 54
SCALE 1/2" = FOOT

Remaining Bulkheads
 to Rule requirements

EQUIPMENT NUMERALS

$L \times (B+D) = 3275$
 $32 \times 2 \times 25 = 72$ R.Q.D.
 $14 \times 4 \times 5 \times 75 = 47.25$ FOGGLE
 $27 \times 6 \times 25 \times 5 = 84.375$ E.B. CASING
 $35 \times 8 \times 75 = 21$ BRIDGE
3499.625 EQUIPMENT NUMERALS

SCANTLING NUMERALS

TRANSVERSE $B+D = 32.83$ ✓


LONGITUDINAL $(B+D) \times L = 3275$ ✓

PROPORTIONS

THIS IN LENGTH	=	4'467
AS	=	9'5
"a"	=	9'5

RIVETING

1" DIA RIVETS TO BE USED IN STERN POST. 1" DIA RIVETS IN STEM POST.
IN JOGES & BUTTS OF KEEL & SHEER STRAKE. 3/4" DIA RIVETS TO BE USED ALSO BILGE STRAKE.
ELSEWHERE 5/8" DIA RIVETS TO BE USED. BUTT LAPS OF KEEL PLATE DOUBLE
RIVETED. BUTT LAPS OF SHELL & DECK PLATING DOUBLE RIVETED
BULWARTS LAPPED BY SINGLE RIVETED.

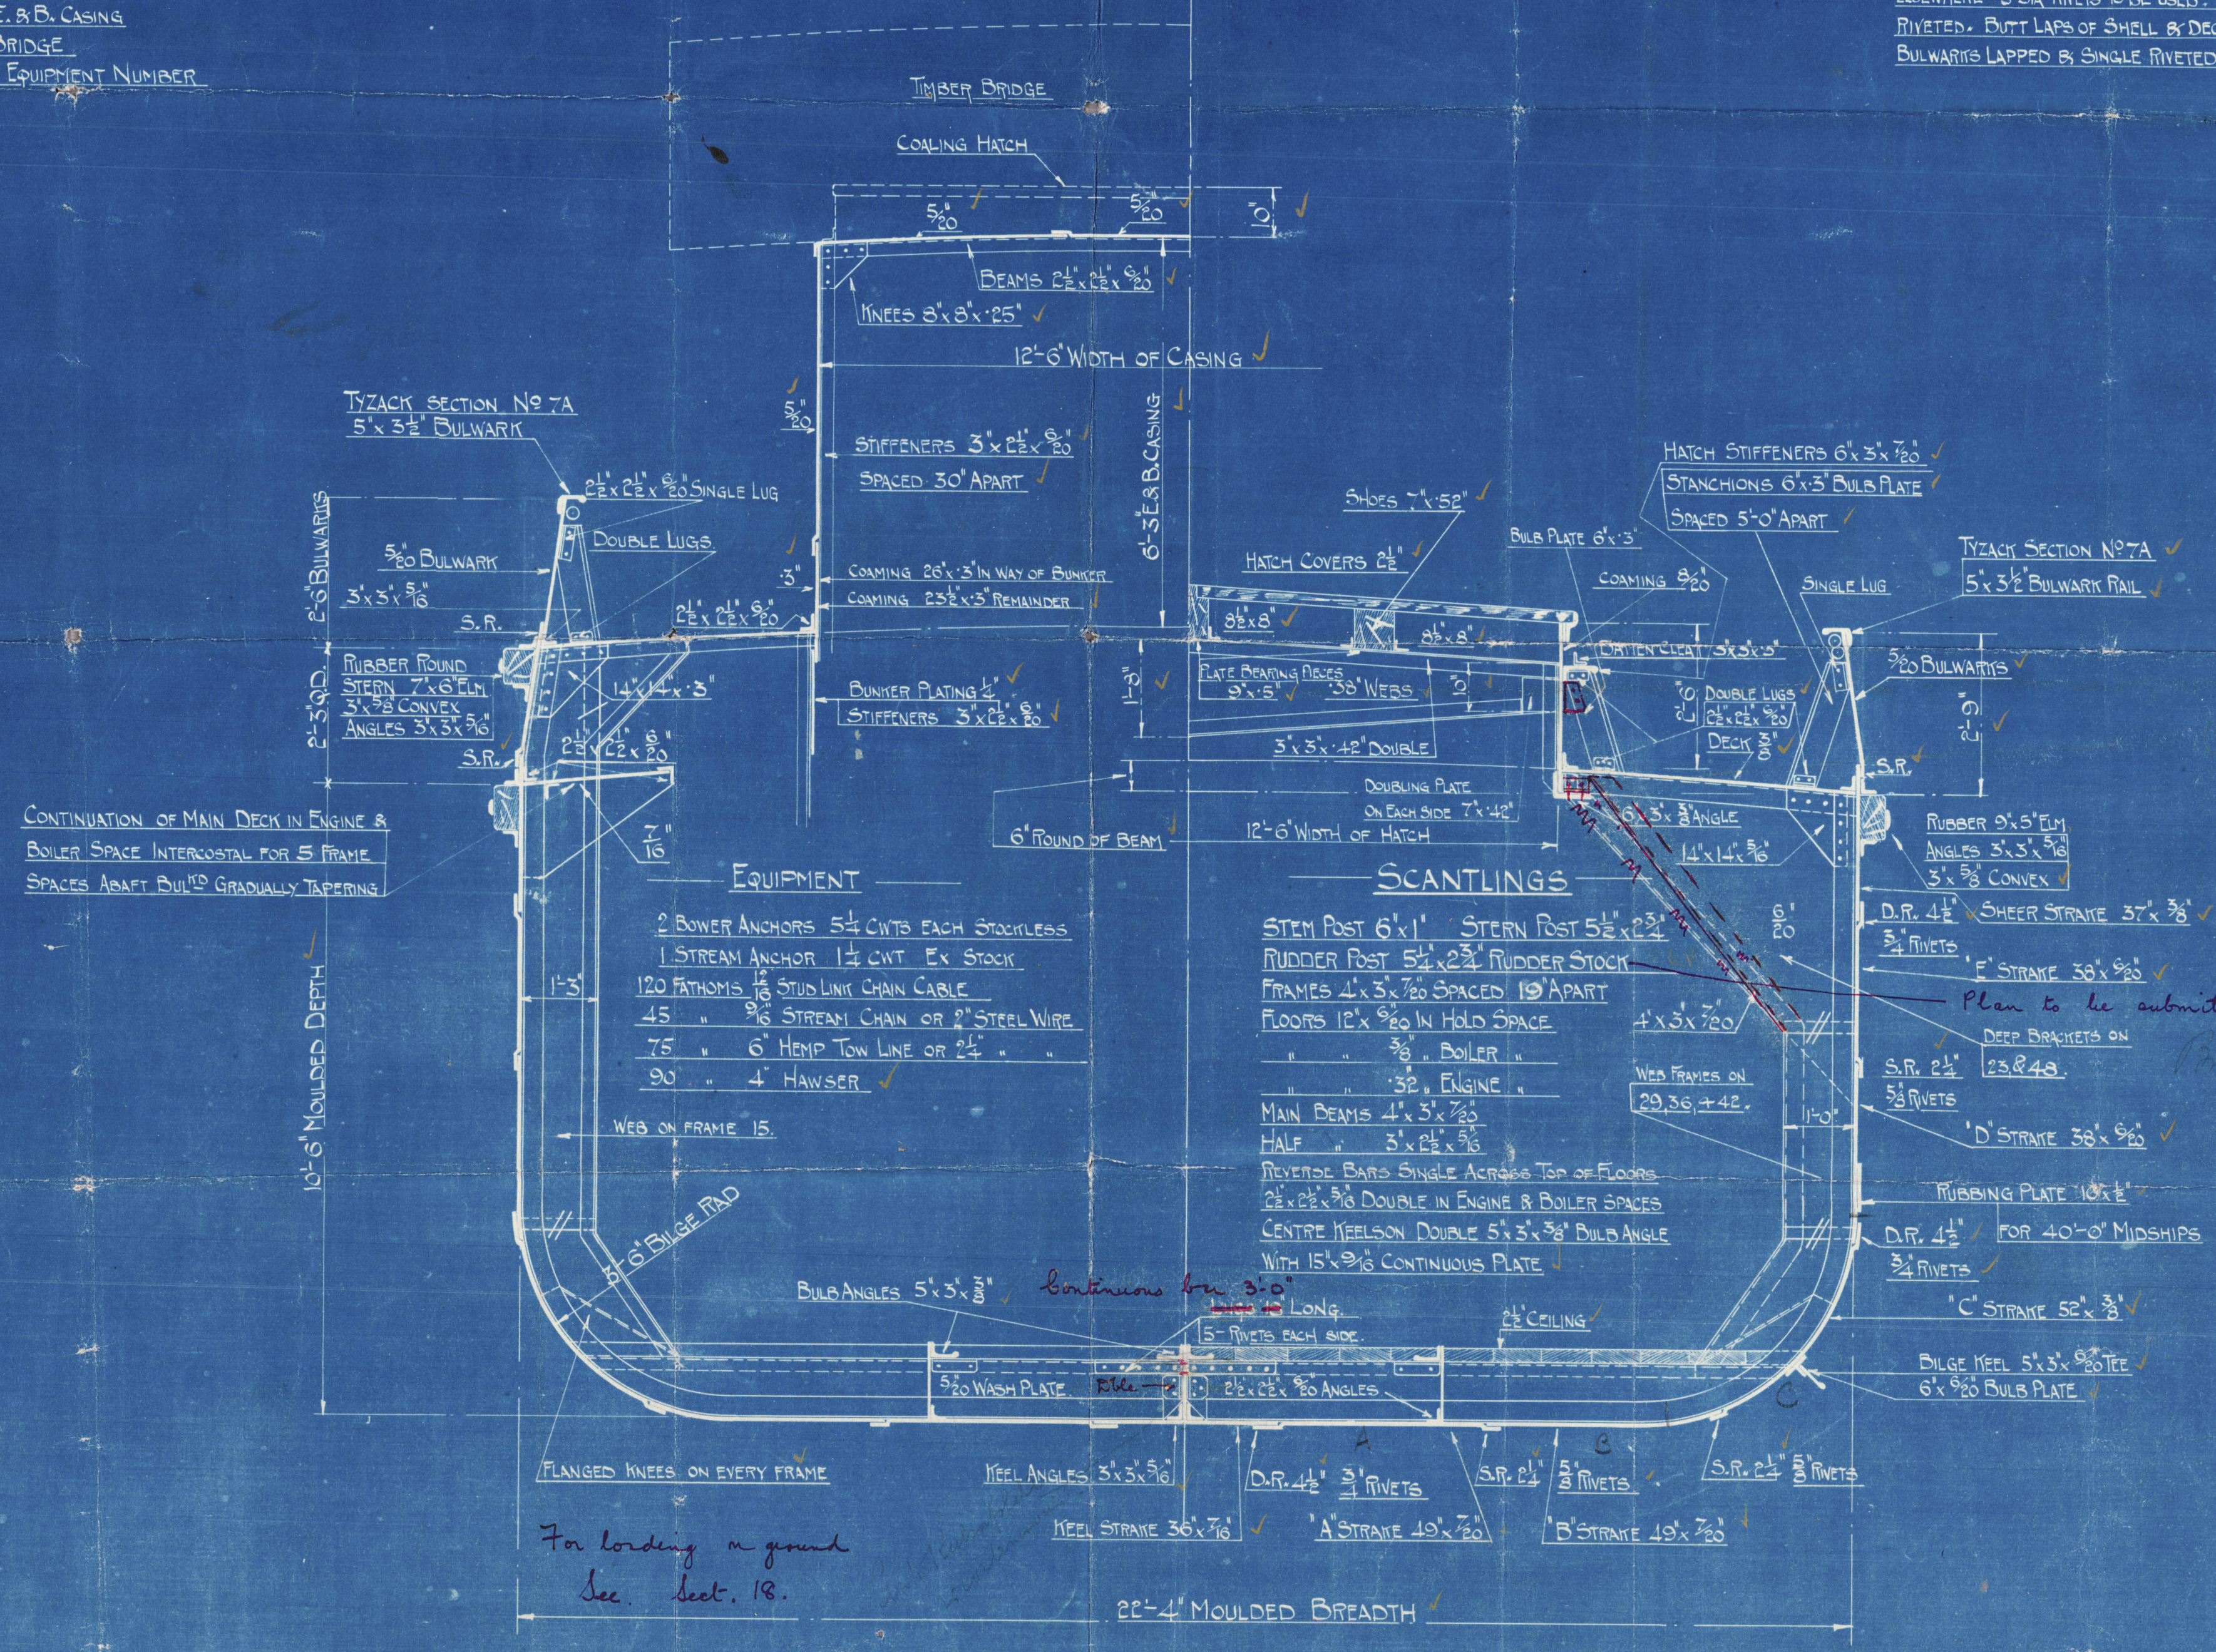

DIMENSIONS

LENGTH O.A — 103'-9"

" B.P — 99'-9"

BREADTH M.B — 22'-4"

DEPTH M.D — 10'-6"

PRINT 5109
Date 1-9-24

MIDSHIP SECTION OF STEEL COASTING STEAMER

SCALE $\frac{1}{2}" = 1 \text{ FOOT}$

G. L. P.
Luis. 3/9/20

WJ YARWOOD & SONS LTD
THE DOCK
NORTHWICH DATE :-
JOB N^o 345
DRG N^o 2250/A3
DRAWN BY
TRACED BY
CHECKED BY
INDEXED BY

003605-003610-003611

Amended Indulgence Letter.

James James.

Jeru 2. 345.

S. S. *Swazi*

LIVERPOOL.

Report No. *92822.*

RETAIN



© 2020

Lloyd's Register
Foundation

003605-003610-0003