

13/4/69
4617

SHIP Nos 384-5 & 6.

410'-0" x 56'-6" x 37'-4" UPPER DK. 28'-4" TO 2ND DK. (LEVEL FORE & AFT.)

MIDSHIP SECTION.


ALL SECTIONS TO 1924 STANDARD.

SCALE: 1/2" = ONE FOOT.

TO CLASS LLOYDS 100 A1 "WITH FREEBOARD" (COMPLETE SUPERSTRUCTURE WITH TONNAGE OPENING.)

NUMERALS

$L \times D$	$= 410 \times 36.33$	$= 14897$
$L \times (B+D)$	$= 410 \times 92.83$	$= 38061.7$
L/D	$= 410/37.33$	$= 10.98$
d (Margin)		$= 24.75$

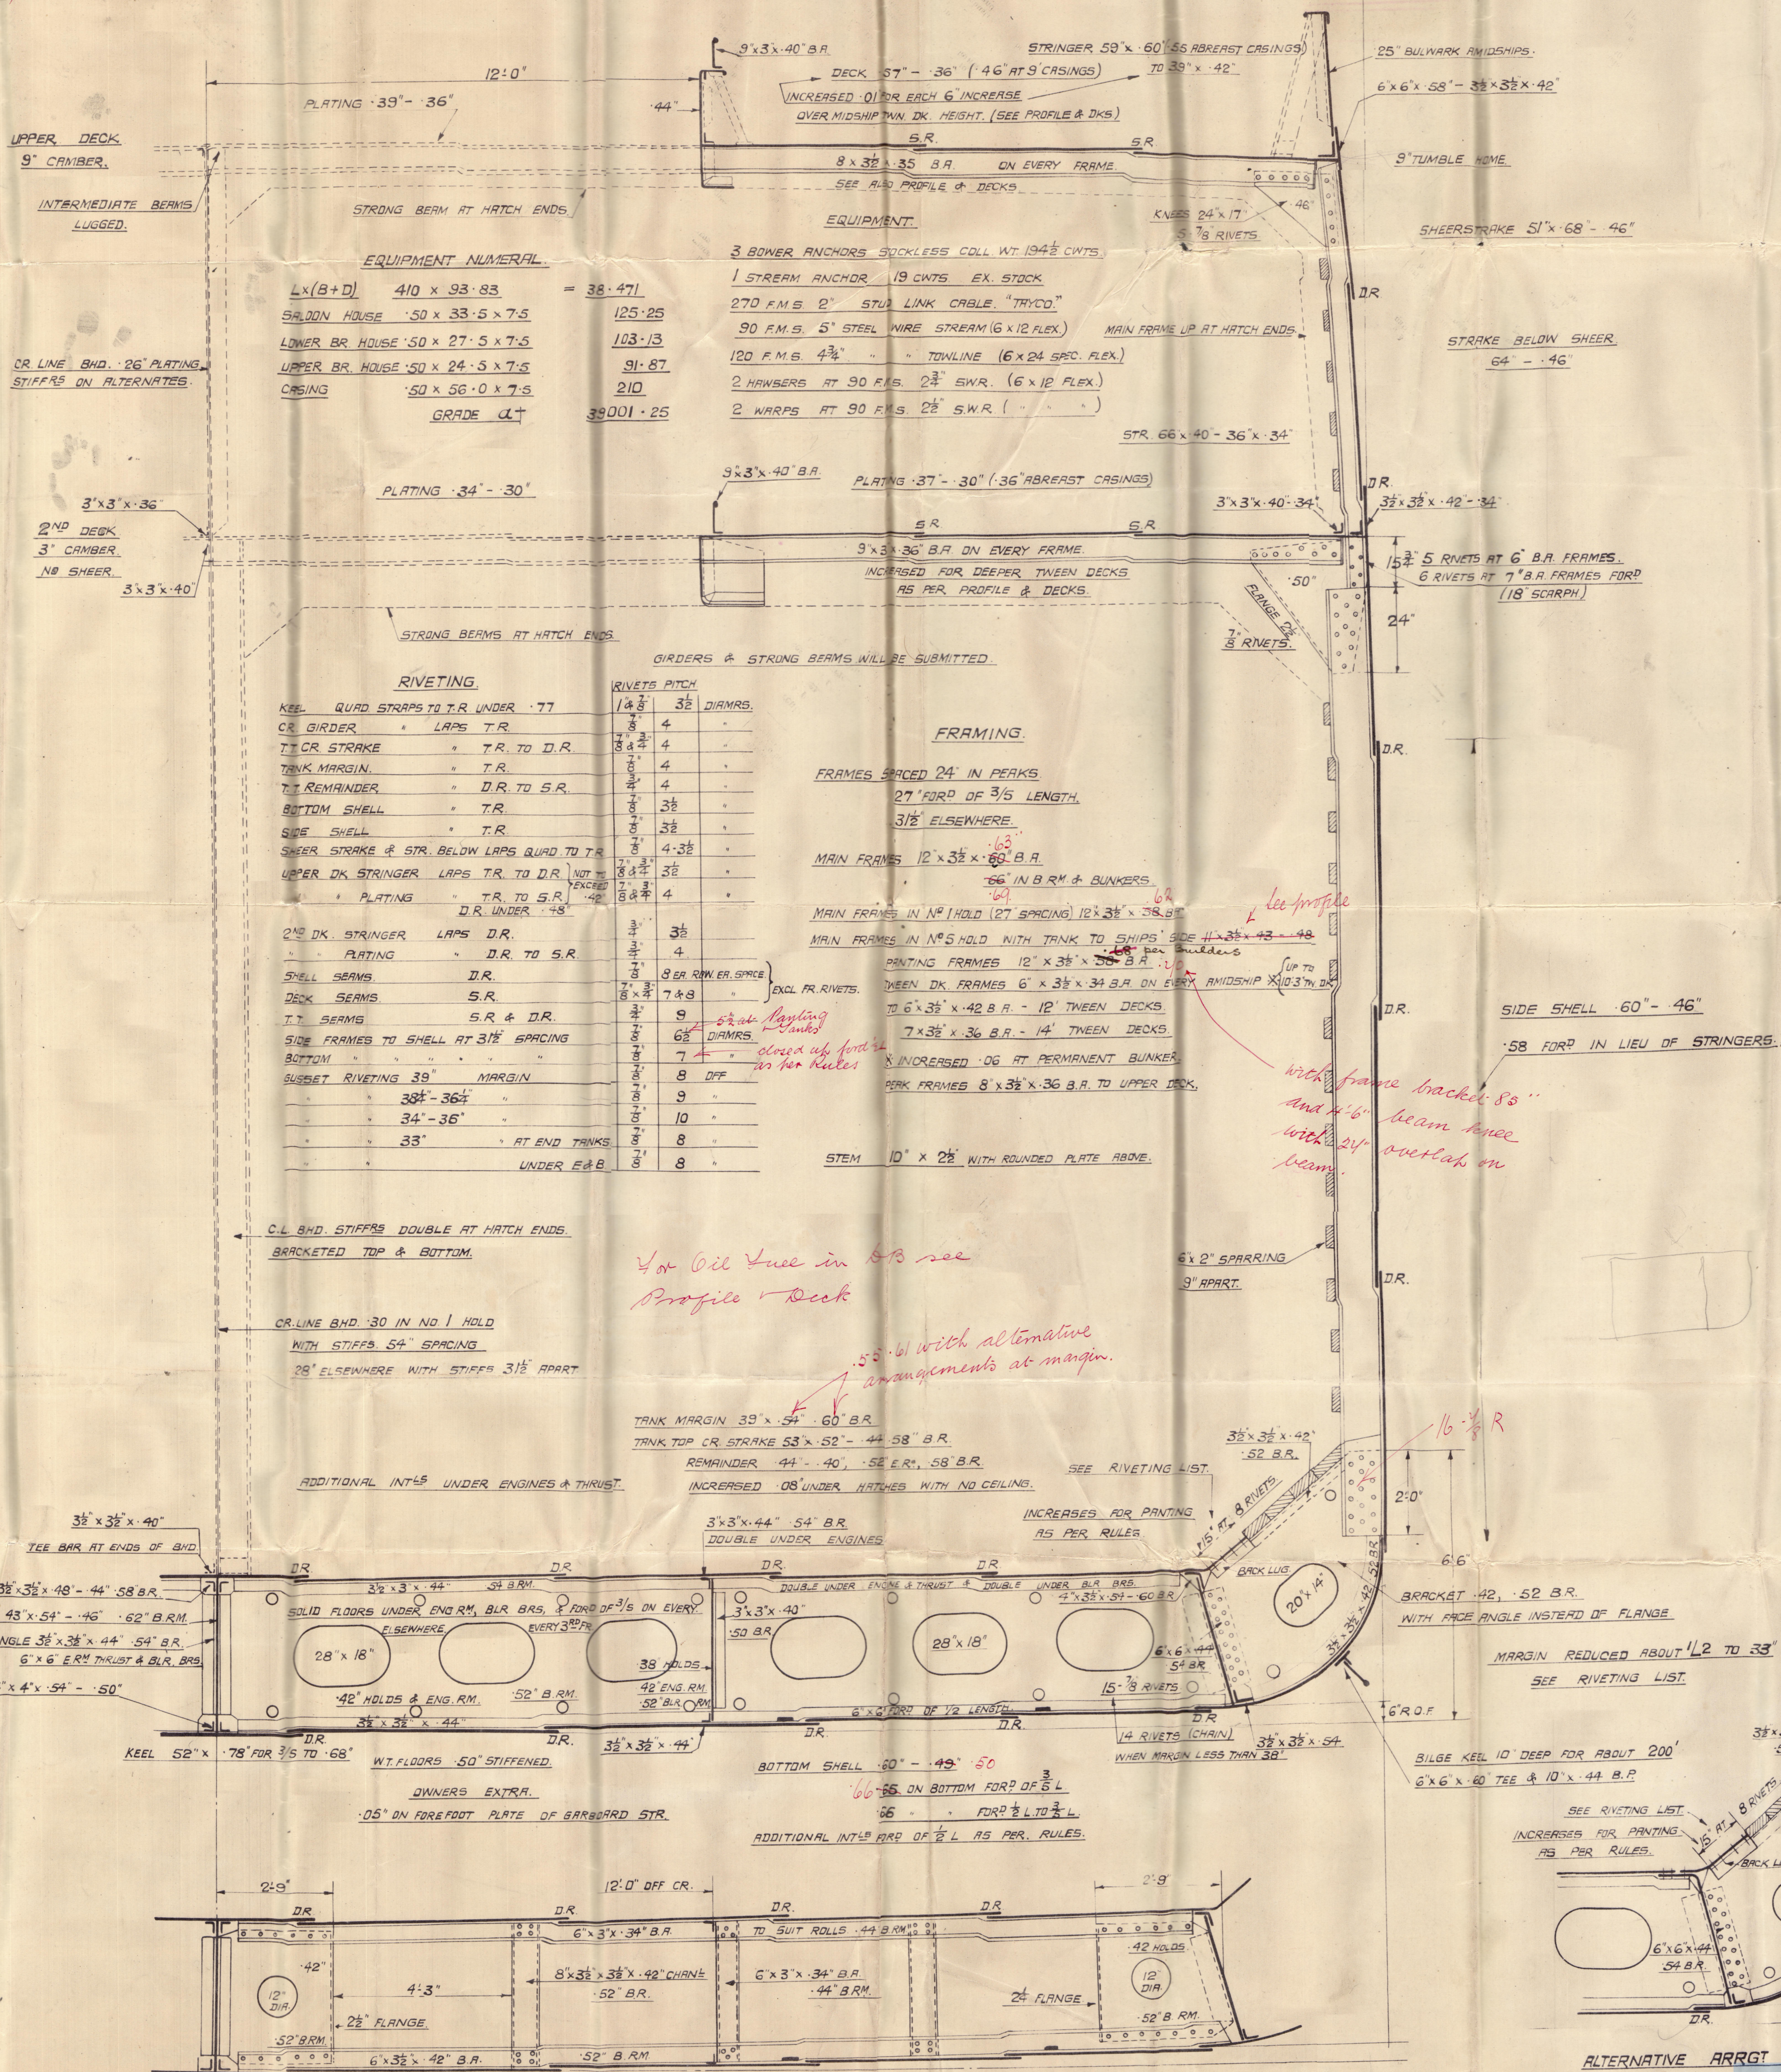

APPROVED

LLOYD'S REGISTER OF SHIPPING

Robinson

DATE 27/4/39

ALTERNATIVE ARRGT OF TANK MARGIN & GUSSET.

© 2020

Lloyd's Register Foundation

003605-003610-0066

4

MIDSHIP SECTION

CHELDON'S YARD NO'S 384-56

W/S 130.

M.V. "TOTTENHAM"



DUNDEE REPORT NO 9161

M.V. "TWICKENHAM"

DUNDEE REPORT NO 9194

M.V. "TEDDINGTON"

DUNDEE REPORT NO 9212

PLANS TRANSFERRED
TO SISTER VESSEL

JAG MATH

© 2020

Lloyd's Register
Foundation

003605-003610-0066