
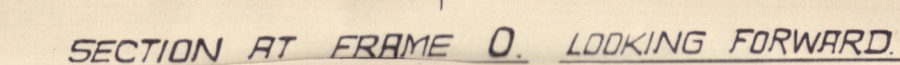
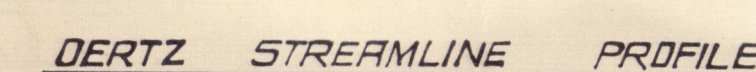
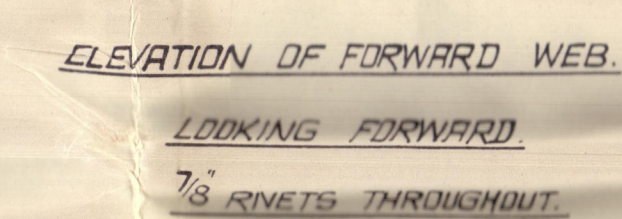


19/6/39
412

83

RUDDER COATED INTERNALLY WITH NON - DRYING GREASE PAINT.

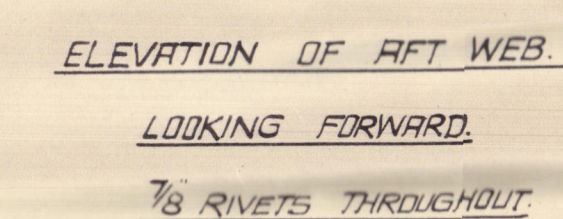

APPROVED
LLOYD'S REGISTER OF SHIPPING
© 2020
DATE 4-5-39
Lloyd's Register
Foundation
003605-003610-003611

1
OERTZ STREAMLINE RUDDER + CAST

STEEL STERN FRAME

CALEDON'S YARD NOS 384-5-6.

W/S 130.
M.V. "TOTTENHAM"



DUNDEE REPORT NO 9161.

M.V. "TWICKENHAM"

DUNDEE REPORT NO 9194

M.V. "TEDDINGTON"

DUNDEE REPORT NO 9212.

PLANS TRANSFERRED
TO SISTER VESSEL

JAG MATA



© 2020

Lloyd's Register
Foundation

003605-003610-0067