

11 JUL 1938


Revised plan of profile & deck to be submitted

Plan of deck to be submitted

Line of profile to be submitted

See 27 from 6.c



BOILER R<sup>2</sup>

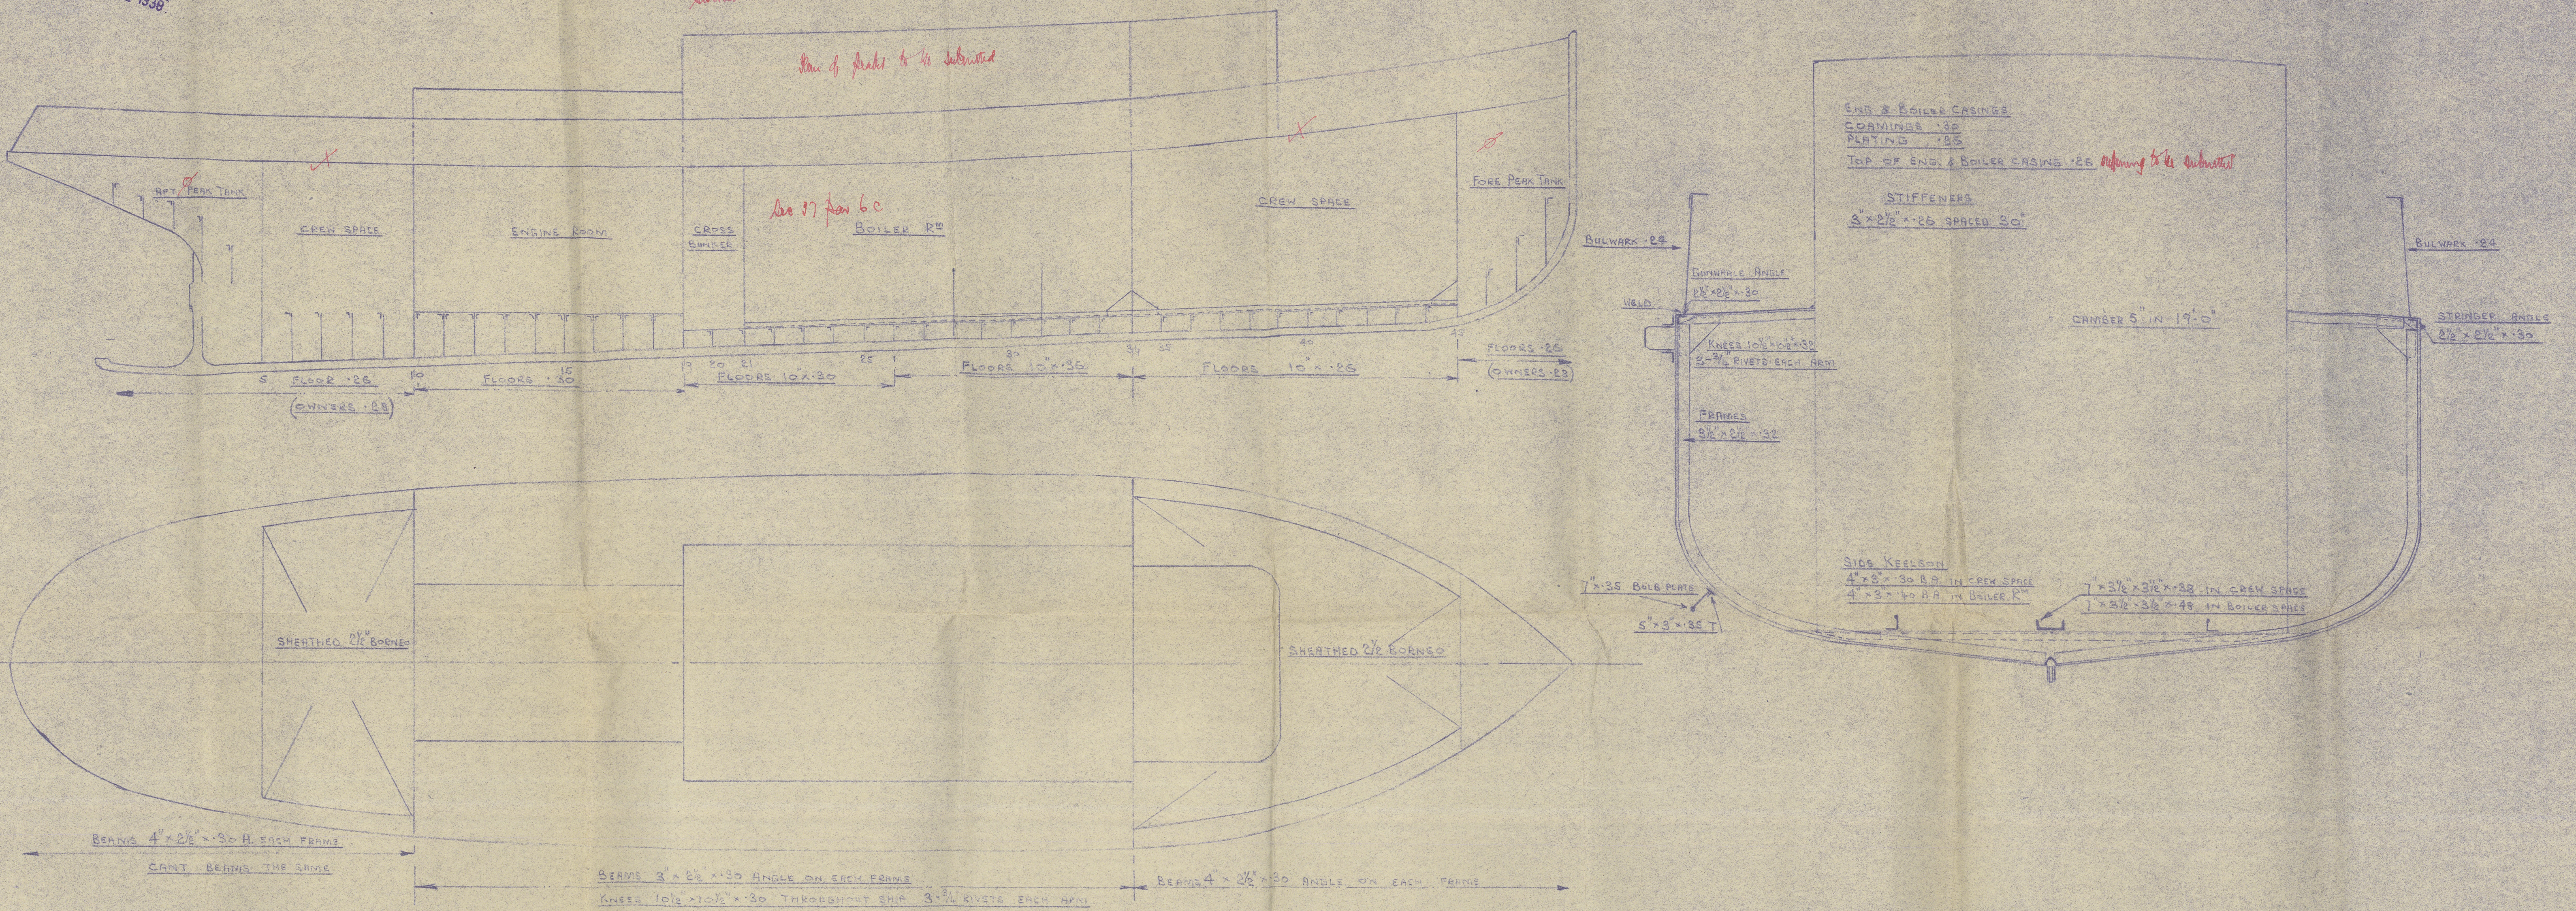

	OWNERS REQUIREMENTS
FRAMES	4" x 2 1/2" x 30 B.A. THROUGHOUT SPACED 12" APART
BEAMS	4" x 2 1/2" x 30 B.A. THROUGHOUT EVERY FRAME
SHELL	SHEERSTAKE 50 x 42". REST OF SHELL 35"
BULKWARK	30 WELDED TO KEEL
FLOORS	IN BOILER R <sup>2</sup> (25-33) 11" x 50 2 1/2" x 2 1/2" x 30 REV. BAR IN FWD CREW SPACE 11" x 28 2 1/2" x 2 1/2" x 25 REV. BAR IN ENG R <sup>2</sup> 40 2 1/2" x 2 1/2" x 30 REV. BAR DOUBLE
DECKS	35 ALL OVER

BAR KEEL	5" x 1 1/4" DOUBLE RIVETED
STEM	5" x 1 1/4"
STERNPOST	5" x 2 1/4" PLAN TO BE SUBMITTED

double under below beam

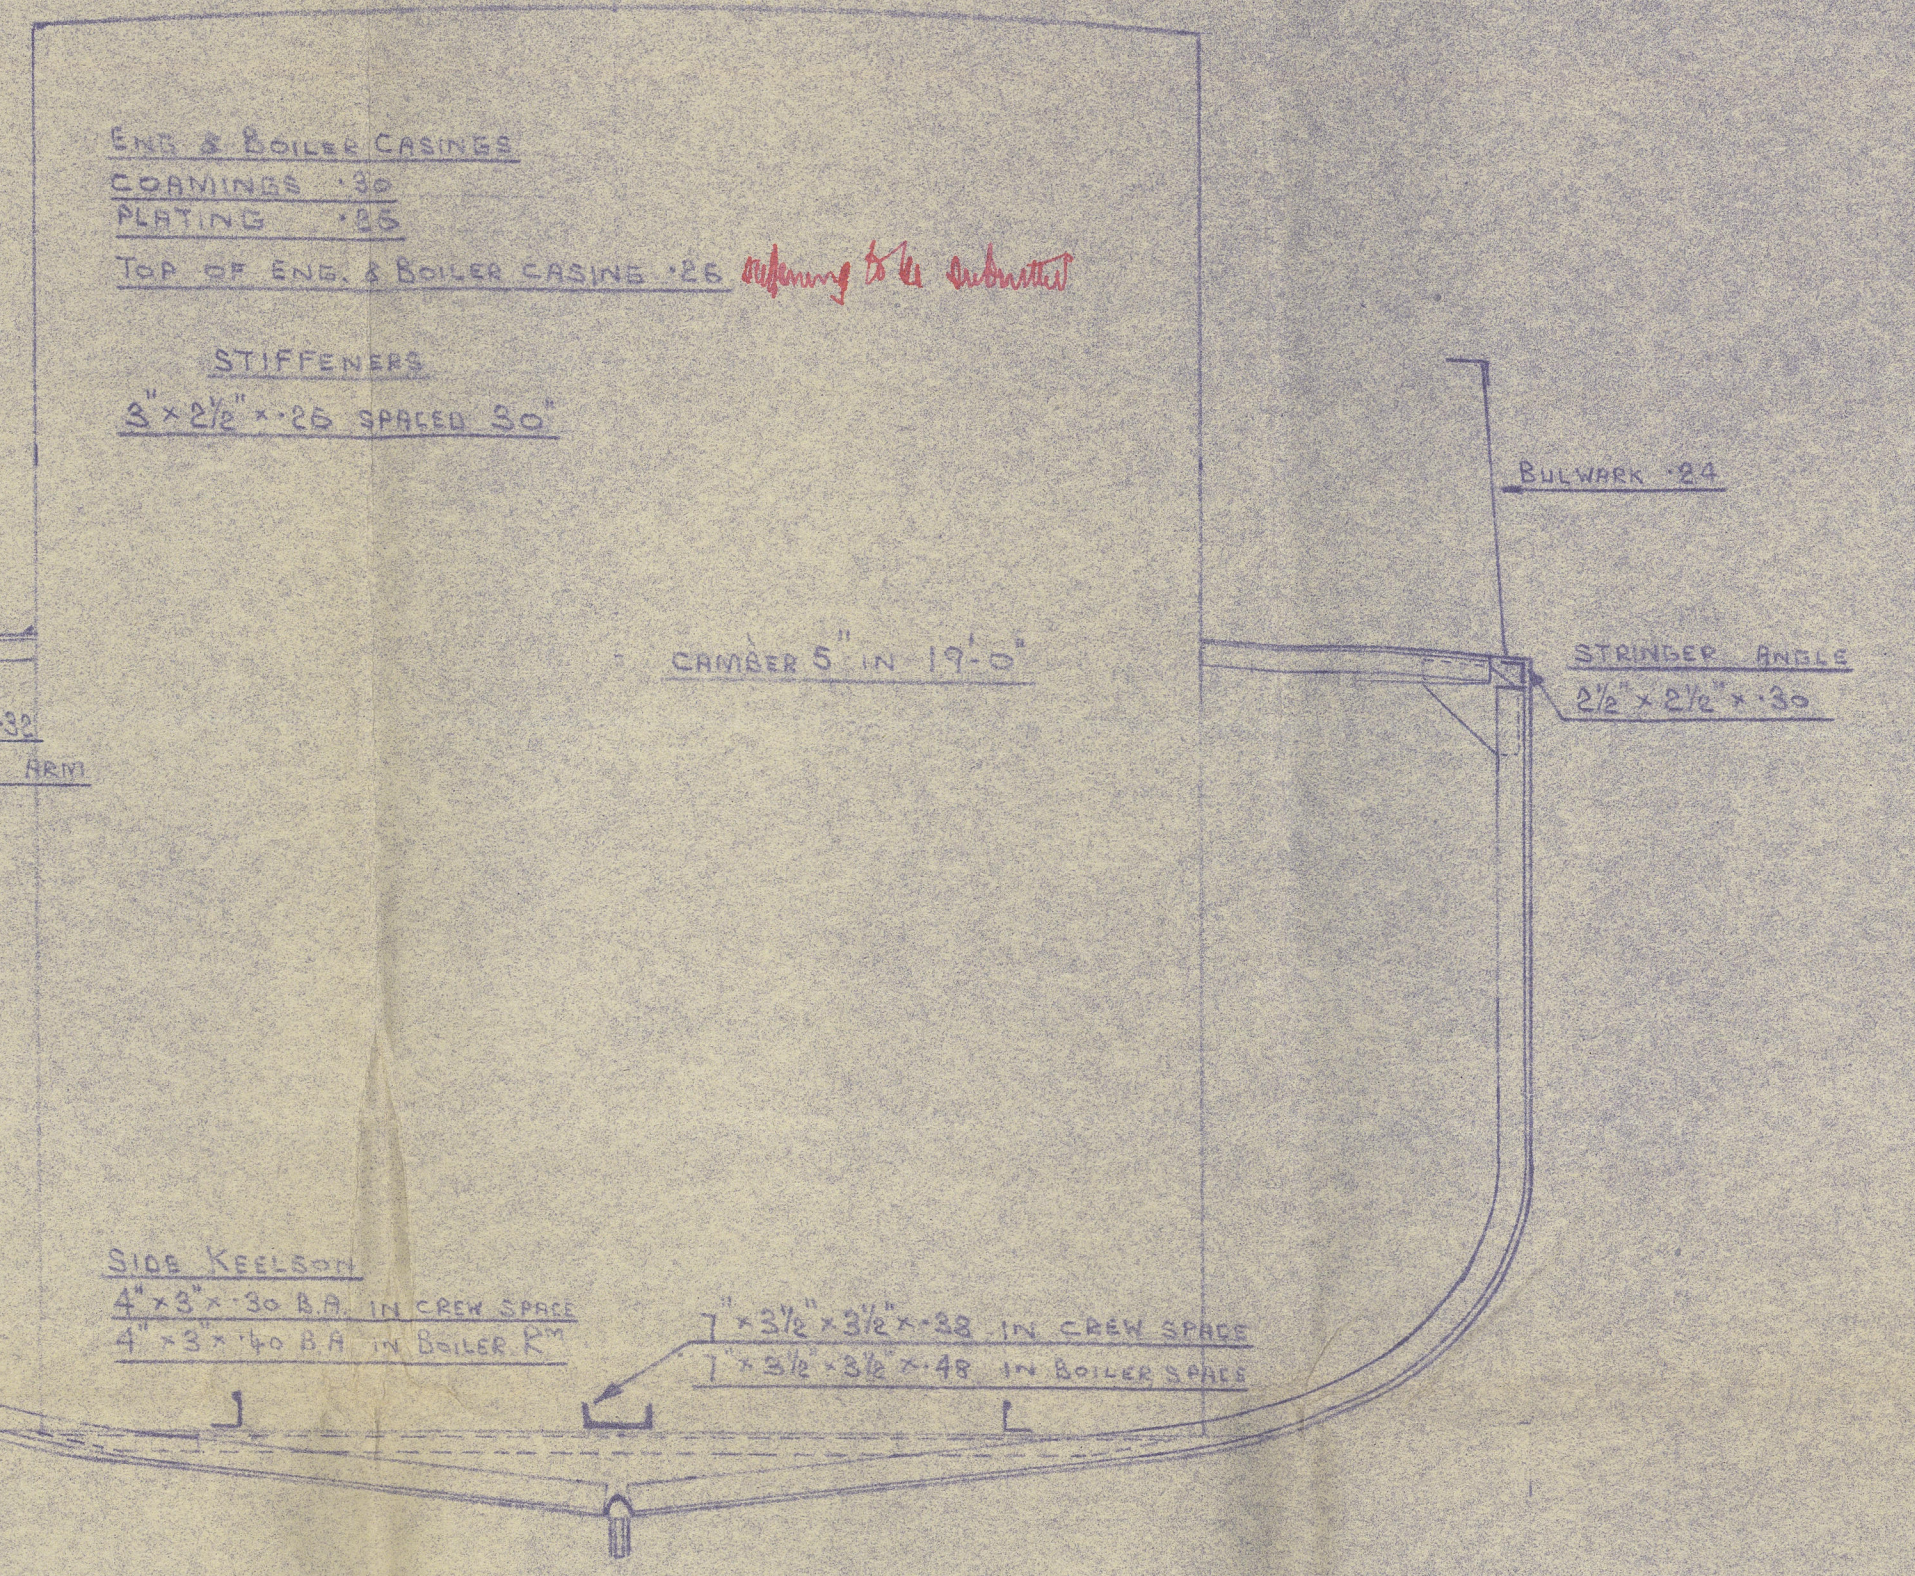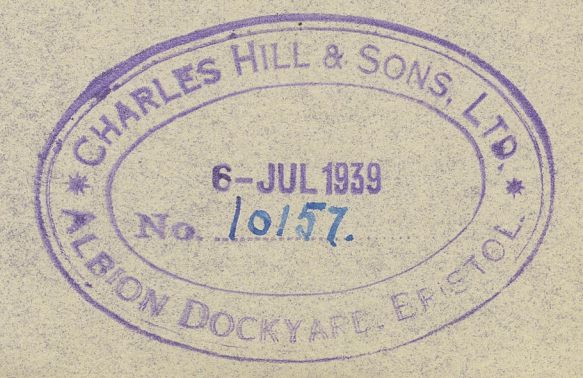

YARD No 277  
SINGLE SCREW STEAM TUG FOR POOLE HARBOUR  
TO CLASS LLOYDS 100 A.T. FOR TOWING SERVICE  
74'-0" B.P. x 19'-0" x 9'-0" MEB  
SCALES - PROFILE & DECK 1/4" = 1 FOOT  
MIDSHIP SECTION 1/8" = 1 FOOT

NUMERALS  
L x D = 666  
L (B x D) = 2072

EQUIPMENT  
2 STOCKLESS ANCHORS 3 1/4 CWT EACH  
60 FATHOMS 5/8" STD. LINK CABLE 17 1/4 CWT TOTAL  
60 FATHOMS 5" HAWSER  
60 FATHOMS 2 1/2" WARPS

11. 7. 39



Chas. Hill & Sons Ltd.

No. 277

Preliminary Steel Arrangement



© 2020

Lloyd's Register  
Foundation

003611-003619-0148