


Lloyd's Register of Shipping.

SURVEYS FOR FREEBOARD.

(CONDITIONS OF ASSIGNMENT.)

Ship's Name *"PETER JOLIFFE."* Port of Survey *Bristol*
 Official Number *167661* Surveyor's Signature *J. Brooke Smith*
 Nationality and Port of Registry *British POOLE.* Date of Survey *16-1-40 & 1-4-40.*

Disposition and dimensions of superstructures, trunks, deckhouses and machinery casings to be inserted in the diagrams and tabular statement:—

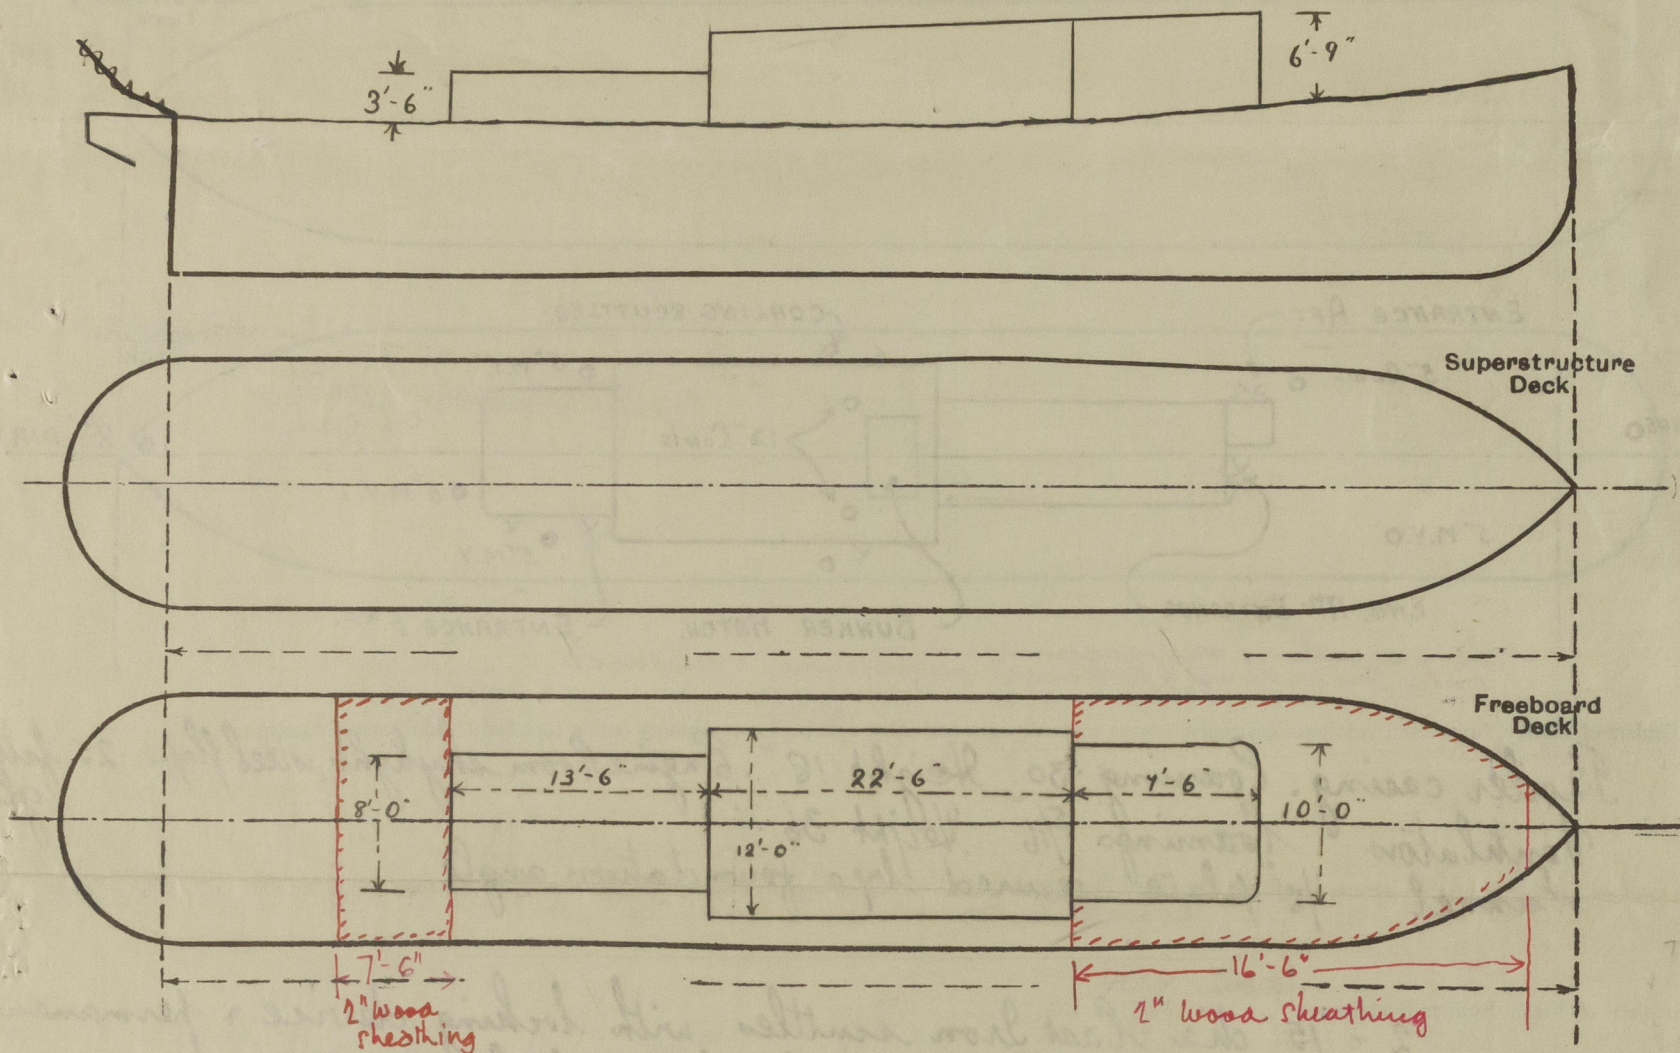

Particulars of Superstructures, Trunks, Casings, Deckhouses.


	Coaming	Plating	Stiffeners	Spacing	End Attachments of Stiffeners	Size of Openings	Height of Sills	Height of Casings
Poop Bulkhead ...	✓							
Raised Quarter Deck Bulkhead ...	✓							
Bridge, After Bulkhead ...	✓							
Bridge, Forward Bulkhead ...	✓							
Forecastle Bulkhead ...	✓							
Trunk, Aft ...	✓							
Trunk, Forward ...	✓							
Exposed Machinery Casings on Freeboard or Raised Quarter Decks ...	26 ✓	26 ✓	3"x3"x26 ✓	24 ✓	Bracket to Beam & Deck	✓ X	12 ✓	42 ✓
Exposed Machinery Casings on Superstructure Decks ...								
Machinery Casings within Superstructures not fitted with Class I Closing Appliances ...								
Deckhouses on Flush Deck Ships ...	30 ✓	26	3"x3"x26	30" & 24" no plan	do:	5'-0" x 2'-0"	12" 18" 6'-9" ✓	18" no plan

Particulars of Closing Appliances (state if capable of being manipulated from both sides).

Poop Bulkhead ...	✓
Raised Quarter Deck Bulkhead ...	✓
Bridge, After Bulkhead ...	✓
Bridge, Forward Bulkhead ...	✓
Forecastle Bulkhead ...	✓
Exposed Machinery Casings on Freeboard or Raised Quarter Decks ...	Steel door to Engine Room. Operates from both sides
Exposed Machinery Casings on Superstructure Decks ...	
Machinery Casings within Superstructures not fitted with Class I Closing Appliances ...	
Deckhouses on Flush Deck Ships ...	Leak doors. Operated

PARTICULARS OF PROTECTION TO OPENINGS, ETC.

The following diagrams should be used to indicate the positions of ~~coamings~~ and coaling hatchways, ~~gangways~~ and coaling ports, ventilators, companionways, etc., which would affect the seaworthiness of the ship:—

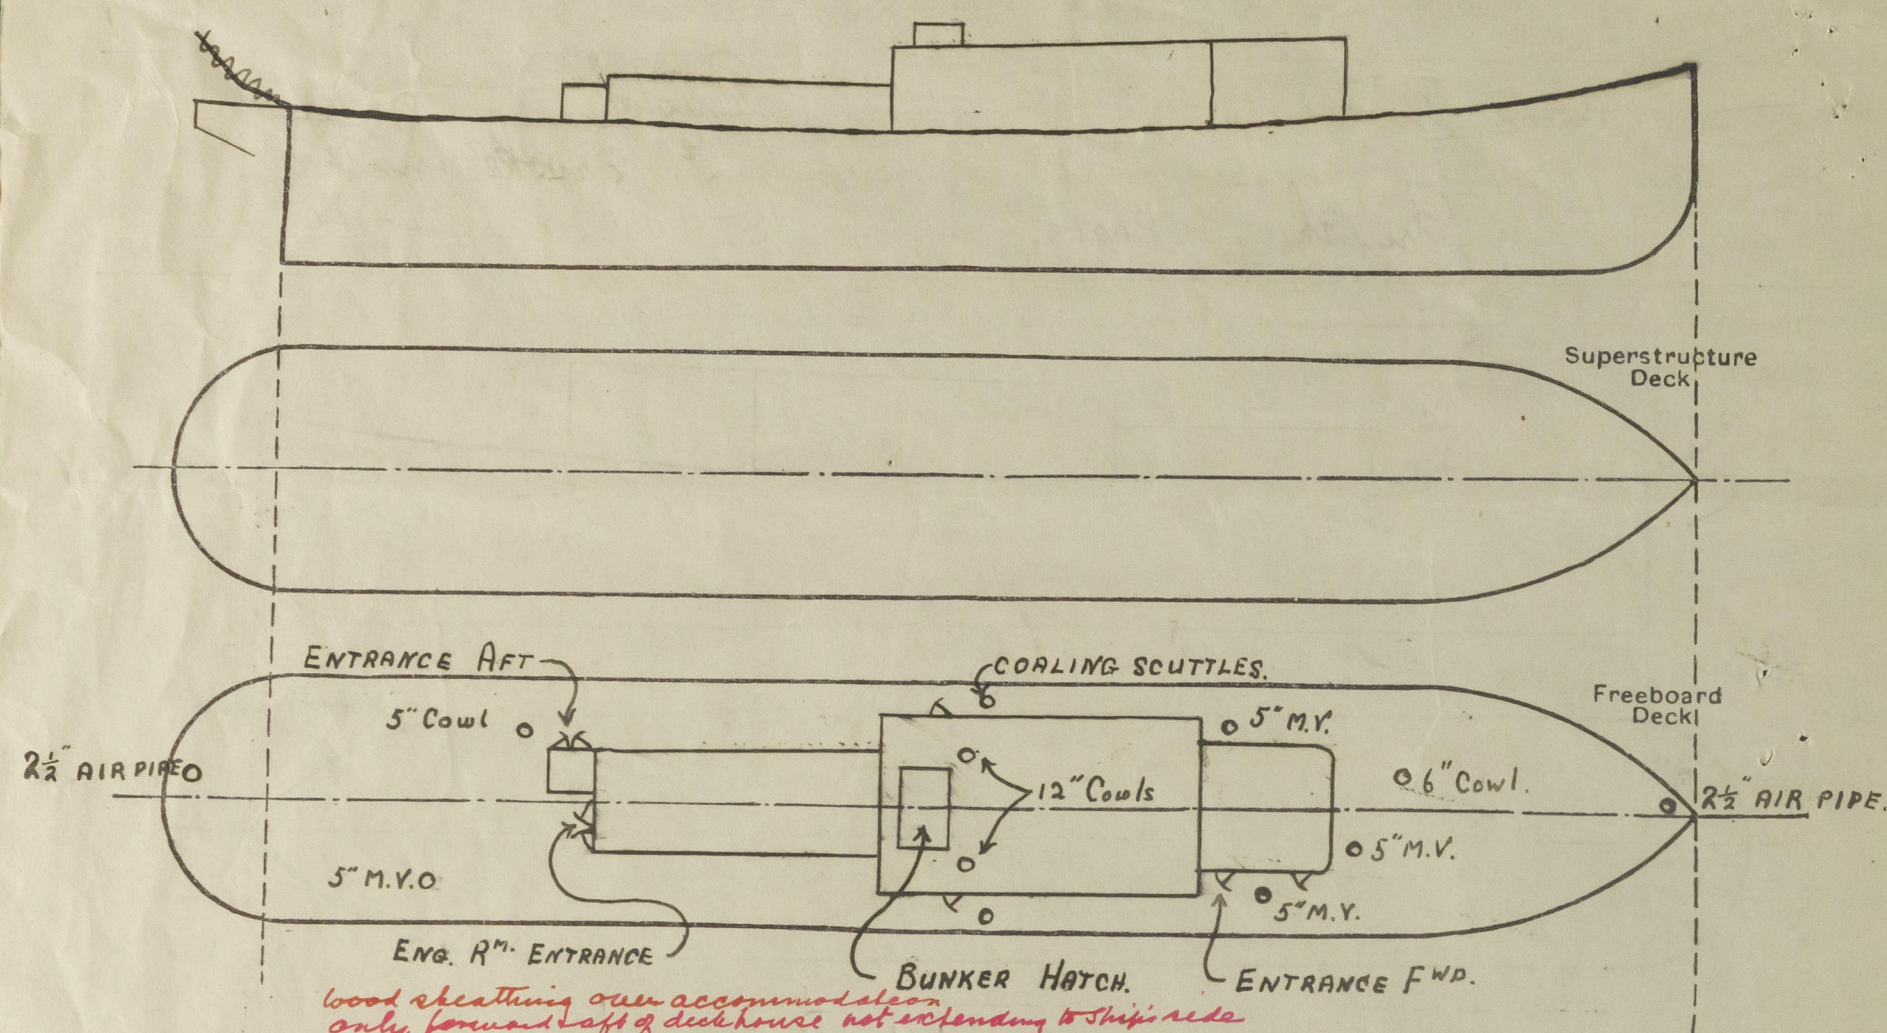

Particulars of fidley, funnel and ventilator coamings, engine room skylight and other openings in machinery casing tops and their means of closing:—

~~Boiler casing~~ ^{Boiler casing}. Coaming 30" Height 18". Engine room skylight, steel flaps 25 fitted with glass.
Ventilators Coamings 5 1/16" Height 36".
Funnel 1/8" plate secured by a foundation angle.

Particulars of Flush Bunker Scuttles:—

2 - 15" dia Cast Iron scuttles with locking device & permanent chain attachment. Fitted on main deck abreast boiler casing. ✓

Particulars of Companionways:—

One forward to crew space. Steel, coaming 30" Height 12". Teak door.
Two aft to Engine room & cabin. Steel, coaming 26" Height 12". Steel doors.

Particulars of Ventilators in exposed positions on freeboard and superstructure decks:—

One 6" cowl ventilator with 36" x 5 1/16" coamings.
One 5" cowl ventilator with 36" x 5 1/16" coamings.
Four 5" mushroom ventilators with 36" x 5 1/16" coamings. (screw tops).
Wood plugs & canvas covers supplied for cowl ventilators.

Particulars of Air Pipes in exposed positions on freeboard, raised quarter, or superstructure decks:—

1 - 2 1/2" to Fore peak. 30" above deck. 5 1/16" thick ✓
1 - 2 1/2" to After peak. 24" above deck. 5 1/16" thick. ✓
3 1/4"

Particulars of Gangway Cargo and Coaling Ports:—

None.

Particulars of Scuppers and Sanitary Discharge Pipes:—

1 - 4" Sanitary discharge. Gunmetal valve. Where
No scuppers. Galley & Water Closet drain to deck. ✓

Particulars of Side Scuttles:—

None below deck.

Vertical distance of Sill of lowest Side Scuttle above top of keel 10' 8" (in deck house).

Particulars of Guard Rails:—

Bulwarks all round 3'-0" - 2'-6". ✓
Rails on bridge deck. ✓ Stanchions spaced 36". Two tier

Particulars of Gangways, Lifelines, etc.:—

None.

Particulars of Freeing Arrangements.

	Length of Bulwark	Height of Bulwark	Size of Freeing Ports	Number each side	Area each side	Rule area each side
MAIN DECK.	78'-0"	3'-0" - 2'-6"	48" x 9"	5	15.99 ft.	10.9 sq. ft. for 7L.
Forward Well						

State position of each freeing port ... { After Well: MAIN DECK. about 16'-0" apart. ✓
(F. and A. position and height above deck edge) { Forward Well:—

State whether the freeing ports are fitted with shutters, bars, or rails, and give particulars of such:—

Open type. ✓

Additional area where sheer is less than standard.

PARTICULARS OF PROTECTION TO OPENINGS, ETC.

HATCHWAYS ON FREEBOARD AND SUPERSTRUCTURE DECKS.

Description of Hatchway
Dimensions of Hatchway
COAMINGS	Height above Deck
	Thickness
	Stiffeners
	Brackets, Stays
HATCH BEAMS	Number
	Spacing
	Scantling and Sketch
FORE AND AFTERS	Number
	Spacing
	Unsupported Lengths
	Scantling* and Sketch
HATCH COVERS	Material
	Thickness
	How fitted
	Bearing Surface
Spacing of Cleats
Number of Tarpaulins
<p>*Are wood fore and afters steel shod at all bearing surfaces? <i>yes.</i></p> <p>Are battens and wedges efficient and in good condition? <i>yes.</i></p> <p>Are tarpaulins in good condition and in accordance with rule requirements? <i>yes.</i></p> <p>Are lashings provided in accordance with rule requirements? <i>yes.</i></p>										

Particulars of any special features:—

Endorsement at first survey and at surveys for renewal of Certificate:—

The fittings and appliances are in accordance with the particulars shown on this form (or as now modified) and are in good condition.



© 2020

Lloyd's Register
Foundation