

34425


Lloyd's Register of Shipping.

15 OCT 1946

Ship's Name M.V. "ACAVUS"

Official No. 163564

Memorandum of alterations reported since ship was surveyed for assignment of Load Lines
in

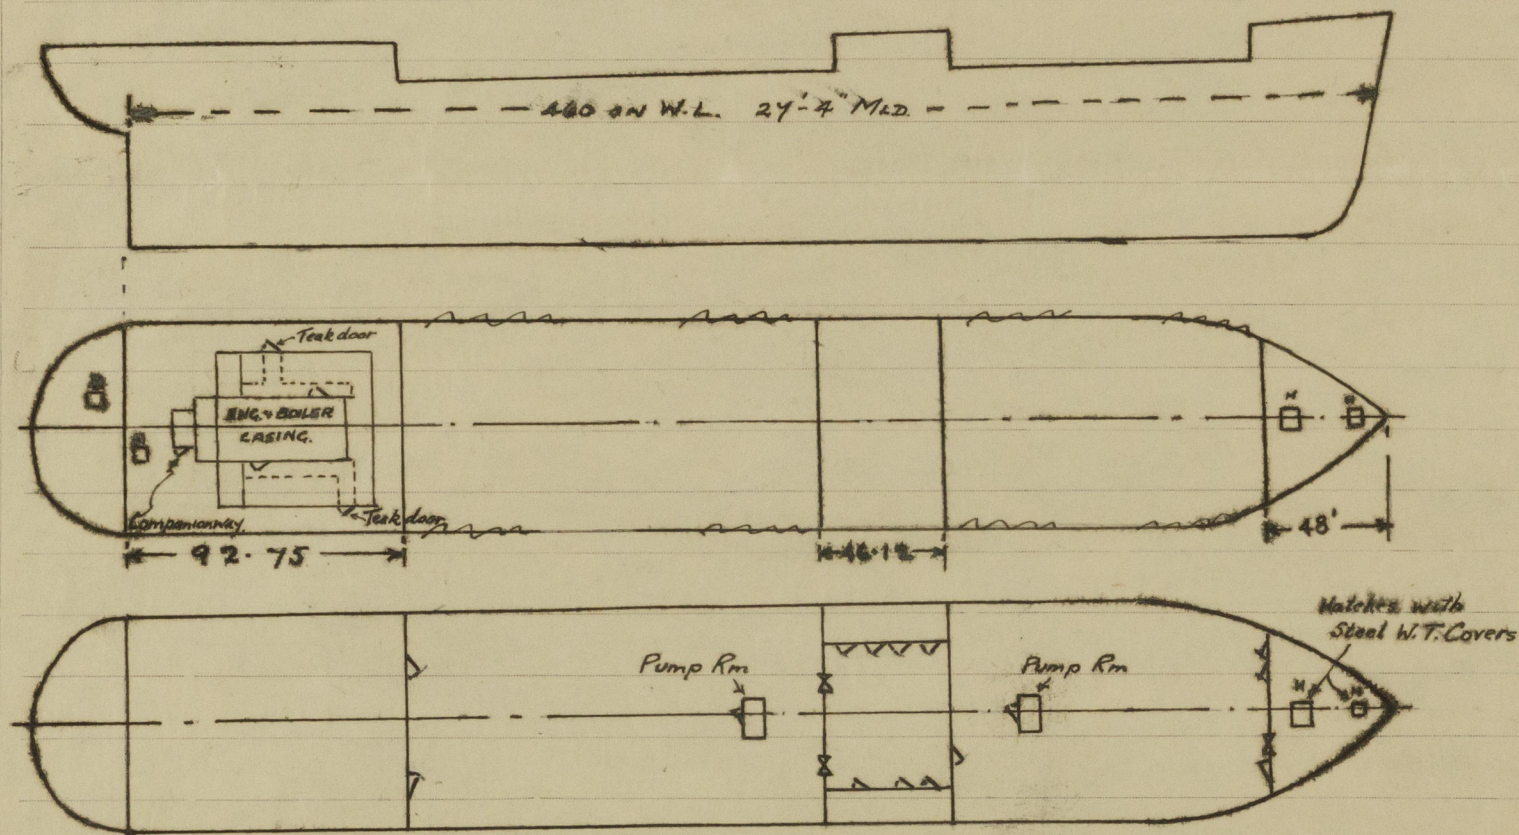

The Flight deck has been removed & the vessel restored to its original condition except that the crew accommodation has been removed from the Forecastle to the Poop with the following modifications to the original Load Line Report.

Companionways The forward companionway on the Poop has been removed.

Ventilators On Forecastle to spaces below Freeboard deck - an additional 12" cowl vent fitted to pump room, coaming 36" x Rule thickness, efficient closing appliances provided.

On Poop to spaces above Freeboard Deck - Additional cast iron S.N.V.'s 7" x 6" x 30" fitted.

Gas Pipes to D.B. tanks & P. & S. carried up to boat deck in way of Engine room skylight & efficiently secured, efficient closing appliances provided.

Sanitary Discharge Pipes from Forecastle space have been dispensed with.

Size of Openings in Forecastle bulkhead. One 60" x 24" (hinged solid Teak door 1 5/8" to deck store) Sill 18"

Two 60" x 24" hinged steel W.T. doors (companionways) Sill 18"

One 60" x 42" portable steel stiffened plate secured by hook bolts. Sill 18"

Particulars of closing Appliances (State if capable of being manipulated from both sides) Yes

Poop Bulkhead - Two hinged steel W.T. doors.

Bridge, After Bulkhead - One hinged steel W.T. door. Two portable steel stiffened plates secured by hook bolts.

Bridge, Forward Bulkhead - One (Starboard side only) hinged steel W.T. door.

Forecastle Bulkhead - Two hinged steel W.T. doors (companionways). One hinged solid teak door 1 5/8". One portable steel stiffened plate secured by hook bolts.

Gas. Stevenson

12-10-46.