

MIDSHIP SECTION.


TO CLASS 100 A WITH FREEBOARD.

## LLOYDS NUMERALS

ALL DECKS, INNER BOTTOM & A, B, C D & E STRAKES.  
OF OTHER BOTTOM ARRANGED FOR MULTIPLE PUNCHING  
HYDRAULIC RIVETING IN FLAT PLATE KEEL & VERTICAL OR KEELSON.  
SHEER STRAKES HAND RIVETED.

EQUIPMENT N° 82995.

2 BOWER ANCHORS STOCKLESS 137 CWTs EACH  
1 BOWER ANCHOR " 116 CWTs.  
1 STREAM " 54 "  
CABLE 330 FMS. 3/4" STUD LINK CHAIN  
STREAM ANCHOR WIRE 150 FMS. 7" F.S.W.R.  
TOW LINE 140 FMS. 7 1/2" F.S.W.R.  
HAWKERS & WARPS 6 AT 120 FMS. 4" F.S.W.R.

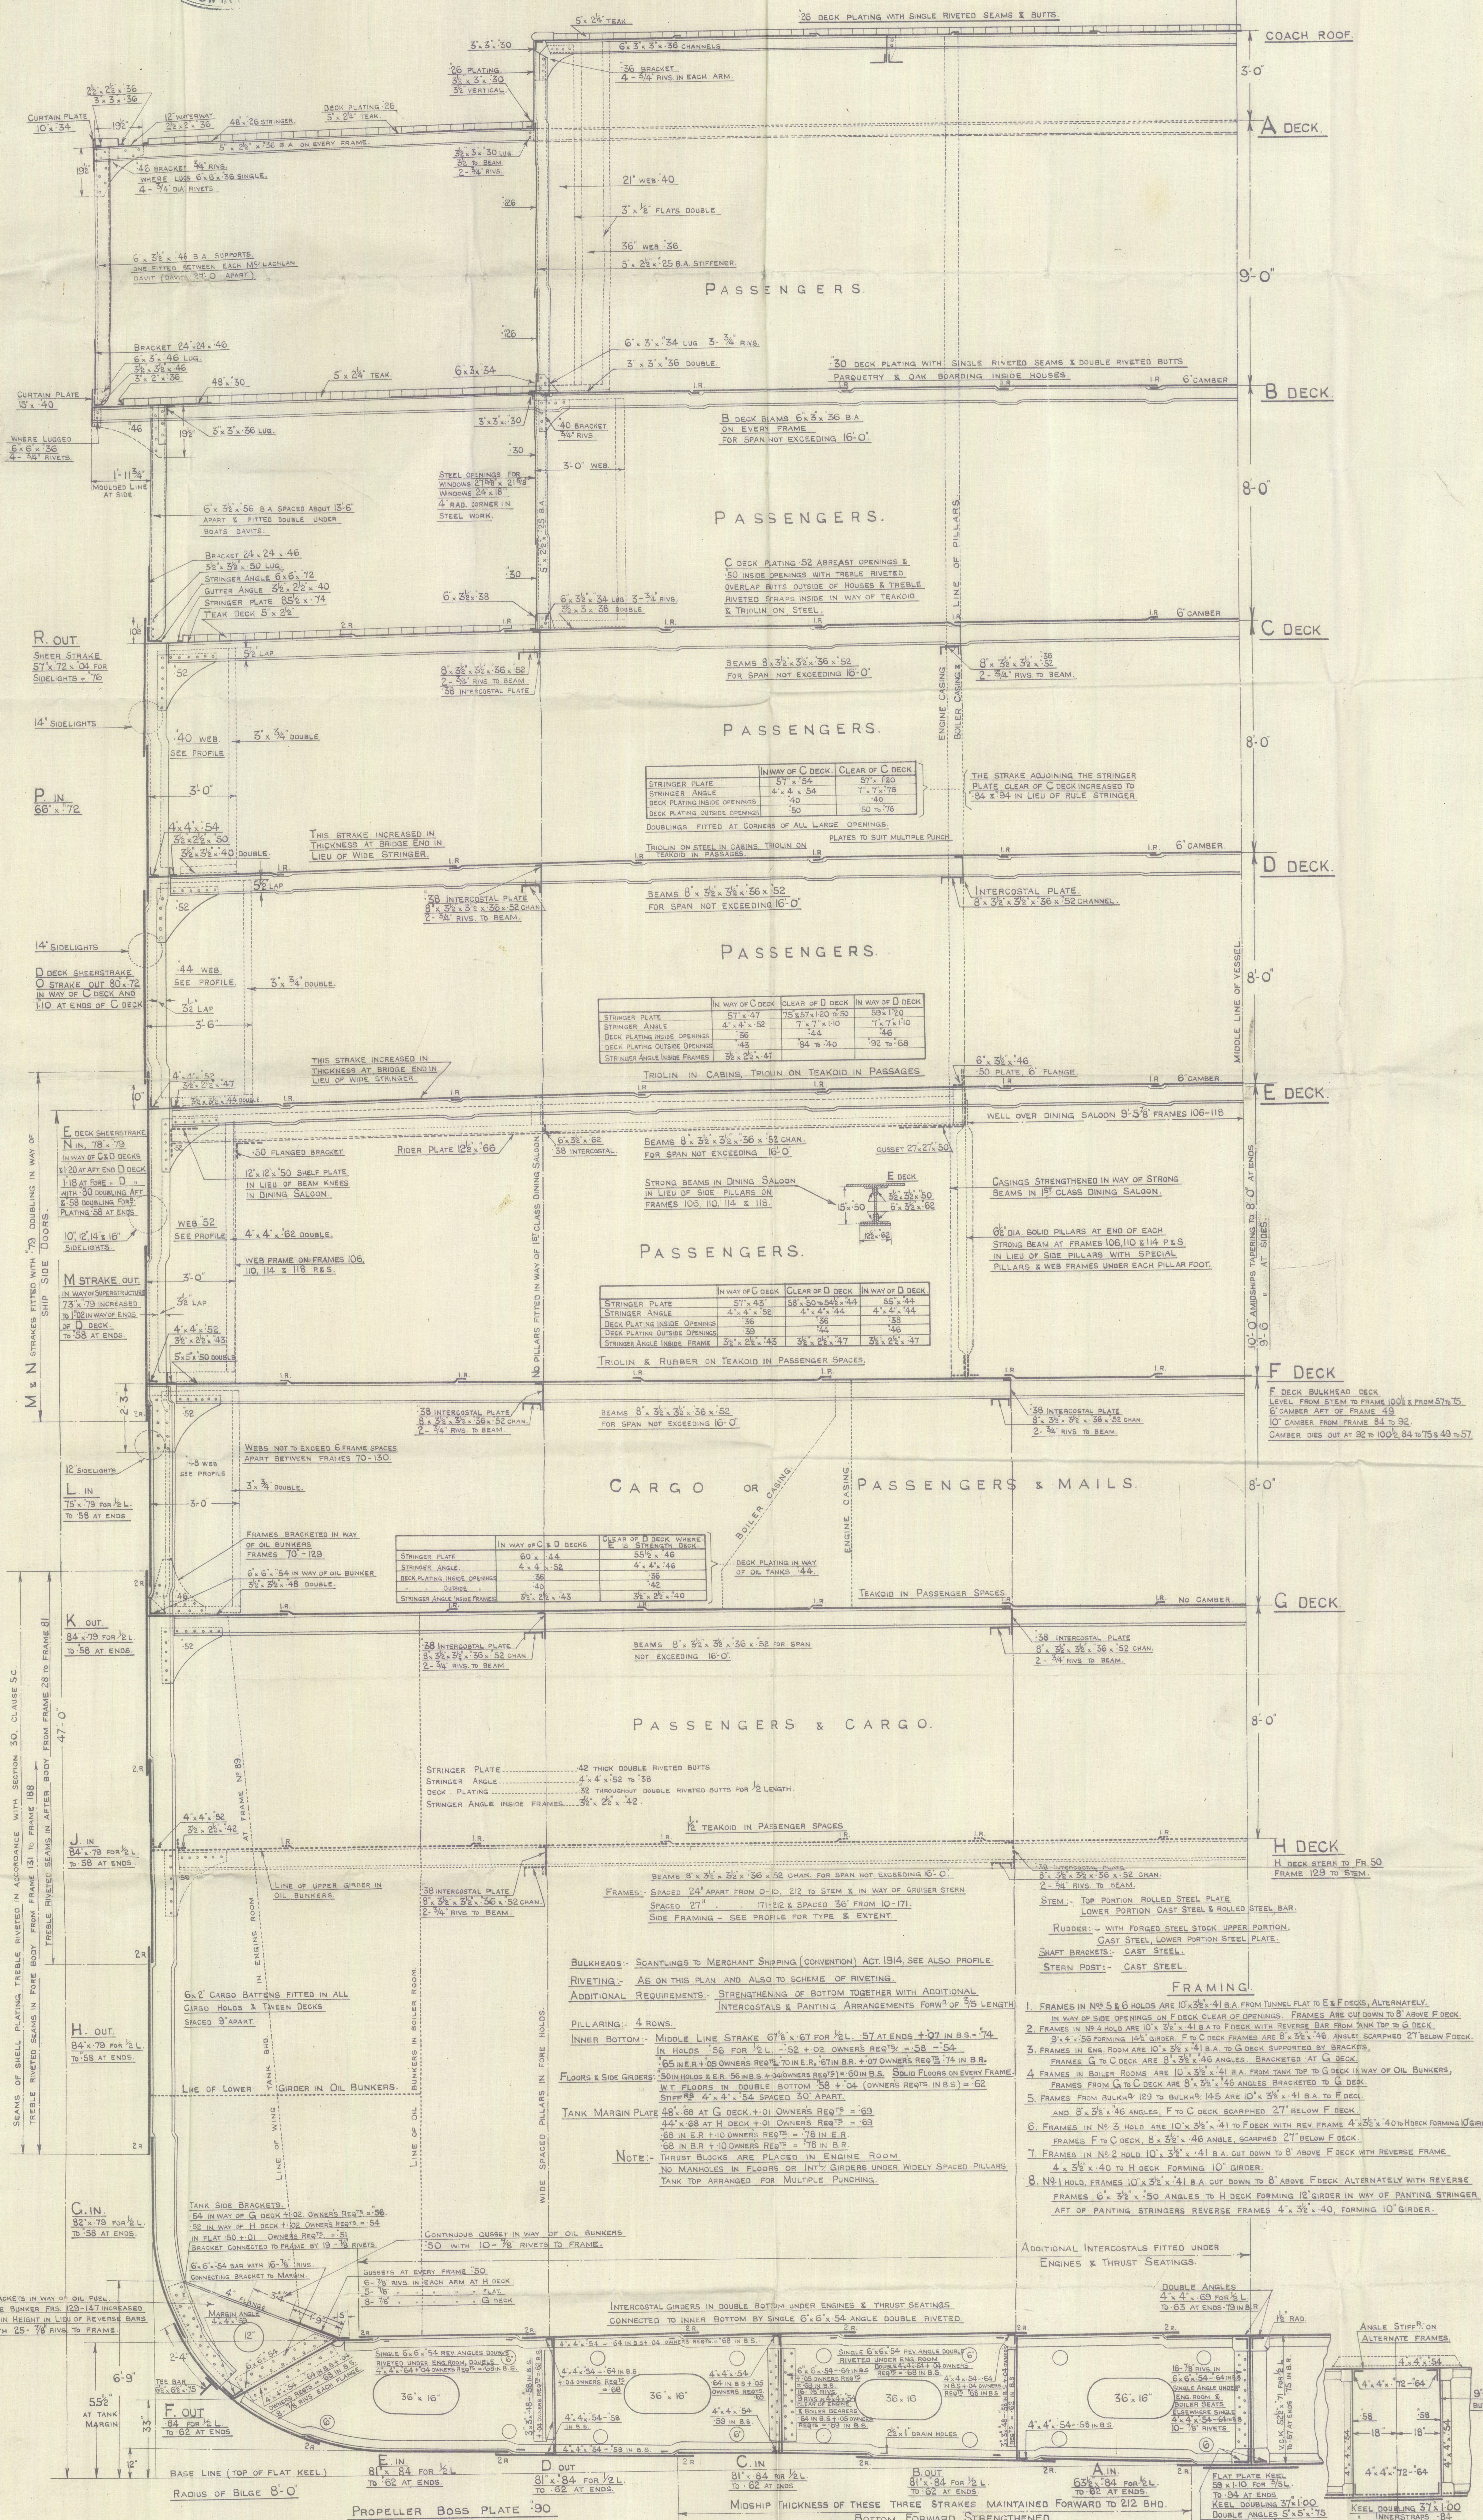



Lucken Armistings Ltd Y. S. S. No 634  
"Orontes"

Midships Section (as built)

003620-003624-0059



© 2021

Lloyd's Register  
Foundation