

© 2021
Lloyd's Register
Foundation

003620-003624-0205 1/2



© 2021


Lloyd's Register
Foundation

Particulars

Superstructure bulkheads, trunks, deckhouses, casings, cargo and coaling hatchways, extent and thickness of sheathing on the freeboard deck, gangway, cargo and coaling ports, and any other openings, etc., which would affect the seaworthiness of the ship are to be shown on the following sketches:—

Coal shoot opening 14' x 14'
coaming 8" L battens
covers, cleats & tarpaulins in order.

Coal bunker opening 18' x 5' 9"
coaming 8" L battens covers
cleats & tarpaulins in order.

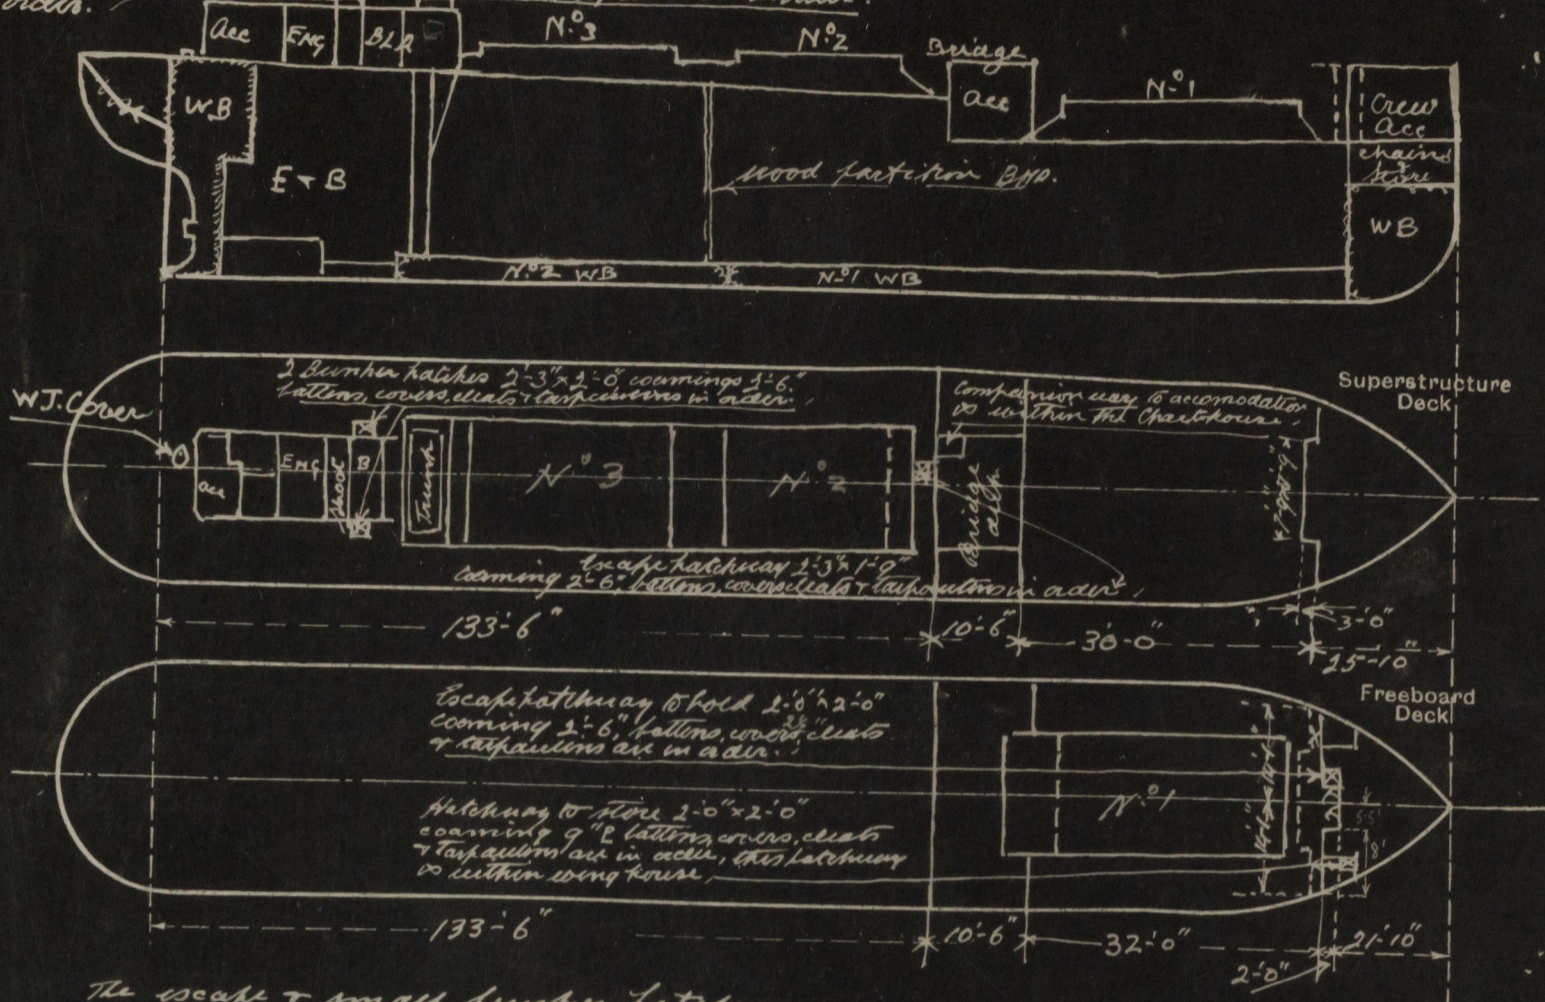

The escape & small bunker hatches on weather decks are fitted with 2 1/2" WP covers having 1 1/2" bedding surface, two cleats on each side, and 2 Tarpaulins each supplied.



© 2021

Lloyd's Register
Foundation

003620-003624-0205 3/2