

Lloyd's Register of Shipping.

Ship's Name "TRADER". Official No. 166310.


Memorandum of alterations reported since ship was surveyed for assignment of Load Lines in

W.C. now erected in Starboard after corner of forecastle space - see sketch.

Steel door, operable from both sides, opening 5' 2" x 2' 0" with 18" coaming, fitted in forecastle front.

10" side scuttle with hinged permanent deadlight fitted in forecastle front.

W.C. discharge led overboard above line of freeboard deck and fitted with storm valve.

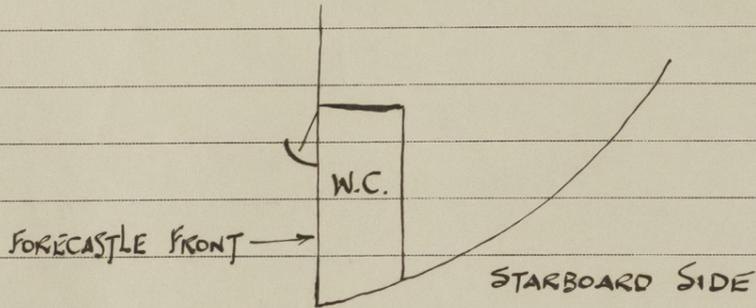

hoped. *[Signature]*
8 - OCT 1947

J. S. Watkins

SURVEYOR TO LLOYD'S REGISTER.

Liverpool. 10th Sept. 1947.