


DRAWING N°1/W.G.D. M.V. "ONDINA" at Fremantle. Dec 1942

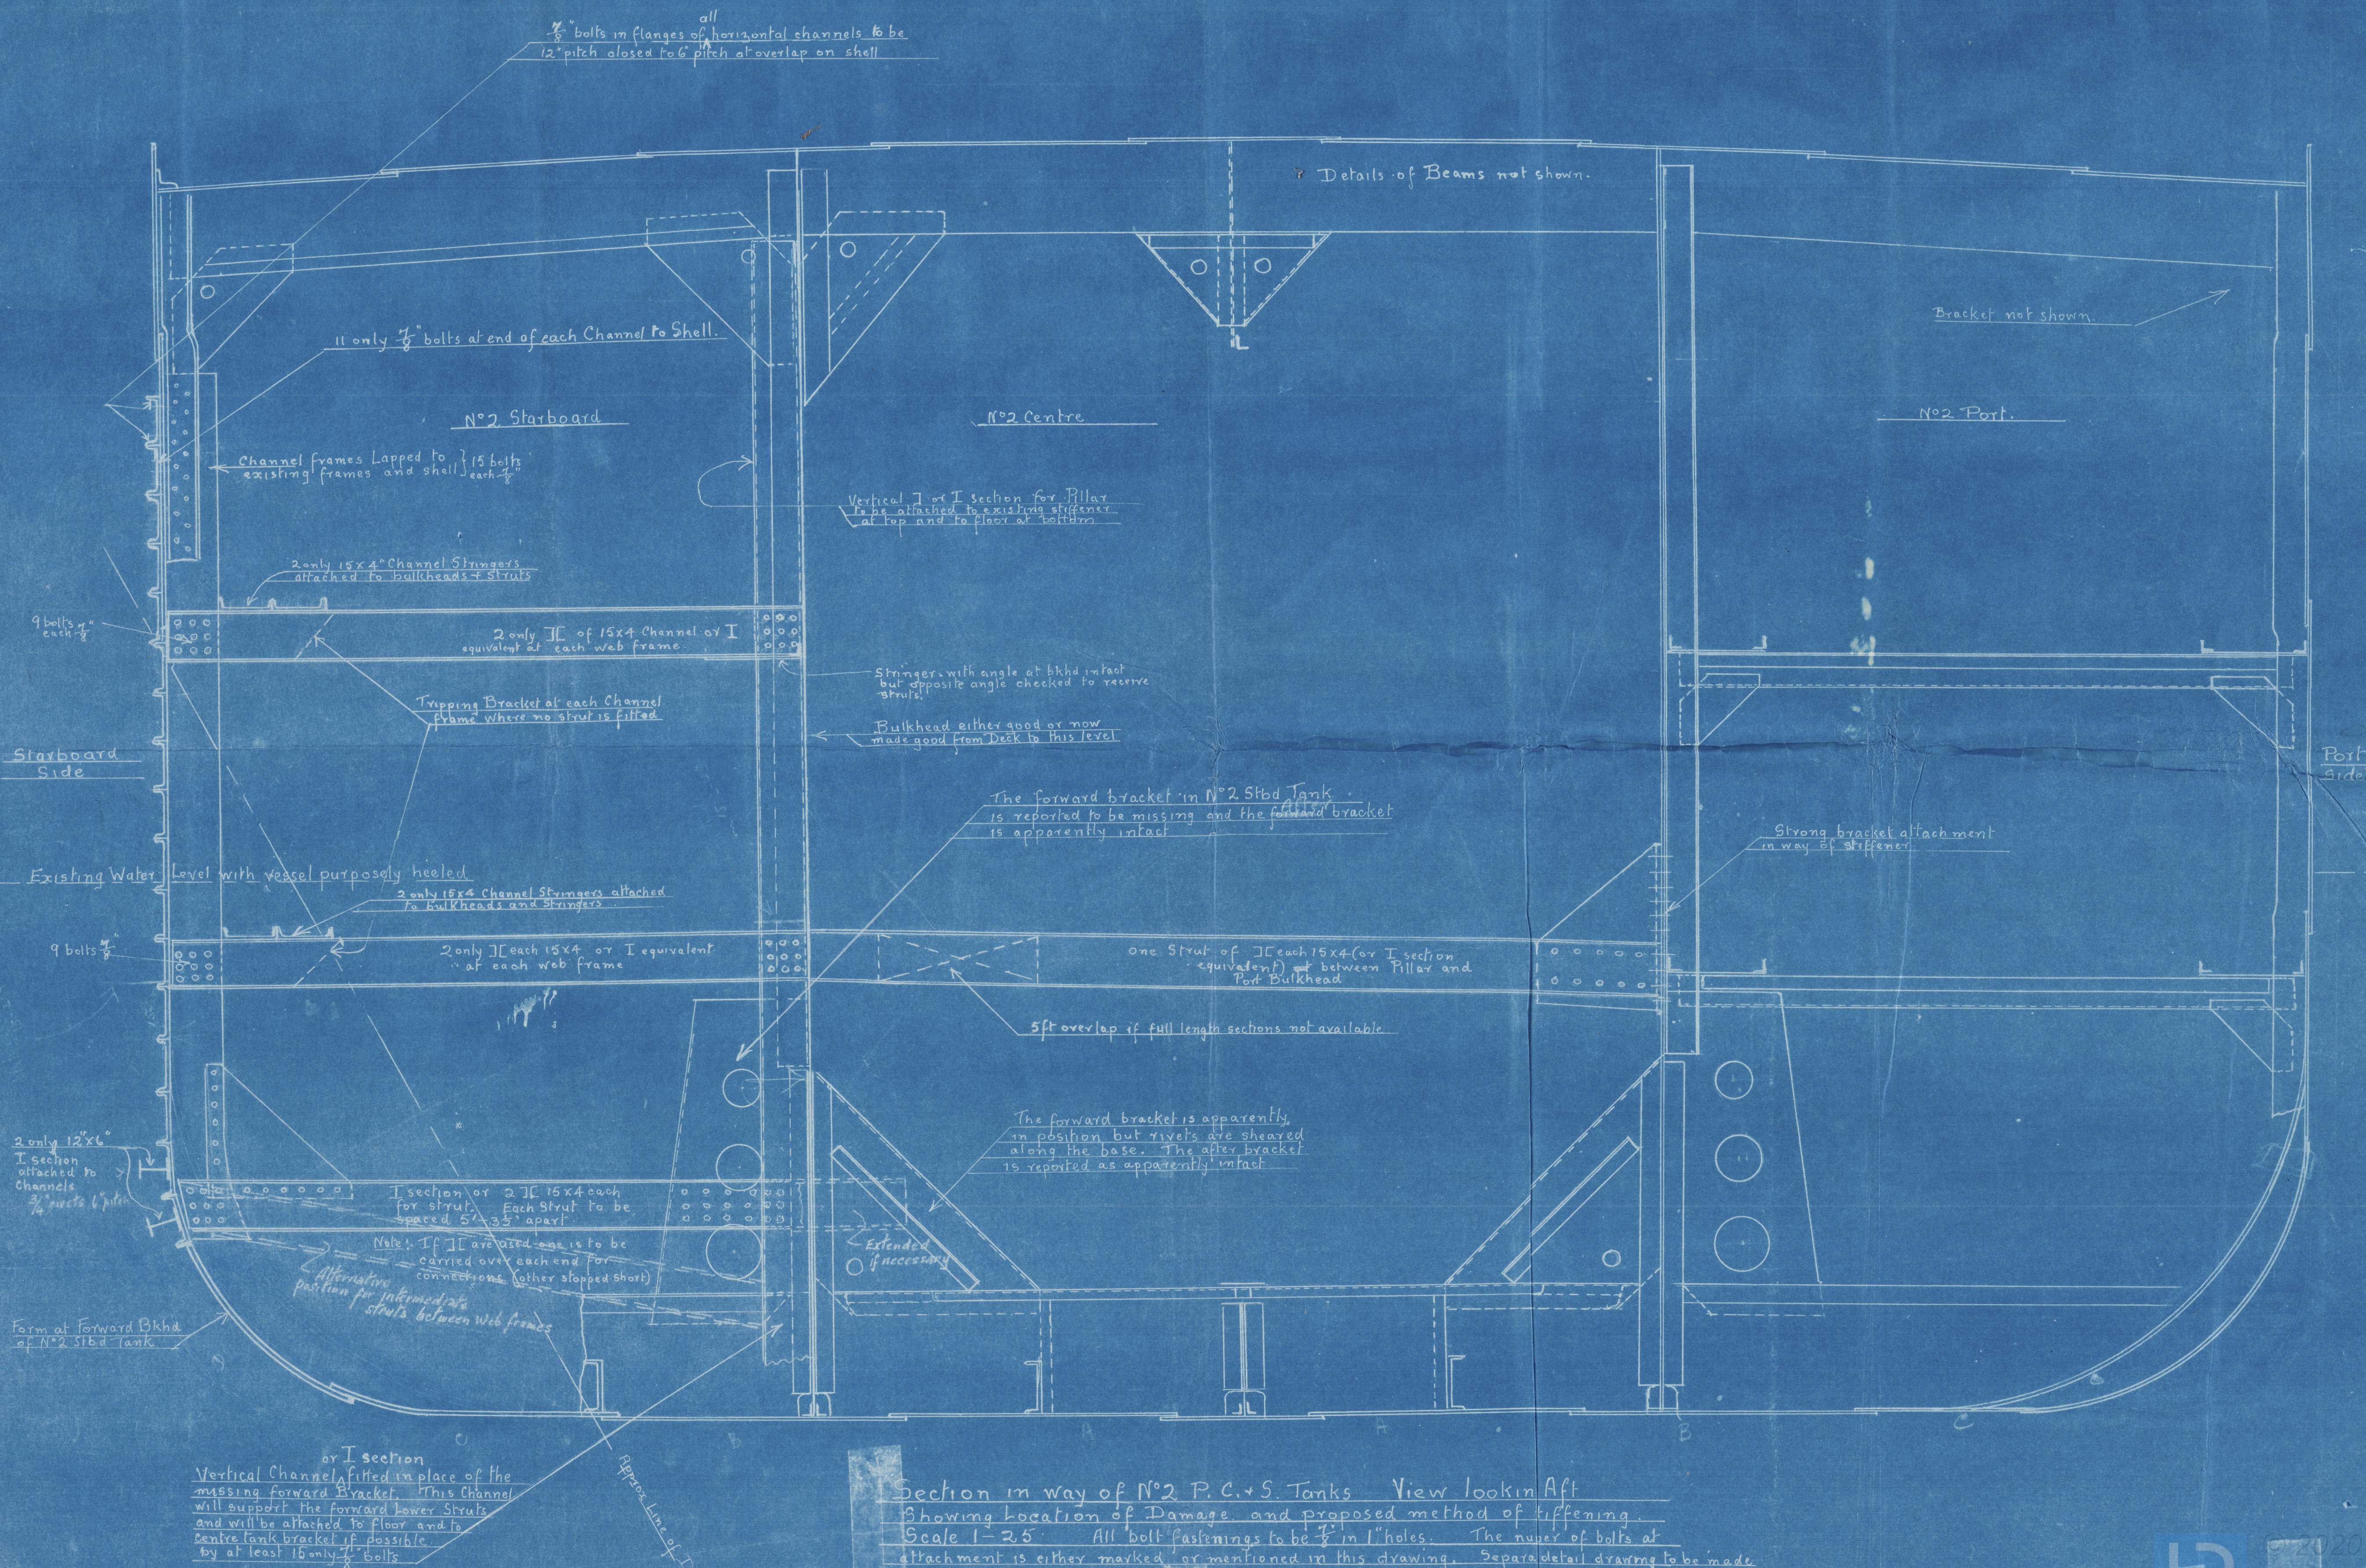

003631-003639-0135



TILLYS LIMITED,  
PLAN PRINTERS  
72, KY ST., PERTH

"Ondina"  
Fremantle Rts 1549-50

003631-003639-0135



© 2020

Lloyd's Register  
Foundation